

THIS INSTRUMENT PREPARED BY and RETURN TO:  
Armando J. Bucelo, Esq.  
1401 Ponce De Leon Blvd.  
Suite 401  
Coral Gables, Florida 33134

DECLARATION OF CONDOMINIUM  
OF  
CENTURY PARK CONDOMINIUM No.2, A CONDOMINIUM  
(Miami-Dade County, Florida)

CENTURY PARK AT FLAGLER, LTD. its successors and assigns (hereinafter called the "Developer"), does hereby declare as follows:

**1.0 SUBMISSION STATEMENT**

**1.1 Submission Statement:** The Developer as fee simple owner to the lands described in Exhibit "A" attached hereto hereby submits such lands to condominium ownership and hereby declares the same to be a Condominium pursuant to Chapter 718 of the Florida Statutes.

**1.2 Name:** The name by which this Condominium is to be identified is CENTURY PARK CONDOMINIUM No.2, A CONDOMINIUM, (hereinafter called the "Condominium").

**2.0 DEFINITIONS**

The following terms when used in this Declaration and its exhibits, and as they may hereafter be amended, shall have the meanings stated as follows, except where the context requires otherwise:

**2.1 "Act"** means the Florida Condominium Act (Chapter 718, Florida Statutes), as amended from time to time.

**2.2 "Articles" or "Articles of Incorporation"** means the Articles of Incorporation of the Association, as same may be amended from time to time.

**2.3 "Assessment"** means a share of the funds required for payment of Common Expenses, which from time to time is charged to the Unit Owner(s).

**2.4 "Assigns"** means any person to whom some or all rights of a Unit Owner have been validly transferred by sale, lease, mortgage or otherwise.

099B  
937.50  
20000

2.5 "Association" or "Condominium Association" means CENTURY PARK CONDOMINIUM No.2 ASSOCIATION, INC., a not-for-profit Florida corporation, which is the entity responsible for the operation of the Condominium.

2.6 "Association Property" means that property, real or personal, the title or ownership of which is vested in the Association for the use and benefit of its Members.

2.7 "Board of Administration" or "Board" or "Directors" means the board of directors responsible for administration of the Association.

2.8 "Building" means the structure situated on the Condominium Property in which the Units and the Common Elements and Limited Common Elements are located.

2.9 "Buyer" or "Unit Buyer" means a Person buying a Unit in fee simple.

2.10 "By-Laws" means the by-laws of the Association, as they exist from time to time.

2.11 "Common Elements" means the portions of the Condominium Property which are not included in the Units, and includes without limitation the following:

- (a) Easements through Units for conduits, pipes, ducts, vents, plumbing, wiring and other facilities, equipment and/or fixtures for the furnishing of Utility Services and/or heating, cooling, ventilation, or other services to more than one (1) Unit or to the Common Elements, together with related property and installations;
- (b) Easement of support in every portion of a Unit which contributes to the support of a building, other Units and/or any part of the Common Elements;
- (c) The property and installations required for the furnishing of utilities and other services to more than one Unit or to the Common Elements;
- (d) Any other parts of the Condominium Property designated as Common Elements in this Declaration or the Act.

2.12 "Common Expenses" means all expenses and assessments incurred by the Association for the Condominium, including without limitation:

- (a) Expenses of operation, maintenance, repair or replacement of Common Elements and Association Property;
- (b) Costs of carrying out the powers and duties of the Association;
- (c) Costs and expenses of capital improvements and betterments, and additions, or both, to the Common Elements and to the Association Property;
- (d) Any other expenses designated as common expenses by the Condominium Act, this Declaration or the By-Laws;
- (e) Expenses of administration and management of Condominium Property;
- (f) Any valid charge against the Condominium as a whole;
- (g) Expenses for the maintenance, repair or replacement of those portions of Units, if any, to be maintained by the Association;
- (h) Expenses for the maintenance, repair or replacement of the paving and drainage systems to be maintained by the Association.

Common Expenses also include all reserves required by the Act or otherwise established by the Association, regardless of when the reserve funds are expended, reasonable transportation services, insurance for directors and officers, in-house communications, security services, and pest control services to the Units and Common Elements, which are reasonably related to the general benefit of the Unit Owners even if such expenses do not attach to the Common Elements or Property of the Condominium, and the cost of a master antenna television system or duly franchised cable television service obtained pursuant to a bulk contract, but shall not include any other separate obligations of individual Unit Owners.

2.13 "Common Interest" means the proportionate undivided interest in fee simple in the Common Elements and the Common Surplus appurtenant to a Unit as expressed in the Declaration.

2.14 "Common Receipts" means the following items collected by the Association on behalf of the Condominium:

- (a) Rent and other charges derived from leasing or licensing the use of the Common Elements or Condominium Property;
- (b) Funds collected from Unit Owners for payment of Common Expenses or otherwise; and
- (c) Receipts designated as common by law, this Declaration or the By-laws.

2.15 "Common Surplus" means the excess of all Common Receipts over Common Expenses.

2.16 "Community" means the neighborhood which comprises the Condominium Property.

2.17 "Condominium" means CENTURY PARK CONDOMINIUM No.2, A CONDOMINIUM, which is a form of ownership of real property created pursuant to the Act and under this Declaration providing for ownership by one or more persons or entities of improvements together with an undivided interest in Common Elements appurtenant to each such Unit.

2.18 "Condominium Parcel" means a part of the Condominium Property subject to exclusive ownership, together with the undivided share in the Common Elements which is appurtenant to such parcel.

2.19 "Condominium Property" means the land and personal property that are subject to Condominium ownership under this Declaration, all improvements on the land, and all easements and rights appurtenant thereto which are intended for use in connection with the Condominium.

2.20 "Declaration" or "Declaration of Condominium" means this instrument, as may be amended or supplemented from time to time.

2.21 "Developer" means CENTURY PARK AT FLAGLER, LTD. its successors and assigns who shall create or offer for sale or lease, Condominium Parcels in the Condominium in the ordinary course of business, but expressly excluding all Owners and lessees acquiring Units for their own or their families own occupancy.

2.22 "Institutional First Mortgage" means an Institutional Lender's first mortgage on a Unit.

2.23 "Institutional Lender" means a bank, savings and loan Association, insurance company, real estate or mortgage investment trust, pension fund, agency of the United States Government, mortgage banker, any subsidiary or affiliate of Developer, the

Developer, or any other generally recognized institutional-type lender or its loan correspondent, or any lender providing funds to the Developer for purpose of making any improvements on the Condominium Property or any other lender approved by the Association pursuant to the provisions contained in this Declaration which holds a mortgage on a Unit.

2.24 "Insurance Trustee" means a Person appointed by the Board to administer insurance and/or condemnation proceeds.

2.25 "Limited Common Elements" means those Common Elements which are for the use of one or more specified Units to the exclusion of other Units as specified in this Declaration.

2.26 "Member of the Association" means the owner or co-owner of a Unit.

2.27 "Owner" means a Unit Owner.

2.28 "Person" means an individual, firm, corporation, partnership, Association, trust or other legal entity, or any combination thereof.

2.29 "Residences" means Units in the Condominium.

2.30 "Rules and Regulations" means guidelines adopted by the Association concerning the use of the Condominium, as they may be amended from time to time.

2.31 "Special Assessment" means any assessment levied against any Unit Owner(s) other than the assessments provided for in the annual budget.

2.32 "Unit" means a Condominium Parcel.

2.33 "Unit Deed" or "Warranty Deed" means a deed of conveyance of a Unit in recordable form.

2.34 "Unit Owner" means the person(s) owning a Unit in fee simple.

2.35 "Utility Services" means, but shall not be limited to, cable television, electric power, garbage and sewage disposal, water, pest control service (pertaining to both Units and Common Elements) and all other public service and convenience facilities.

2.36 "Voting Certificate" means a document which designates one of the record title owners or the corporate partnership or entity representative who is authorized to vote on behalf of a Unit owned by more than one owner or by any entity.

2.37 "Voting Interest" means the voting rights distributed to the Members of the Association pursuant to this Declaration.

### 3.0 DESCRIPTION OF CONDOMINIUM

#### 3.1 Survey, Graphic Description and Plot Plan:

- (a) Survey: A survey of the Condominium Property which shows all existing easements and a graphic description of the Condominium Buildings in which Units are located and a plot plan thereof that, together with this Declaration, are in sufficient detail to identify the Common Elements and each Unit and their relative locations and approximate dimensions, is attached hereto and by reference made a part hereof, as Exhibit B.

- (b) Floor Plans: The floor plans for the Units are attached hereto as a part of Exhibit B.

**3.2 Description of Building and Units:** The Condominium shall consist of ten (10) three-story buildings and thirteen (13) two story buildings containing a total of three hundred seventy-three (373) residential Units. The Buildings and Units are more particularly shown and described in the floor plans which are attached hereto as part of Exhibit B.

**3.3 Description of Other Improvements:** In addition to the previously described residential buildings and previously defined Common Elements, the Condominium Property may include walkways, the pool area, sodded areas, and landscaped areas.

- (a) Recreational Area: The following recreational facilities ("Recreational Facilities") will form a part of the Common Elements of the Condominium and are to be used both by the Unit Owners (including the Developer) and the owners of units in Century Park Condominium, as well as the tenants, invitees and guests of the foregoing parties.

Facility	Approximate Size of Floor Area	Approximate Capacity	Minimum Amount of Personal Property to be acquired by Developer	Pool Depth and whether heated
Recreational Building	4,500 s.f.	160	N/A	N/A
Pool	1,960 s.f.	130	N/A	3' to 6' No Heater
Pool Deck	3,700 s.f.	130	N/A	N/A

The above facilities will be available for use by the unit owners of the subject Condominium and Century Park Condominium immediately upon closing of their respective units, except as provided to the contrary in their executed Purchase Agreements. All locations, areas, capacities, numbers and sizes, as set forth above, are approximations. No additional facilities are provided or are planned to be provided at a later date by Developer for this Condominium.

- (b) Usage Fee: The Century Park Condominium Association will pay a fee to the association of the subject Condominium for use of the Recreational Facilities by its members. In return the Century Park Condominium unit owners will have a right to use the Recreational Facilities, but only so long as the fee is paid. In the event the fee ceases to be paid, the Century Park Condominium's license to use the Recreational Facilities shall be terminated. No easement or easement rights shall be deemed to exist with respect to the use of the Recreational Facilities by Century Park Condominium members.

**3.4 Unit Boundaries:** Each Unit shall include that area within a building having boundaries as follows:

- (a) Upper and Lower Boundaries: The upper and lower boundaries of the Unit shall be the following boundaries extended to an intersection with the perimetrical boundaries:

- (i) **Upper Boundaries:** The horizontal plane established by the highest point of the unfinished ceiling.
- (ii) **Lower Boundaries:** The horizontal plane established by the lowest point of the unfinished floor.
- (b) **Perimetrical Boundaries:** The perimetrical boundaries of the Unit shall be the vertical planes established by the unfinished interior of the walls, doors, windows, and other apertures bounding the Unit extending to the intersections with each other and with the upper and lower boundaries.

**3.5 Description of Appurtenances:** Each Unit shall be deemed to include the following items within its boundaries:

- (a) All interior walls and partitions which are not load-bearing;
- (b) The inner decorated or finished surfaces of all walls, floors and ceilings including plaster, gypsum board, ceramic tile, marble, paint, wallpaper, floor covering;
- (c) All appliances and built-in features;
- (d) Air-conditioning and heating systems;
- (e) Plumbing system;
- (f) All utility meters not owned by the public utility or agency supplying service; and
- (g) All electrical wires and fixtures.

No Unit shall be deemed to include any pipes, wires, conduits, security systems, lines, television cables, or other utility lines running through such Unit which are utilized for more than one Unit, the same being deemed Common Elements.

**3.6 Limited Common Elements**

- (a) **Designated by Survey:** Limited Common Elements include those portions of the Condominium Property which are designated as Limited Common Elements on the survey of the Condominium Property. A copy of the survey of the Condominium Property is attached hereto as Exhibit B. The Unit Owner whose Unit abuts said designated Limited Common Elements shall have the exclusive right to use same, except for the parking spaces as to which exclusive use of rights shall be assigned to specific units.
- (b) **Windows, Screens and Doors:** Limited Common Elements include all windows, screens and doors not otherwise located within the Unit being serviced thereby.
- (c) **Decks, and Balconies:** Limited Common Elements include those decks and balconies which have been designated as Limited Common Elements appurtenant to a particular Unit on the survey attached hereto as Exhibit B. The Unit Owner's exclusive right to use the deck and balcony associated with the Unit shall relate only to that section of the deck and balcony to which the Unit Owner has unimpeded access from his Unit. Except for one (1) tasteful American flag, no goods, materials, awnings, fixtures, paraphernalia or the like are to be affixed, placed or stored on said decks or balconies except with the Board's prior approval.

- (d) **Parking:** The Developer in its sole and absolute discretion reserves the right to assign a limited number of parking spaces as limited common elements to Buyers at the time of unit closings. Thereafter, any remaining parking spaces may be assigned or sold by the Developer in its sole and absolute discretion.
- (e) **Storage Spaces.** The Developer reserves the right to designate, assign and sell all storage spaces situated on the Condominium Property, as Limited Common Elements for the exclusive use by Unit owners of specified Units as long as it holds any Unit for sale in the ordinary course of business. After assignment, each storage space shall pass as Limited Common Elements of the Unit. No Unit Owner shall have or acquire any fee simple title to the storage space at any time except as part of the Unit Owner's undivided share in the Common Elements. All such assignments of storage spaces shall be made by a non-recordable instrument in writing ("Storage Space Assignment"). The Association shall maintain a book (the "Association Book") for purposes of recording the assignee of each storage space. The Developer will cause the Association to record such storage space Assignment in the Association Book and the Unit Owner to which such use is assigned shall have the exclusive right to use thereof. No assignment or transfer of title in any manner whatsoever to use a storage space constituting Limited Common Elements may be made or accomplished separately from the passing of title to the Unit to which it is appurtenant. After a storage space has been assigned by a Developer to a particular Unit, said storage space shall remain as a Limited Common Element appurtenant to that Unit and may not be separately assigned except as part of the Unit which is being transferred or conveyed. There shall be no recordation amongst the Public Records of Miami-Dade County of the transfer of a storage space.
- (f) **Miscellaneous Areas, Equipment.** Any area upon which is located equipment or fixtures (including air conditioning compressors) which are for the exclusive use of any particular Unit or Units and the equipment or fixtures themselves shall be Limited Common Elements of such Unit(s).

**3.7 Combination of Units:** No amendment may change the configuration or size of any Condominium Unit in any material fashion, materially alter or modify the appurtenances to the Unit, or change the proportion or percentage by which the owner of the parcel shares the Common Expenses and owns the Common Surplus, unless the record owner of the Unit and all record owners of liens on it join in the execution of the amendment and unless a majority of the record owners of all other units approve the amendment. The acquisition of property by the Association and material alterations or substantial additions to such property or the common elements by the Association in accordance with F.S. 718.111(7) or F.S. 718.113 shall not be deemed to constitute a material alteration or modification of the appurtenances to the Units.

**3.8 Percentage of Ownership.** The basis for allocating the undivided share, proportion or percentage of ownership of Units in the Condominium shall be according to the following formula: each Unit's undivided share, proportion or percentage of ownership in the Common Elements of the Condominium and each Unit's corresponding manner of sharing Common Expenses and owning Common Surplus shall be computed and determined based upon the number of all Units in the Condominium such that the numerator of the fractional ownership interest is one (1) and the denominator is the total number of Units in the Condominium so that the percentage attributable to all Units equals one hundred percent (100%) at all times.

#### **4.0 OWNERSHIP OF UNITS AND COMMON ELEMENTS; VOTING RIGHTS**

**4.1 Fee Simple:** Each Unit shall be conveyed as individual property in fee simple ownership. Included in fee title to each Unit shall be an undivided interest in the Common

Elements and in the Common Surplus. Each Unit shall have an equal share of ownership and obligation.

**4.2 Ownership and Conveyance of Undivided Interest in the Common Elements and in the Common Surplus:** The undivided interest of each Unit in the Common Elements and in the Common Surplus is deemed to be conveyed or encumbered with its respective Unit, even though the description in the instrument of conveyance or encumbrance may refer only to the fee title to the Unit.

**4.3 Change of Undivided Interest:** The undivided interest appurtenant to each Unit shall not be changed except with the unanimous consent of the Unit Owners and Institutional Lenders.

**4.4 Voting rights of Unit Owners:** On all matters on which the Unit Owners shall be entitled to vote, there shall be only one (1) voting interest (or vote) for each Unit in the Condominium, which vote may be cast by the owner of each Unit or the person designated in the Voting Certificate for the Unit. Should any person own more than one Unit, such person shall be entitled to cast one (1) vote for each Unit owned.

**4.5 Distribution of Common Surplus:** The Common Surplus shall be held and distributed by the Association in the manner and subject to the terms, provisions and conditions thereof. Except for distribution of any insurance indemnity herein provided or termination of the Condominium, any distribution of Common Surplus which may be made from time to time shall be made to the then Unit Owners in accordance with their respective Common Interests.

## **5.0 UTILIZATION; RESTRICTIONS**

**5.1 Residential Purposes.** All Units shall be used for single-family residential purposes only, subject to the applicable zoning laws and restrictions of Miami-Dade County and/or any other appropriate governmental agency.

**5.2 Ownership by Individuals:** Where title to a Unit shall be held in the name of an individual (with or without spouse) jointly with another individual (with or without spouse), the Unit Owners shall, by certificate to the Secretary of the Association, designate one (1) family as the occupants entitled to use the Unit.

**5.3 Ownership by Corporations or Other Business Entities:** Whenever any Unit is owned by a corporation or other business entity (hereinafter generically referred to as "corporation" or "corporate member"), such corporation shall permit use thereof only by its principal officers, directors or other guests; provided, however, that such corporation shall deliver to the Association a written statement designating the name of the person(s) entitled to use such Unit together with a written covenant by such person(s) to the Association, agreeing to comply with the provisions of this Declaration, the By-laws and the Rules and Regulations, and acknowledging that the right of such person(s) to use such Unit shall exist only so long as the corporation shall continue to be a Member of the Association. Upon demand by the Association to any corporate member to remove any person(s) using such corporation's Unit for failure of such user to comply with the provisions of this Declaration, the By-laws and/or the Rules and Regulations or for any other reason, the corporate member shall forthwith cause such user to be removed; failing which, the Association, as agent of the corporate member, may take such action as it may deem appropriate to accomplish such removal. All such action by the Association shall be at the cost and expense of such corporation which shall reimburse the Association therefor upon demand, together with any attorneys' fees the Association may have incurred for such removal. Anything stated herein to the contrary notwithstanding, the provisions of this Section do not apply to Developer.

**5.4 Children:** Children shall be allowed to occupy a Unit as permanent residents.

5.5 Temporary Gratuitous Guests: A Unit Owner who shall desire to allow a temporary gratuitous guest to reside within his Unit during periods of time wherein the Unit Owner shall not be present shall furnish to the Secretary of the Association, advance written notice of said guest, said notice to include the name(s) of the guests and their arrival and departure dates.

5.6 Pets: The keeping of pets may be authorized by the Board of Directors as a conditional license and not a right, subject to the rules and regulations adopted by the Association with respect to same, revocable upon a finding by the Association that such pet is an unreasonable source of annoyance or danger to others. Consistent with the foregoing, no animals or pets of any kind shall be kept in any Unit or any part of the Condominium Property, except for those animals or pets as may be authorized with the Board's prior written consent.

5.7 Leasing: Units may only be leased in accordance with the By-laws and Rules and Regulations of the Association and/or this Declaration.

5.8 General Restrictions: The Units and the Common Elements (including Limited Common Elements) shall be subject to the restrictions, easements, conditions and covenants prescribed and established in this Declaration, the By-Laws and the Rules and Regulations, governing the use of the Units and Common Elements and setting forth the obligations and responsibilities incident to ownership of each Unit. The Units and the Common Elements further shall be subject to all laws, zoning ordinances and regulations of governmental authorities having jurisdiction over the Condominium.

5.9 Prohibited Uses: No immoral, improper, offensive or unlawful use shall be made of any Unit or of the Common Elements, or any part thereof. No Unit Owner shall permit or suffer anything to be done or kept in his Unit or the Common Elements which would: (1) increase the rate of insurance on the Condominium; (2) obstruct or interfere with the rights of other occupants of the Condominium; (3) annoy other occupants by unreasonable noises or otherwise create a nuisance; (4) interfere with the peaceful possession and proper use of any other Unit or of the Common Elements; or (5) violate any governmental law, ordinance or regulation. Except for one (1) tasteful American flag, no item of any kind shall be affixed or attached to or permanently placed on the Common Elements (including Limited Common Elements) without the prior written consent of the Board.

5.10 Prohibition of Subdivision of Units: No Unit shall be subdivided or broken into smaller parts than as shown in Exhibit B.

5.11 Time-Share Estates: No time-share estates shall be created with respect to any Unit.

5.12 Prohibition of Separation of Common Elements, Common Interests or Easements from Unit: Any attempt to separate the fee title to a Unit from the undivided interest in the Common Elements and/or in the Common Surplus appurtenant to such Unit or from the easements appurtenant to such Unit shall be null and void. No Unit Owner may assign, hypothecate or transfer in any manner his share in the funds and assets of the Association as an appurtenance to his Unit.

5.13 Window Coverings: No Unit Owner shall install or affix any curtains, drapes, film or any other type window covering without first obtaining the written approval of the Association.

5.14 Signs: No "For Sale" or "For Rent" signs or other displays for advertising shall be maintained on the Condominium Property, except that Developer specifically reserves the right to place and maintain "For Sale" or "For Rent" signs in connection with any unsold or unoccupied Unit it may from time to time own.

5.15 Zoning Restrictions: Notwithstanding anything contained herein to the contrary, the provisions of this Declaration are subject to all building and zoning ordinances

applicable to the Condominium Property. Reconstruction, repair, or improvements of Units may be limited to or by applicable zoning laws which apply, will apply, or have applied to the Condominium Property.

**5.16 Interference with Developer:** Until Developer shall have closed the sale of all Units in the Condominium, neither the Unit Owners nor the Association shall interfere with the sale of the Units. Developer may make any use of the Condominium Property as may facilitate such sale including, but not limited to, maintenance of a sales office, showing of the property and the display of signs.

## 6.0 EASEMENTS

**6.1 Easement in Common Elements:** Except for those portions which are reserved for exclusive use as Limited Common Elements, the Common Elements shall be subject to a non-exclusive easement in favor of each Unit Owner for his use and the use of his immediate family, guests and invitees for all proper and normal purposes, including the furnishing of services and facilities. Such easement shall run with each Unit. A non-exclusive easement shall exist for ingress and egress over, through and across streets, common parking areas and walkways for the purpose of going from one portion of the Condominium Property to another. Nothing contained herein shall be construed to allow any person or entity to enter upon the Condominium Property unless it is upon an area specifically designated for such traffic and necessary for such ingress and egress as described above. Under no circumstances shall such traffic be allowed through any Unit.

**6.2 Utility Services; Drainage; Maintenance:** Easements are reserved under, through and over the Condominium Property as may be required for utility services and drainage serving the Condominium. The Association has the irrevocable right of access to each Unit and Limited Common Elements appurtenant thereto during reasonable hours when necessary for the maintenance, repair or replacement of any of the Common Elements including Limited Common Elements or of any portion of a Unit to be maintained by the Association pursuant to the Declaration, or as necessary, to prevent damage to the Common Elements including Limited Common Elements or to a Unit or Units. The Association shall have the following rights, provided that such rights shall not prevent or unreasonably interfere with use of the Units for proper purposes: (a) to establish, grant or create additional electric, gas, water, sewer, telephone, burglar alarm, drainage, cable television, master antenna and/or other utility easements; (b) to relocate any access easements concerning such utility easements; (c) to install, maintain and inspect lines and appurtenances for public or private water, sewer, telephone, burglar alarm, drainage, cable television, master antenna and/or other utility services; (d) to tap into or connect with and make use of wires, pipes, conduits, flues, ducts, television cables, master antenna, sewers, burglar alarm lines, water lines, drainage lines and/or other utility lines located in the Condominium Property; and (e) to dedicate any or all of such utility easements to any governmental body, public benefit corporation or utility company if the Association shall deem it necessary or desirable for the proper operation and maintenance of the Condominium Property or any portion thereof, or for the general health or welfare of any Unit Owner, or in connection with the development of the Condominium Property, provided that such additional utilities or the relocation of existing utilities will not prevent or unreasonably interfere with the proper use of any Unit. No Unit Owner shall commit or allow to be committed any act within or without his Unit or in any of the Common Elements (including Limited Common Elements) which would interfere with or impair any of the utility services using the easements granted herein.

**6.3 Encroachment Easements:** In the event that any Unit shall encroach upon any portion of the Common Elements for any reason not caused by the purposeful or negligent act of the Unit Owner(s) or agent(s) of such owner(s), then an easement appurtenant to such Unit shall exist for the continuance of such encroachment for so long as such encroachment naturally shall exist. In the event that any portion of the Common Elements shall encroach upon any Unit, then an easement appurtenant to the Common Elements shall exist for the continuance of such encroachment for so long as such encroachment naturally shall exist.

**6.4 Traffic:** An easement shall exist for pedestrian traffic over, through and across sidewalks, paths, walks, halls, lobbies and other portions of the Common Elements as may be from time to time intended and designated for such purpose and use; and for vehicular and pedestrian traffic over, through and across such portions of the Common Elements as may from time to time be paved or otherwise intended for purposes of ingress, egress and access to the public ways and for such other purposes as are commensurate with need; provided, however, nothing herein shall be construed to give or create in any person the right to park upon any portion of the Condominium Property except to the extent that space may be specifically designated and assigned for parking purposes.

**6.5 Developer's Reservation:** Developer reserves (for itself, its assignees and/or its designees) easements, rights and licenses in, through, over, under and across the Common Elements for the following purposes: (a) to complete work in Units and sale of Units and facilities in the Condominium Property; (b) to repair, replace and maintain the Condominium Property where the Association shall have failed in performing its duties for same; and (c) to erect, maintain, repair and replace, from time to time, signs on the Condominium Property advertising the sale and/or leasing of Units in the Condominium or in the vicinity of the Condominium Property.

**6.6 Employees' Easements:** Easements of ingress, egress, passage and entry for the Condominium Property are granted to employees of the Association, of Developer and of Developer's assignees and/or designees. Any utility company or public benefit corporation furnishing services to the Condominium Property or to other project(s) developed in the vicinity of the Condominium Property, and the employees and agents of any such company or corporation, shall have the right to access to all Units and the Common Elements, provided such rights shall be exercised in a manner not to unreasonably interfere with the use of any Unit or the Common Elements.

**6.7 Air Space Easements:** Each Unit Owner shall have an exclusive easement for the use of the airspace occupied by the Unit as it exists at any particular time and as the Unit may lawfully be altered or reconstructed from time to time, which easement shall be terminated automatically in any airspace which is vacated.

**6.8 Support:** Each Unit shall have an easement of support and of necessity and shall be subject to an easement of support and necessity in favor of all other units and the Common Elements.

**6.9 Additional Easements:** The Association, on its behalf and on behalf of all Unit Owners (each of whom hereby appoints the Association as its attorney-in fact for this purpose), shall have the right to grant such additional general ("blanket") and specific electric, gas or other utility, cable television, security systems, communications or service easements (and appropriate bills of sale for equipment, conduits, pipes, lines and similar installations pertaining thereto) or relocate any such existing easements or drainage facilities, in any portion of the Condominium Property, and to grant access easements or relocate any existing access easements in any portion of the Condominium Property, as the Association shall deem necessary or desirable for the proper operation and maintenance of the Improvements, or any portion thereof, or for the general health or welfare of the Unit Owners, or for the purpose of carrying out any provisions of this Declaration, provided that such easements or the relocation of existing easements will not prevent or unreasonably interfere with the reasonable use of the Units for dwelling purposes.

## **7.0 CONDOMINIUM ASSOCIATION; MEMBERSHIP; REPRESENTATION**

**7.1 Incorporation; Operation:** Developer shall create a Condominium Association to be known as CENTURY PARK CONDOMINIUM No.2 ASSOCIATION, INC., which shall be a not-for-profit Florida corporation and which shall operate the Condominium and undertake and perform all acts and duties incident thereto in accordance with the terms of the Articles of Incorporation and By-laws (copies of which are annexed hereto as Exhibits C and D, respectively), the Declaration and the Act. In the event of conflict concerning the

powers and duties of the Association as set forth in the Act, the Declaration, Articles of Incorporation and By-laws, the Act shall control the Declaration, the Declaration shall control the Articles of Incorporation and By-laws and the Articles of Incorporation shall control the By-laws.

**7.2 Automatic Membership:** Every Unit Owner automatically shall be a Member of the Association upon becoming the owner of such Unit and shall remain a Member until his ownership shall cease for any reason, at which time his membership shall cease automatically. Other than as an incident to a transfer of title to a Unit, membership in the Association shall not be transferable and any attempted transfer shall be null and void. No person, firm or corporation holding any lien, mortgage or other encumbrance upon any Unit shall be entitled, by virtue of such lien, mortgage or other encumbrance, to membership in the Association, or to any of the rights or privileges of such membership.

**7.3 Limitation Upon Liability of Association:** Notwithstanding its duty to maintain and repair the Condominium Property, the Association shall not be liable to Unit Owners for injury or damage, other than the cost of maintenance and repair caused by latent conditions of the Condominium Property. Further, the Association shall not be liable for any such injury or damage caused by defects in design or workmanship or any other reason connected with any additions, alterations or improvements made by or on behalf of any Unit Owner(s).

**7.4 Developer's Representation on the Board and Voting Rights:** Developer shall have the right to elect Directors to the Board and to remove and replace any person(s) elected by it, as is set forth in the Articles of Incorporation and By-Laws. The Directors elected by Developer need not reside in the Condominium. No Director selected by Developer shall be required to disqualify himself for voting upon any contract or lease between Developer and the Association where Developer may have a pecuniary or other interest. Developer shall not be required to disqualify itself in any vote which may come before the membership of the Association upon any contract or lease between Developer and the Association where Developer may have a pecuniary or other interest. All rights in favor of Developer reserved in this Declaration, the Articles of Incorporation and the By-Laws are assignable to and may be exercised by Developer's successors and assigns. Further, the Association shall not be liable to any Unit Owner or lessee or to any other person or entity for any property damage, personal injury, death or other liability on the grounds that the Association did not obtain or maintain insurance (or carried insurance with any particular deductible amount) for any particular matter where (a) such insurance is not required hereby or (b) the Association could not obtain such insurance at reasonable costs or upon reasonable terms.

#### **7.5 Transfer of Association Control:**

(a) When Unit Owners other than the Developer own fifteen percent (15%) or more of the Units in the Condominium being operated by the Association, the Unit Owners other than the Developer shall be entitled to elect no less than one-third of the members of the Board of Administration of the Association. Unit owners other than the Developer are entitled to elect not less than a majority of the members of the Board of Administration of an Association upon the following:

- (i) Three (3) years after fifty percent (50%) of the Units which are operated by the Association have been conveyed to Buyers;
- (ii) Three (3) months after ninety percent (90%) of the Units being operated by the Association have been conveyed to Buyers;
- (iii) When all the Units being operated by the Association have been completed, some of them have been conveyed to Buyers, and none of the others are being offered for sale by the Developer in the ordinary course of business;

- (iv) When some of the units have been conveyed to Buyers and none of the others are being constructed or offered for sale by the Developer in the ordinary course of business; or
- (v) Seven (7) years after recordation of this Declaration; or, in the case of the Association operating more than one condominium, seven (7) years after recordation of the Declaration for the first condominium it operates; or, in the case of the Association operating a phase condominium created pursuant to Section 718.403, Florida Statutes, seven (7) years after recordation of the Declaration creating the initial phase, whichever occurs first. The Developer is entitled to elect at least one member of the Board of Administration of an Association as long as the Developer holds for sale in the ordinary course of business at least five (5) percent, in condominiums with fewer than five (500) units, and two percent (2%), in condominiums with more than five (500) units, of the units in a condominium operated by the Association. Following the time the Developer relinquishes control of the Association, the Developer may exercise the right to vote any developer-owned units in the same manner as any other unit owner except for purposes of reacquiring control of the Association or selecting the majority members of the Board of Administration.

(b) Within seventy-five (75) days after the Unit Owners other than the Developer are entitled to elect a member or members of the Board of Administration of the Association, the Association shall call, and give not less than sixty (60) days' notice of an election for the members of the Board of Administration. The election shall proceed as provided in Section 718.112(2)(d), Florida Statutes. The notice may be given by any Unit Owner if the Association fails to do so. Upon election of the first unit owner other than the Developer to the Board of Administration, the Developer shall forward to the Department of Business and Professional Regulation, The Northwood Center, 1940 North Monroe Street, Tallahassee, Florida 32399-1033, the name and mailing address of the unit owner board member.

(c) If a Developer holds units for sale in the ordinary course of business, none of the following actions may be taken without approval in writing by the Developer:

- (i) Assessment of the developer as a unit owner for capital improvements.
- (ii) Any action by the Association that would be detrimental to the sales of units by the Developer. However, an increase in Assessments for Common Expenses without discrimination against the Developer shall not be deemed to be detrimental to the sales of units.

(d) At the time that Unit Owners other than the Developer elect a majority of the members of the Board of Administration of an Association, the Developer shall relinquish control of the Association, and the Unit Owners shall accept control. Not more than 90 days thereafter, the Developer shall deliver to the Association, at the Developer's expense all property of the Unit Owners and of the Association which is held or controlled by the Developer, including, but not limited to, the following items, if applicable.

- (i) The original or a photocopy of the recorded Declaration of Condominium and all amendments thereto. If a photocopy is provided, it shall be certified by affidavit of the developer or an officer or agent of the Developer as being a complete copy of the actual recorded Declaration.
- (ii) A certified copy of the Articles of Incorporation of the Association.
- (iii) A copy of the By-laws.
- (iv) The minute books, including all minutes, and other books and records of the Association, if any.

20512PG1074

- (v) Any house rules and regulations which have been promulgated.
- (vi) Resignations of officers and members of the Board of Administration who are required to resign because the Developer is required to relinquish control of the Association.
- (vii) The financial records, including financial statements of the Association, and source documents from the incorporation of the Association through the date of turnover. The records shall be audited for the period from the incorporation of the Association or from the period covered by the last audit, if an audit has been performed for each fiscal year since incorporation, by an independent certified public accountant. All financial statements shall be prepared in accordance with generally accepted accounting principles and shall be audited in accordance with generally accepted auditing standards, as prescribed by the Florida Board of Accountancy, pursuant to Chapter 473, Florida Statutes. The accountant performing the audit shall examine to the extent necessary supporting documents and records, including the cash disbursements and related paid invoices to determine if expenditures were for Association purposes and the billings, cash receipts, and related records to determine that the Developer was charged and paid the proper amounts of assessments.
- (viii) Association funds or control thereof.
- (ix) All tangible personal property that is property of the Association which is represented by the Developer to be part of the Common Elements or which is ostensibly part of the Common Elements, and an inventory of that property.
- (x) A list of the names and addresses, of which the developer had knowledge at any time in the development of the condominium, of all contractors, subcontractors, and suppliers utilized in the construction or remodeling of the improvements and in the landscaping of the Condominium or Association property.
- (xi) Insurance policies.
- (xii) Copies of any certificates of occupancy which may have been issued for the condominium property.
- (xiii) Any other permits applicable to the condominium property which have been issued by governmental bodies and are in force or were issued within 1 year prior to the date the unit owners other than the developer take control of the Association.
- (xiv) All written warranties of the contractor, subcontractors, suppliers and manufacturers, if any that are still effective.
- (xv) A roster of unit owners and their addresses and telephone numbers, if known, as shown on the Developer's records.
- (xvi) Leases of the Common Elements and other leases to which the Association is a party.
- (xvii) Employment contracts or service contracts which the Association is one of the contracting parties or service contracts in which the Association or the Unit Owners have an obligation or responsibility, directly or indirectly, to pay some or all of the fee or charge of the person or persons performing the service.

(xviii) All other contracts to which the Association is a party.

**7.6 Emergency Entry:** In case of any emergency originating in or threatening any Unit, regardless of whether the Unit Owner is present at the time of such emergency, the Board or any other person authorized by it, or the management company or Developer or their employees shall have the immediate right to enter such Unit for the purpose of remediating or abating the cause of such emergency. To facilitate entry in the event of any such emergency, each Unit Owner, if required by the Association, shall deposit a key to such Unit with the Association. Neither the Developer, the Association nor the authorized person, as the case may be, shall have any liability from such entry.

## **8.0 ASSESSMENTS; LIABILITY; LIEN AND PRIORITY; INTEREST; COLLECTION**

### **8.1 Liability for Payment of Assessments:**

(a) A Unit Owner, regardless of how his title has been acquired, including by purchase at a foreclosure sale or by deed in lieu of foreclosure, is liable for all assessments which come due while he is the Unit Owner. Additionally, a unit owner is jointly and severally liable with the previous owner for all unpaid assessments that came up to the time of transfer of title. This liability is, without prejudice to any right the owner may have to recover from the previous owner the amounts paid by the owner.

(b) The liability of a first mortgagee or its successor or assignees who acquire title to a unit by foreclosure or by deed in lieu of foreclosure for the unpaid assessments that became due prior to the mortgagee's acquisition of title is limited to the lesser of:

(i) The unit's unpaid common expenses and regular periodic assessments which accrued or came due during the 6 months immediately preceding the acquisition of title and for which payment in full has not been received by the association; or

(ii) One percent of the original mortgage debt. The provisions of this paragraph shall not apply unless the first mortgagee joined the association as a defendant in the foreclosure action. Joinder of the association is not required if, on the date the complaint was filed, the association was dissolved or did not maintain an office or agent for service at a location which was known to or reasonably discoverable by the mortgagee.

(c) The person acquiring title shall pay the amount owed to the association within 30 days after transfer of title. Failure to pay the full amount when due shall entitle the association to record a claim of lien against the parcel and proceed in the same manner as provided in this section for the collection of unpaid assessments.

(d) The liability for assessments may not be avoided by waiver of the use or enjoyment of any Common Element or by abandonment of the unit for which the assessments are made.

(e) The provisions of this subsection are intended to clarify existing law, and shall not be available in any case where the unpaid assessments sought to be recovered by the association are secured by a lien recorded prior to the recording of the mortgage. Notwithstanding the provisions of chapter 48 of the Florida Statutes, the Association shall be a proper party to intervene in any foreclosure proceeding to seek equitable relief.

(f) Assessments and installments on them which are not paid when due bear interest at the annual rate of Eighteen Percent (18%), or at the highest rate of interest allowable by law, from the due date until paid. The Association may charge an administrative late fee in addition to such interest, in an amount not to exceed the greater of \$25 or five (5) percent of each installment of the assessment for each delinquent installment that the payment is late. Any payment received by an Association shall be applied first to any interest accrued by the Association, then to any administrative late fee, then to any costs and reasonable attorney's fees incurred in collection and then to the delinquent assessment. The foregoing shall be applicable notwithstanding any restrictive

endorsement, designation, or instruction placed on or accompanying a payment. A late fee shall not be subject to the provisions of Chapter 687 or Section 718.303(3), Florida Statutes.

(g) The Board shall have the power to fix, determine and collect from all Unit Owners, as provided in the By-Laws, the sums necessary and adequate to provide for the Common Expenses of the Condominium and such other expenses as are specifically provided for in this Declaration and the By-laws. All assessments shall be levied in proportion to each Unit Owner's Common Interest. Should the Association be the owner of any Unit(s), the assessment which otherwise would be due and payable to the Association on such Unit(s), shall be levied ratably among all of the Unit Owners excluding the Association, based upon their Common Interests, reduced by any income derived from the leasing of such Unit(s) by the Association.

(h) Inasmuch as the Association is authorized by the Declaration or By-laws to approve or disapprove a proposed lease of a unit, the grounds for disapproval may include, but are not limited to, a unit owner being delinquent in the payment of an assessment at the time approval is sought.

(i) No Unit Owner may be excused from the payment of his share of the Common Expenses of a Condominium unless all Unit Owners are likewise proportionately excused from payment. The Developer shall be excused from the payment of its share of the Common Expenses and Assessments relating to those Units owned by the Developer for a period to terminate no later than the first day of the fourth calendar month following the month in which the closing of the purchase and sale of the first Unit occurs; however, the Developer must pay the proportion of Common Expenses incurred during the period which exceeds the amount assessed against other Unit Owners. For the period commencing no later than the first day of the fourth calendar month following the month in which closing of the purchase and sale of the first Unit occurs (the expiration of the exemption period) the Developer guarantees until April 30, 2003 that the assessment for Common Expenses of the Condominium imposed upon each Unit will not increase above \$195.00 per Unit. Subsequent to said period the Developer may extend the guarantee period for one additional six (6) month period, at its option, pursuant to Florida Statute 718.116(9)(a)(2). The guarantee stated dollar amount shall be as set forth above.

(j) No funds which are received from Unit Buyers or Unit Owners at closing as capital contributions for the Association shall be used for payment of Common Expenses during the Developer's Assessment guaranty period.

**8.2 Special Assessments:** Should the assessments prove to be insufficient to pay the costs of operation of the Condominium, or should any emergency arise, the Board shall have the authority to levy such additional assessment(s) as it may deem necessary, subject to obtaining the Association membership's approval of such Special Assessment by majority vote at a duly called meeting of the Association at which a quorum is, present. The specific purpose or purposes of any special assessment approved in accordance with the condominium documents shall be set forth in a written notice of such assessment sent or delivered to each unit owner. The funds collected pursuant to a special assessment shall be used only for the specific purpose or purposes set forth in such notice. However, upon completion of such specific purpose or purposes, any excess funds will be considered common surplus, and may, at the discretion of the board, either be returned to the Unit Owners or applied as a credit toward future assessments. Anything herein to the contrary notwithstanding, so long as Developer owns at least two (2) Units in the Condominium, no Special Assessment for capital improvements shall be authorized without Developer's prior written approval.

**8.3 Certificate of Unpaid Assessments:** Within fifteen (15) days after receiving a written request from a Unit Owner Buyer, or mortgagee, the Association shall provide a certificate signed by an officer or agent of the association stating all assessments and other monies owed to the Association by the Unit Owner with respect to the Unit. Any person other than the Unit Owner who relies upon such certificate shall be protected

thereby. A summary proceeding pursuant to s. 51.011 may be brought to compel compliance with this subsection, and in any such action the prevailing party is entitled to recover reasonable attorney's fees.

**8.4 Default:** The Assessments levied against each Unit Owner shall be payable at the main office of the Association in such installments and at such time as may be determined by the Board of Administration and as provided in the By-laws. The payment of any such Assessment shall be in default if it is not paid to the Association on or before its due date.

**8.5 Claims of Lien:**

(a) The Association has a lien on each condominium parcel to secure the payment of assessments. Except as otherwise provided in Subsection 8.1 and as set forth below, the lien is effective from and shall relate back to the recording of the original declaration of condominium or in the case of lien on a parcel located in a phase condominium the recording of the original declaration or amendment thereto creating the parcel. However, as to first mortgages of record, the lien is effective from and after recording of a claim of lien in the Public Records of Miami-Dade County, Florida.

(b) To be valid, a claim of lien must state the description of the condominium parcel, the name of the record owner, the name and address of the association, the amount due, and the due dates. It must be executed and acknowledged by an officer or authorized agent of the association. No such lien shall be effective longer than one (1) year after the claim of lien was recorded unless, within that time, an action to enforce the lien is commenced. The 1 year period shall automatically be extended for any length of time during which the association is prevented from filing a foreclosure action by an automatic stay resulting in a bankruptcy petition filed by the parcel owner or any other person claiming an interest in the parcel. The claim of lien shall secure all unpaid assessments which are due and which may accrue subsequent to the recording of the claim of lien and prior to the entry of a certificate of title, as well as interest and all reasonable costs and attorney's fees incurred by the association incident to the collection process. Upon payment in full, the person making the payment is entitled to a satisfaction of the lien.

(c) The Association, acting through the Board, shall have the right to assign to Developer or to any Unit Owner(s) or third party its lien rights for the recovery of any unpaid assessments.

**8.6 Form of Notice of Contest of Lien: Recording etc.**

(a) By recording a notice in substantially the following form, a unit owner or his agent or attorney may require the Association to enforce a recorded claim of lien against his condominium parcel:

**NOTICE OF CONTEST OF LIEN**  
TO: CENTURY PARK CONDOMINIUM No.2 ASSOCIATION

YOU are notified that the undersigned contests the claim of lien filed by you on \_\_\_\_\_, and recorded in Official Records Book \_\_\_ at Page \_\_\_, of the public records of Miami-Dade County, Florida, and that the time within which you may file suit to enforce your lien is limited to ninety (90) days from the date of service of this notice.

Executed this \_\_\_\_\_ day of \_\_\_\_\_.

(Signature of Unit Owner or his Attorney)

(b) After notice of contest of lien has been recorded, the Clerk of the Circuit Court shall mail a copy of the recorded Notice to the association by certified mail, return receipt

requested, at the address shown in the claim of lien or most recent amendment to it and, shall certify to the service on the face of the notice. Service is complete upon mailing. After service, the Association has 90 days in which to file an action to enforce the lien; and, if the action is not filed within the 90-day period, the lien is void. However, the 90-day period shall be extended for any length of time that the association is prevented from filing its action because of an automatic stay resulting from the filing of a bankruptcy petition by the unit owner or by any other person claiming an interest in the parcel.

**8.7 Foreclosure of Lien/Assumption of Liability for Payment of Assessments:**

(a) The Association may bring an action in its name to foreclose a lien for assessments in the manner a mortgage of real property is foreclosed and may also bring an action to recover a money judgment for the unpaid assessments without waiving any claim of lien. The Association is entitled to recover its reasonable attorney's fees incurred in either a lien foreclosure action or an action to recover a money judgment for unpaid assessments.

(b) No foreclosure judgment may be entered until at least thirty (30) days after the Association gives written notice to the Unit Owner of its intention to foreclose its lien to collect the unpaid assessments. If this notice is not given at least thirty (30) days before the foreclosure action is filed and if the unpaid assessments, including those coming due after the claim of lien is recorded, are paid before the entry of a final judgment of foreclosure, the Association shall not recover attorney's fees or costs. The notice must be given by delivery of a copy of it to the Unit Owner or by certified or registered mail, return receipt requested, addressed to the Unit Owner at his last known address; and, upon such mailing, the notice shall be deemed to have been given, and the court shall proceed with the foreclosure action and may award attorney's fees and costs as permitted by law. The notice requirements herein are satisfied if the Unit Owner records a Notice of Contest of Lien as provided in Section 8.6 above. The notice requirements herein do not apply if an action to foreclose a mortgage on the Condominium Unit is pending before any court; if the rights of the Association would be affected by such foreclosure; and if actual, constructive, or substitute service of process has been made on the Unit Owner.

(c) If the Unit Owner remains in possession of the Unit after a foreclosure judgment has been entered, the court, in its discretion, may require the Unit Owner to pay a reasonable rental for the unit. If the unit is rented or leased during the pendency of the foreclosure action, the Association is entitled to the appointment of a receiver to collect the rent. The expenses of the receiver shall be paid by the party which does not prevail in the foreclosure action.

(d) If the Unit Owner remains in possession of the Unit and the claim of lien is foreclosed, the court, in its discretion, may also require the Unit Owner to pay taxes and prior encumbrances and interest thereon.

(e) The Association has the power to purchase the condominium parcel at the foreclosure sale and to hold, lease, mortgage, or convey it.

(f) A first mortgagee acquiring title to a condominium parcel as a result of foreclosure, or a deed in lieu of foreclosure, may not, during the period of its ownership of such parcel, whether or not such parcel is unoccupied, be excused from the payment of some or all of the Common Expenses coming due during the period of such ownership.

**9.0 BUDGET AND ACCOUNTING:**

**9.1 Budget:** The Board shall adopt a budget for each fiscal year. Such budget shall contain estimates of all costs and expenses for the proper operation, management and maintenance of the Condominium, and shall take into account the projected income which is to be applied in reduction of the amounts required to be collected as an assessment each year. Common Expenses also shall include the cost of maintaining leaseholds, memberships and other possessory or use interests in lands and facilities to provide

enjoyment, recreation or other use or benefit to Unit Owners, all as acquired by lease or agreement in form and content, satisfactory to the Board, including amounts which the Association may agree to pay to Developer for services or availability of service, including management. Assessments shall be established based upon such budget. Upon adoption of the budget, a copy of same shall be delivered to each Unit Owner, although failure to deliver a copy of the budget to each Unit Owner shall not affect the liability of any Unit Owner for such assessment. The Association shall maintain accounting records which shall be open to inspection by Unit Owners or their authorized representatives at reasonable times. Written summaries of such accounting records shall be furnished to Unit Owners or their representatives at least annually.

**9.2 Reserves:**

(a) **Reserves for Capital Expenditures and Deferred Maintenance:** Each annual budget shall include sums to be collected and maintained as reserves to be used for capital expenditures and deferred maintenance. These accounts shall include, but not be limited to, roof replacement, building painting, pavement resurfacing, and any other items for which the replacement cost is expected to exceed \$10,000.00. The amount to be reserved shall be computed by the Board by means of a formula based upon estimated remaining useful life and estimated replacement cost or deferred maintenance expense of each reserve item. However, prior to turnover of control of an association by the developer to unit owners other than the Developer pursuant to Florida Statutes section 718.301, the Developer may vote to waive the reserves or reduce the funding of reserves for the first two (2) fiscal years of the operation of the Association, after which time reserves may only be waived or reduced upon the vote of a majority of all non-Developer voting interests voting in person or by limited proxy at a duly called meeting of the Association. If such a meeting shall have been called and the necessary vote for waiver or reduction shall not have been attained or a quorum shall not have been obtained, the reserves as set forth in the budget shall go into effect in accordance with the By-laws.

(b) **General Operation Reserve:** Each annual budget may include a sum to be collected and maintained as a general operating reserve, which sum may be used to meet deficiencies from time to time existing as a result of delinquent payment of assessments by Unit Owners or as a result of emergencies or to pay other costs or expenses placing financial stress upon the Association. The amount to be allocated to such operating reserve and collected therefor shall not exceed ten percent (10%) of the current annual assessment levied against all of the Unit Owners. Upon accrual in the operating reserve of a sum equal to thirty percent (30%) of the current annual assessment, no further payments shall be collected, unless such operating reserve shall be reduced below the thirty percent (30%) level, in which event, contributions to such operating reserve shall be included in the annual assessment so as to restore the operating reserve to thirty percent (30%) of the current annual assessment.

**9.3 Collections:** All monies collected by the Association shall be treated as the separate property of the Association. Such monies may be applied by the Association to the payment of any expense of operating the Condominium, or to the proper undertaking of all acts and duties imposed upon it by virtue of this Declaration, the Articles of Incorporation and the By-Laws. Monies for any assessment paid to the Association by any Unit Owner may be commingled with monies paid to the Association by the other Unit Owners. Although all funds and the Common Surplus shall be held for the benefit of the Members of the Association, no Member shall have the right to assign, hypothecate, pledge or in any manner transfer his interest therein, except as an appurtenance to his Unit. When a Unit Owner shall cease to be a Member of the Association, the Association shall not be required to account to him for any share of the funds or assets of the Association, or for any sums which he may have paid to the Association.

**9.4 Unpaid Assessments: Leased Units:** If the Association is authorized by the Declaration or By-laws to approve or disapprove a proposed lease of a unit, the grounds for disapproval may include, but are not limited to, a unit owner being delinquent in the payment of an assessment at the time approval is sought. Assessments which are unpaid after the due date shall bear interest at the maximum rate of interest chargeable to an individual as permitted by the laws of the State of Florida. Once interest has accrued, any

subsequent payment shall be applied first to payment of interest and collection costs and then to the payment of the assessment first due.

#### **10.0 ALTERATIONS; MAINTENANCE; REPAIR:**

**10.1 Alterations by Unit Owners:** No Unit Owner shall make or cause to be made any structural alteration, addition or improvement to his Unit or any structural or non-structural alterations, additions or improvements to the Common Elements, including Limited Common Elements ("Alterations") without the Association's prior written consent. If the Alteration sought by the Unit Owner shall involve the removal of any permanent interior partition, the Association shall have the right to permit such removal so long as such partition shall not be load-bearing and its removal would not affect or interfere with the furnishing of utility or other services. The Board shall have the obligation to answer (i.e., approve, disapprove or request further information) any written request sent certified mail, return receipt requested, by a Unit Owner for approval of a proposed Alteration in such Unit Owner's Unit or appurtenant Limited Common Element(s) within thirty (30) days after such request is received. Such request shall include a brief description of the work to be performed, a copy of the plans, proof of appropriate insurance by the contractor or contractors or any person or entity performing work on the Unit, and copies of the appropriate licenses for the individuals performing the work. All Alterations by the Unit Owners shall be made in compliance with all applicable laws, rules and ordinances and regulations and this Declaration. A Unit Owner making or causing to be made any Alterations agrees, and shall be deemed to have agreed, to hold the Association and all other Unit Owners harmless from any liability arising therefrom.

**10.2 Alteration by the Association:** The Association shall have the right, with Board approval, to make or cause to be made alterations to the Common Elements costing in the aggregate not more than \$50,000 in a calendar year without the approval of the Unit Owners or institutional lenders. Alterations to the Common Elements costing in excess of \$50,000 for a calendar year shall require the prior approval of a majority of Unit Owners voting at a meeting at which a quorum is present. No alterations shall prejudice the rights of any Unit Owner in the use and enjoyment of his Unit. The cost of alterations shall be a Common Expense.

**10.3 Maintenance/Repairs by Unit Owners:** Each Unit Owner agrees to: (a) maintain in good condition and repair his Unit, except those portions to be maintained by the Association, including interior surfaces such as walls, ceilings and floors, and screens, windows and doors, and to replace such items, when necessary; and (b) maintain, repair and replace, if necessary, the fixtures and equipment within the Unit. The Association shall have the irrevocable right of access to each Unit during reasonable hours, when necessary for the maintenance, repair or replacement of any Common Elements or of any portion of a Unit to be maintained by the Association pursuant to the Declaration or as necessary to prevent damage to the Common Elements or to a Unit or Units. A Unit Owner shall be liable for the expense of any maintenance, repair or replacement to the Common Elements made necessary by his act or negligence or by that of any member of his family or his or their guests, invitees, employees, agents or lessees.

**10.4 Maintenance/Repairs by Association:** The Association shall be responsible for the maintenance, repair and replacement of all of the Common Elements including those portions which contribute to the support of the building, and all conduits, ducts, plumbing, wiring and other facilities for the furnishing of utility and other services. Should any incidental damage be caused to any Unit by virtue of any work which may be done or caused to be done by the Association in the maintenance, repair or replacement of any Common Elements, the Association, shall, at its expense, repair such incidental damage. The costs of such maintenance for repair and replacement on the Common Elements (including Limited Common Elements) shall be paid by the Association. Whenever it is necessary to enter any Unit for maintenance, alteration or repair to any portion of the Common Elements, each Unit Owner shall permit the Association's duly constituted and authorized agent to enter such Unit for such purpose, provided that such entry shall be made only at reasonable times and with reasonable notice.

**10.5 Units and Hurricane Shutter Installation and Repairs:** All maintenance, repairs and replacements of, in or to any Unit, whether structural or nonstructural, ordinary or

extraordinary, including, without limitation, maintenance, repair and replacement of hurricane screens and shutters, windows, the interior side of the entrance door and all other doors within or affording access to a Unit (except as provided in Subsection 6.2 hereof), and the electrical (including wiring), plumbing (including fixtures and connections), heating and air conditioning equipment, fixtures and outlets, appliances, carpets and other floor coverings, all interior surfaces and the entire interior of the Unit lying within the boundaries of the Unit or other property belonging to the Unit Owner, shall be performed by the Owner of such Unit at the Unit Owner's sole cost and expense, except as otherwise expressly provided to the contrary herein. The hurricane shutter and the Common Element to which said hurricane shutter is attached (collectively, the "Hurricane Limited Common Element") shall become a Limited Common Element to the Unit which is serviced by the hurricane shutter. The cost of maintenance, repair and replacement of the Hurricane Limited Common Element shall be the sole responsibility of the Unit Owner which also includes the cost and expense of removal and/or reinstallation by the Association of the hurricane shutter(s) if necessary or required in order for the Association to maintain, repair, replace or protect the Common Elements or Association Property. In the event the Unit Owner installs new hurricane shutters, the cost of the hurricane shutters including the cost of installation thereof shall be borne exclusively by the Unit Owner. The Unit Owner installing new hurricane shutters shall hold harmless and indemnify the Association for all damages, expenses, court costs and attorneys' fees incurred by the Association for repairing any damage to the Building, Common Elements or Limited Common Elements as a result of such installation. All hurricane shutters shall be approved by the Association and shall in all respects comply with the requirements of the South Florida Building Code, as amended, and any other applicable laws, ordinances, rules or regulations of any governmental body having jurisdiction over same. Unit Owners shall submit written requests to the Association for the approval of the installation of hurricane shutters, together with such specifications as the Association requires. All references to hurricane shutters in this Declaration of Condominium shall refer to any shutters which are installed by the Unit Owner to protect his Unit from damage as a result of a hurricane, storm or other casualty or are installed by the Developer in his sole and absolute discretion. Notwithstanding the foregoing if there is any law, rule or regulation requiring the installation of hurricane shutters; the Unit Owner shall install said hurricane shutter at his expense in accordance with the requirements of all applicable laws, codes, rules and regulations.

**10.6 Parking Spaces and Balconies**. Notwithstanding anything contained in this Declaration or its exhibits to the contrary, the following provisions shall govern the parking spaces and balconies:

- (a) Parking spaces shall be maintained, cared, preserved and repaired by the Association.
- (b) All casualty and liability insurance maintained by the Association shall cover parking spaces.
- (c) Where a Limited Common Element consists of a balcony, the Association shall be responsible for the maintenance, care and preservation of the paint and surface of exterior parapet walls, including ceiling within said area which costs and expenses for said maintenance and repair of the balconies shall be a Common Expense to all Unit Owners. The Association shall have the right to collect and enforce such costs and charges as elsewhere provided in accordance with this Declaration and applicable law.

#### **11.0 RIGHTS TO SELL, LEASE AND MORTGAGE**

No Unit Owner may sell or lease his Unit or any interest therein, except by complying with the following provisions:

##### **11.1 Approval by Association:**

- (a) **Notice of Outside Offer:** Any Unit Owner who receives a bona fide written offer, (hereinafter called "the Outside Offer") which he intends to accept for either the purchase or lease of his Unit shall give notice to the Association, by registered or certified mail, return receipt requested, of such offer and intention, together with the name,

address, business, occupation or employment, if any, of the proposed Buyer or lessee and the terms of the proposed transaction and shall enclose with such notice an executed copy of the Outside Offer. Such notice shall constitute a representation and warranty to the Association that such Unit Owner believes the Outside Offer to be bona fide.

(b) Certificate of Approval.

- (i) Sale: If the proposed transaction is a sale, then, within twenty (20) days after receipt of such notice and information, the Association must either approve or disapprove the proposed transaction. If approved, the approval shall be stated in a certificate executed by the proper officers of the Association in recordable form and shall be delivered to the Buyer and shall be recorded in the Public Records of Miami-Dade County, Florida.
- (ii) Lease: If the proposed transaction is a lease, then, within twenty (20) days after receipt of such notice and information, the Association must either approve or disapprove the proposed transaction. If approved, the approval shall be stated in a certificate executed by the proper officers of the Association in recordable form and shall be delivered to the lessee.
- (c) Approval of Owner Other than an Individual: Inasmuch as the Condominium may be used only for residential purposes, and a corporation, trust or other entity cannot occupy a Unit for such use, if the Unit Owner or Buyer of a Unit is a corporation, trust or other entity, the approval of ownership by the corporation, trust or other entity shall be conditioned upon the primary occupant of the Unit being approved by the Association. Any change in the primary occupant of the Unit shall be deemed a change of ownership subject to Association approval pursuant to this Article.

**11.2 Disapproval by Association:** If the Association shall disapprove of the proposed sale or lease and the Unit Owner has offered to sell or lease the Unit to the Association, then, within thirty (30) days after receipt of such notice, the Association may elect, by notice to such Unit Owner by registered or certified mail, return receipt requested, to purchase or lease such Unit, or to cause the same to be purchased or leased by its designee, on the same terms and conditions as contained in the Outside Offer.

**11.3 Subsequent Offers:** In the event that the Unit Owner shall not consummate the contract to sell or lease pursuant to all of the terms and conditions set forth in his notice to the Association, then should such Unit Owner thereafter elect to sell or lease such Unit to the same or another Outside Offeror on the same or other terms and conditions, the Unit Owner shall be required again to comply with all of the provisions of this Article.

**11.4 Application of Condominium Documents to Grantee or Lessee:** Every deed to an Outside Offeror shall provide that the acceptance thereof by the grantee shall constitute an assumption of the provisions of this Declaration, the By-Laws and the Rules and Regulations. Every such lease shall provide: (1) that such Unit may not be sublet without the Association's prior written approval; (2) that the lessee shall comply with and abide by all of the provisions of this Declaration, the By-Laws and the Rules and Regulations; (3) that the lease may not be modified, amended, extended or assigned, without the Association's prior written consent; and (4) that the Association shall have power to terminate such lease or to bring summary proceedings to evict the tenant in the name of the landlord thereunder, in the event of default by the tenant in the performance of such lease. Should any lease not comply with such covenants, then the Association shall have the right to cancel and terminate such lease, all without any obligation to the Unit Owner, and in such respect, the Association shall be regarded as the Unit Owner's agent, fully authorized to take such steps as may be necessary to effect the cancellation and termination of such lease.

**11.5 Unit Owner's Continuing Liability on Lease:** The liability of the Unit Owner under this Declaration shall continue, notwithstanding the fact that he may have entered into a lease as provided herein.

**11.6 Unauthorized Transactions:** Any sale or lease not authorized pursuant to the terms of this Section shall be null and void unless subsequently approved by the Association.

**11.7 Mortgage of Units:** Each Unit Owner shall have the right to mortgage his Unit without restriction, and any mortgagees which acquire title by foreclosure or deed in lieu of foreclosure are specifically excluded from the requirements of this Section 11.

## **12.0 INSURANCE AND RECONSTRUCTION**

**12.1 Insurance Generally:** The Association shall use its best efforts to obtain and maintain adequate insurance to protect the Association, the Association property, the Common Elements, and the Condominium Property required to be insured by the Association pursuant to subsection 12.2 below or by Florida law. The Association may also obtain and maintain liability insurance for directors and officers, insurance for the benefit of Association employees, and flood insurance for Common Elements, Association Property, and Units pursuant to subsection 12.8 below.

### **12.2 Hazard Insurance:**

- (a) **Building Coverage:** Every hazard policy which is issued to protect the Condominium Building shall provide that the word "building" wherever used in the policy include, but not necessarily be limited to, fixtures, installations, or additions comprising that part of the building within the unfinished interior surfaces of the perimeter walls, floors, and ceilings of the individual units initially installed, or replacements thereof of like kind or quality, in accordance with the original plans and specifications, or as they existed at the time the Unit was initially conveyed.
- (b) **Exclusion from Building Coverage:** Hazard insurance on the "building" does not include unit floor coverings, wall coverings, or ceiling coverings and the following equipment if it is located within a Unit and the Unit Owner is required to repair or replace such equipment: electrical fixtures, appliances, air conditioner or heating equipment, water heaters, or built-in cabinets.
- (c) **Extent of Coverage:** Hazard insurance on the "building" shall afford protection against: (1) loss or damage by fire and other hazards covered by a standard extended coverage endorsement; and (2) such other risks as from time to time shall be customarily covered with respect to buildings similar in construction, location and use, including but not limited to vandalism and malicious mischief. All policies of physical damage insurance shall contain waivers of subrogation and waivers of any defense based on co-insurance or other insurance or of invalidity arising from any acts of the insured and of pro rata reduction of liability, and shall provide that such policies may not be canceled or substantially modified without at least ten (10) days' prior written notice to all of the insurers, including all mortgagees of Units. Duplicate originals of all policies of physical damage insurance and of all renewals thereof, together with proof of payment of premiums, shall be delivered to all Institutional Lenders at least ten (10) days prior to the expiration of the current policies. Prior to obtaining any policy of fire insurance or any renewal thereof, the Board shall obtain an appraisal from a fire insurance company or otherwise of the full replacement value of the building (exclusive of foundation), including all of the Units and all of the Common Elements therein, without deduction for depreciation, for the purpose of determining the amount of fire insurance to be obtained pursuant to this Article.

**12.3 Unit Owner's Liability Insurance:** Each Unit Owner shall be liable for injuries or damages resulting from an accident in his own Unit, to the same extent that a homeowner would be liable for an accident occurring within his house. Each Unit Owner may, at his own expense, obtain insurance coverage against personal liability for injury to the person or property of another while within such owner's Unit or upon the Common Elements. No Unit Owner shall be liable personally for any damages caused by the Association in connection with the use of the Common Elements.

**12.4 Requirements Concerning Unit Owner's Insurance:** Every insurance policy issued to an individual Unit Owner shall provide that the coverage afforded by such policy is excess over the amount recoverable under any other policy covering the same property without rights of subrogation against: (1) other Unit Owners; (2) the Association; and (3) the respective servants, agents and guests of other Unit Owners.

**12.5 Reconstruction of Unit:** In the event of loss or damage to a Unit, the Unit Owner, with all due diligence, shall repair, replace and restore such damaged or destroyed portions of the Unit to a condition as good as that before such loss or damage: (1) in accordance with the original plans and specifications for the building; or (2) as the building was last constructed; or (3) in accordance with plans approved by the Board of Administration. If the Unit Owner shall refuse or fail to commence, repair, replace or restore his Unit within thirty (30) days, or to complete such work within six (6) months, the Association may repair, replace or restore the Unit and charge the Unit Owner for the cost of such work.

**12.6 Association's Liability Insurance:** The Association shall maintain comprehensive general public liability and automobile liability insurance covering loss or damage resulting from accidents or occurrences on or about or in connection with the Condominium Property or adjoining driveways and walkways, or any work, matters or things related to the Condominium Property or to this Declaration and its exhibits, with such coverage as shall be required by the Board, but with combined single limit liability of not less than \$500,000 for each accident or occurrence, \$250,000 per person and \$50,000 property damage, and with cross liability endorsement to cover liabilities of the Unit Owners as a group to a Unit Owner and vice versa.

**12.7 Association's Workers' Compensation Insurance:** The Association shall maintain workers' compensation insurance to meet the requirements of law.

**12.8 Other Types of Insurance:** The Association also shall maintain:

- (a) Flood insurance;
- (b) Fidelity insurance covering all officers and employees of the Association;
- (c) Director's liability insurance, if reasonably obtainable, with limits of not less than \$100,000;
- (d) Such other insurance as the Board shall determine from time to time to be necessary and proper.

**12.9 Insurer's Waiver:** When appropriate and obtainable each of the foregoing policies shall waive the insurer's right to: (1) subrogation against the Association and against the Unit Owners individually and as a group; (2) the pro rata clause that reserves the insurer the right to pay only a fraction of any loss if other insurance carriers have issued coverage upon the same risk; and (3) avoid liability for a loss that is caused by an act of the Board or by an Director or by one or more Unit Owners.

**12.10 Purchase of Association's Insurance:** All authorized insurance for the Condominium shall be purchased by the Association. The cost of the insurance shall be a Common Expense, as shall be any other fees and expenses incurred which may be necessary or incidental to carrying out the provisions hereof. Each policy shall be issued by an insurance company authorized to do business in Florida and with an office or agent located in Miami-Dade County.

**12.11 Named Insured:** With respect to coverage on the Condominium Property, the named insured shall be the Condominium Association individually and as agent for Unit Owners and their mortgagees covered by the policy, without naming them. Unit Owners shall be considered additional insureds under each policy.

**12.12 Custody of Policies and Payment of Proceeds:** All policies shall provide that the insurer's payments for losses shall be made to the Insurance Trustee, and that all policies and endorsements shall be deposited with the Insurance Trustee.

**12.13 Approval of Insurance by Mortgagees:** Each insurance policy, the agency and company issuing the policy and the Insurance Trustee shall be subject to the approval of the Institutional Lender then holding the greatest dollar volume of Unit mortgages. One copy of each insurance policy or a certificate evidencing same, and all endorsements thereon, shall be furnished by the Condominium Association to each mortgagee included in the mortgagee register. Copies or certificates shall be furnished not less than ten (10) days prior to the beginning of the term of the policy or not less than ten (10) days prior to the expiration of each preceding policy that is being renewed or replaced, whichever date shall occur first.

**12.14 Insurance Trustee; Proceeds:** All insurance policies of the Association shall be for the benefit of the Association and the Unit Owners and their mortgagees, as their interests may appear, and shall provide that all proceeds covering property losses shall be paid to the Insurance Trustee, as designated by the Board, which shall be any bank, savings and loan or trust company in Florida with trust powers and with its principal place of business in Miami-Dade County, Florida. The Insurance Trustee shall not be liable for payment of premiums or for the renewal or the sufficiency of policies, or for the failure to collect any insurance proceeds. The Insurance Trustee's duty shall be to receive such proceeds as are paid and to hold the same in trust for the Unit Owners and their respective mortgagees in the following shares (which shares need not be set forth in the Insurance Trustee's records):

- (a) **Damage to Common Elements:** An undivided share of the proceeds shall be held for each Unit Owner in proportion to his Unit's Common Interest.
- (b) **Damage to Units:**
  - (i) When a building is to be restored, an undivided share of the proceeds shall be held for each Unit Owner in such building in the proportion that the cost of repairing the damage sustained by each Unit, as determined by the Association, bears to the total proceeds received.
  - (ii) When a building is not to be restored, an undivided share of the proceeds shall be held for each Unit Owner in proportion to his Unit's Common Interest.

**12.15 Assessments; Insurance Proceeds Insufficient:** If it shall appear that the insurance proceeds covering casualty loss or damage are insufficient to pay for the repair, replacement or reconstruction of the loss or damage sustained, then the Association shall deposit with the Insurance Trustee a sum which, together with the insurance proceeds, will be sufficient to completely pay for the repair, replacement or reconstruction of such loss or damage. The monies so deposited by the Association may be drawn from the replacements reserve fund. If the sum in such fund is insufficient, then the Association shall levy and collect an assessment proportionally against all the Unit Owners, in the amount needed to pay for such repair, replacement or reconstruction.

**12.16 Distribution of Proceeds:** Proceeds of insurance policies received by the Insurance Trustee shall be distributed in the following manner:

- (a) **Expenses of the Trust:** All expenses of the Insurance Trustee shall be first paid or provision made therefor.
- (b) **Reconstruction or Repair:** If the damage shall be repaired or reconstructed, the remaining proceeds shall be paid to defray the costs thereof. Any

proceeds remaining after defraying such costs shall be distributed according to Common Interests to the Unit Owners and their mortgagees, being payable jointly to them.

- (c) **Failure to Reconstruct or Repair:** If it is determined that the damage shall not be reconstructed or repaired, for any or no reason at all, the remaining proceeds shall be divided among all the Unit Owners in proportion to their respective Common Interests, provided, however, that no payment shall be made to a Unit Owner until all liens on his Unit have been satisfied from his share of the fund by distributing first to the Institutional Lender in an amount sufficient to satisfy and pay its mortgages in full, and the balance, if any, to the Unit Owner with the proviso that remittances to the Unit Owner and his mortgagee shall be payable jointly to them.
- (d) **Association Certificate; Unit Owner Insurance Shares:** In making distribution to Unit Owners and their mortgagees, the Insurance Trustee may rely upon a certificate of the Association executed by its president and secretary as to the names of the Unit Owners, their mortgagees and their respective shares of the distribution.

**12.17 Restriction on Mortgagee Insurance Share:** Certain provisions in this Article are for the benefit of the mortgagees of Units and maybe enforced by such mortgagees. No mortgagee shall, however, have any right to apply or have applied to the reduction of a mortgage debt any insurance proceeds except distributions thereof made pursuant to this Section. No mortgagee shall have any right to determine or participate in the determination as to whether or not any damaged property shall be reconstructed or repaired.

**12.18 Association as Agent:** The Condominium Association is hereby irrevocably appointed agent for each Unit Owner, mortgagee and owner of any other interest in the Condominium Property to adjust all claims arising under insurance policies purchased by the Association and to execute and deliver releases upon the payment of claims.

**12.19 Determination to Reconstruct or Repair:** The Association shall be responsible for reconstruction and repair after casualty loss or damage to the Condominium. Except in the case of termination of the Condominium, the Board shall arrange for necessary repairs and reconstruction either within sixty (60) days from the date the Insurance Trustee notifies the Board that it holds proceeds of insurance on account of such damage or destruction sufficient to pay the estimated cost of such work or within ninety (90) days after the Insurance Trustee notifies the Board that such proceeds of insurance are insufficient to pay said estimated costs of such work. Such reconstruction and repairs shall apply to all damaged Units and shall include bathroom and kitchen fixtures as initially installed by Developer, but shall not include furniture, furnishings, and other personal property supplied or installed by any Unit Owner or tenant. The Insurance Trustee shall disburse the proceeds of all insurance policies to the contractors engaged in such repair and restoration in appropriate progress payments.

**12.20 Termination in Lieu of Reconstruction:** In the event of destruction of at least seventy-five percent (75%) of the total value of the improvements and the building of the Condominium Property (as determined by the Board), then this Condominium shall be automatically terminated, unless at a meeting of the Association held within thirty (30) days from the date the damage was sustained, Unit Owners owning at least two-thirds (2/3) of the Units agree that the Condominium shall be reconstructed. If this Condominium is to be terminated, then a certificate of resolution of the Board to such effect and notice of cancellation and termination shall be executed by the president and secretary of the Association in recordable form and recorded in the Public Records of Miami-Dade County, Florida. Upon such termination, all Unit Owners shall be tenants in common as to ownership of the Common Elements and the Common Surplus in the proportion of their Common Interests. The lien of any mortgage or other encumbrance upon each Unit shall attach, in the same order or priority, to the percentage of undivided interest of the Unit Owner. Upon termination of this Declaration and within sixty (60) days from the date of recording of the certificate of resolution, the owner(s) of all Units still habitable shall deliver possession of their respective Unit(s) to the Association. Upon termination of this Declaration, the Insurance Trustee shall distribute the insurance proceeds from any

casualty insurance coverage to the Unit Owners and their mortgagees, as their respective interests may appear, in accordance with their Common Interests. The assets of the Association, upon termination shall be distributed to all of the Unit Owners and their mortgagees, as their respective interests may appear, in the same manner as provided for the distribution of any final insurance proceeds. The Insurance Trustee may rely upon a certificate of the Condominium Association executed by its president and secretary to determine whether or not the damaged property is to be reconstructed or repaired.

**12.21 Plans and Specifications:** Any reconstruction or repair must either be: (1) substantially in accordance with the original plans and specifications for the original improvements; or (2) according to plans and specifications approved by the Board. If the damaged property is a building containing Units, then the plans and specifications must be approved by the owners owning at least two-thirds (2/3) of the Units, including the owners of all Units (and their respective mortgagee) which are to be altered by virtue of such plans and specifications.

**12.22 Contracts for Repair:** The Association shall obtain reliable and detailed estimates of the cost to rebuild or repair damage. The estimate shall be obtained immediately after a determination is made to rebuild or repair. Before they may become binding, all contracts for repair, replacement or reconstruction of loss or damage shall be approved by the Board.

**12.23 The Construction Fund:** The construction fund shall consist of: (a) insurance proceeds collected by the Insurance Trustee as a result of casualty loss or damage; and (b) the Association's assessments and/or reserve funds to be deposited with the Insurance Trustee in the event insurance proceeds are insufficient to cover the cost of necessary repair, replacement and reconstruction. Construction funds shall be disbursed in the following manner and order:

- (i) **Minor Damage:** If the amount of the estimated costs of reconstruction, replacement and repair is less than \$50,000, then the construction fund shall be disbursed in payment of such costs upon the order of the Board, unless a mortgagee of a damaged Unit notifies the Insurance Trustee of such mortgagee's objection(s), in which case such funds shall be disbursed in the manner provided for disbursements for major damage.
- (ii) **Major Damage:** If the amount of the estimated costs of reconstruction and repair is more than \$50,000, then the construction fund shall be disbursed in payment of such costs upon the order of the Board together with the approval of an architect qualified to practice in Florida and employed by the Association to supervise the work.
- (iii) **Distribution of Excess Proceeds:** If the proceeds in the construction fund are in excess of all paid costs of repair, replacement and reconstruction, then such excess proceeds shall be applied first to the Association's reserve funds to the extent that the Association deposited reserve funds with the Insurance Trustee and the remainder shall be allocated to Unit Owners to the extent of special assessments by the Association and any further amount shall be distributed pursuant to the terms of this Section.
- (iv) **Association Certificate to Insurance Trustee:** The Insurance Trustee may rely upon a duly executed certificate of the Association as to all of the following matters: (a) whether Association assessment and reserve funds shall be deposited with the Insurance Trustee (b) whether an architect's approval shall be necessary for disbursement from the construction fund; (c) whether any disbursement shall be made from the construction fund; (d) names of payees and amounts to be paid; and (e) whether all costs have been paid, leaving excess proceeds for distribution.

**12.24 Insurance Trustee Optional:** The board of Directors of the Association shall have the option in its sole discretion of appointing an Insurance Trustee hereunder. If the Association fails or elects not to appoint such Insurance Trustee, the Association will

perform directly all obligations imposed upon such Insurance Trustee by this Declaration. Fees and expenses of any Insurance Trustee are Common Expenses.

### **13.0 CONDEMNATION; EMINENT DOMAIN**

**13.1 Deposit of Awards with Insurance Trustee:** The taking of Condominium Property by condemnation eminent domain or a taking of Property by any governmental agency as determined by a court of competent jurisdiction ("the taking") shall be deemed to be a casualty, and the awards for that taking shall be treated as insurance proceeds and shall be deposited with the Insurance Trustee. Even though the awards may be payable to Unit Owners, the Unit Owners shall deposit the awards with the Insurance Trustee.

**13.2 Determination Whether to Continue Condominium:** Whether the Condominium will be continued after the taking will be determined in the manner provided in this Declaration for determining whether damaged property will be reconstructed and repaired after casualty.

**13.3 Disbursement of Funds:** If the Condominium is terminated after the taking, the proceeds of the awards and special assessments shall be deemed to be Condominium Property and shall be owned and distributed in the manner provided for distribution of insurance proceeds after a casualty. If the Condominium is not so terminated, the size of the Condominium shall be reduced and the owners of taken Units will be made whole and the property damaged by the taking will be made usable in the manner provided below. The proceeds of the awards and special assessments shall be used for these purposes and shall be disbursed in the manner provided in this Declaration for disbursements of funds by the Insurance Trustee after a casualty.

**13.4 Unit(s) Reduced but Habitable:** If the taking reduces the size of a Unit and the remaining portion of the Unit can be made habitable, the award for the taking of a portion of the Unit shall be used as follows:

- (a) **Restoration of a Unit:** If possible, the Unit shall be made habitable.
- (b) **Distribution of Surplus:** Any surplus balance of the award shall be distributed to the Unit Owner and to each mortgagee of the Unit, if any, the remittance being made payable jointly to the owner and mortgagee(s).
- (c) **Adjustment of Common Interests:** If the floor area of any Unit is reduced by the taking, the Common Interest of all Unit Owners shall be recomputed whereby each Common Interest shall be a fraction whose numerator, is the number of square feet of floor space in the Unit and whose denominator is the number of square feet of the aggregate of all of the remaining Units.

**13.5 Uninhabitable Unit(s):** If the taking is of the entire Unit or so much of the Unit as to render it uninhabitable, then the award shall be used as follows:

- (a) **Payment of Award:** The award shall be divided among those Unit Owners whose Units are uninhabitable in proportion to their Common Interests, provided however, that no payment shall be made to a Unit Owner until all liens upon his Unit have been satisfied from his share of the funds.
- (b) **Addition to Common Elements:** The remaining portion of any uninhabitable Unit shall become part of the Common Elements and shall be renovated to be usable by all Unit Owners in a manner approved by the Board.
- (c) **Adjustment of Common Interests:** Recomputation of the remaining Unit Owners' Common Interests shall be pursuant to the procedure set forth subsection 13.4 (c) hereof.

**13.6 Taking of Common Elements:** Awards for the taking of Common Elements shall be used to make the remaining portion of the Common Elements usable in the manner approved by the Board.

**13.7 Amendment:** Changes in the Condominium caused by the taking shall be evidenced in an amendment to the Declaration, which amendment shall require the approval only of a majority of the Board.

#### **14.0 INSTITUTIONAL LENDER PROTECTION:**

**14.1 Notices: Generally:** Each Institutional Lender, at its written request, shall be entitled to written notification from the Association of any default by the Owner of a Unit encumbered by Institutional Lender's mortgage in the performance of such Owner's obligations under this Declaration, the Articles of Incorporation or the By-Laws, if such default shall not be cured within thirty (30) days after the Association shall learn of such default. Each Institutional Lender which has registered its name with the Association shall be given: (i) thirty (30) days written notice prior to the effective date of any proposed, material amendment to this Declaration or the Articles of Incorporation or By-Laws and prior to the effective date of the termination of any agreement for professional management of the Condominium Property following a decision of the Owners to assume self-management of the Condominium Property; and (ii) immediate notice following any damage to the Condominium Property whenever the cost of reconstruction shall exceed Ten Thousand Dollars (\$10,000.00), and as soon as the Board shall learn of any threatened condemnation proceeding or proposed acquisition of any portion of the Condominium Property.

**14.2 Notices/FNMA Requirements:** If the FNMA requirements are applicable, upon written request to the Association, identifying the name and address of the Institutional Lender, or insurer or guarantor thereof, and the Unit number or address, any such eligible mortgage holder or eligible insurer or guarantor will be entitled to timely written notice of: (a) any condemnation loss or any casualty loss which affects a material portion of the Condominium Property or any Unit on which there is a first mortgage held, insured or guaranteed by such eligible mortgage holder or eligible insured or guarantor, as applicable; (b) any delinquency in the payment of assessments or charges owed by an Owner of a Unit subject to a first mortgage held, insured or guaranteed by such eligible holder or eligible insurer or guarantor, which remains uncured for sixty (60) days; (c) any lapse, cancellation or material modification of any insurance policy or fidelity bond maintained by the Association; and (d) any proposed action which would require the consent of a specified percentage of mortgage holders.

**14.3 Restriction on Association Authority:** The Association shall not be entitled to take the following actions without the prior written approval of at least two-thirds (2/3) of the Owners including the Developer (based upon one vote for each Unit):

- (a) By act or omission, seek to abandon, partition, subdivide, encumber, sell or transfer the Condominium Property (the granting of easements for public utilities or for other public purposes consistent with the intended use of such Condominium Property shall not be deemed a transfer);
- (b) Change the method of determining the obligations, assessments, dues or other charges which may be levied against an Owner;
- (c) By act or omission, change, waive or abandon any scheme of regulations, or enforcement thereof, pertaining to the architectural design or the exterior appearance of Residences, the exterior maintenance of the Units, the maintenance of the Condominium Property, party walks or common fences and driveways, care the upkeep of lawns and plantings in the Community;
- (d) Fail to maintain fire and extended coverage on insurable Condominium Property on a current replacement cost basis in an amount not less than one hundred percent (100%) of the insurable value (based on current replacement cost);
- (e) Use hazard insurance proceeds for losses to any Condominium Property for other than the repair, replacement or reconstruction of such Condominium Property.

Additionally, the Association shall not be entitled to change the proportion or percentage by which an Owner shares the Common Expenses and owns the Common Surplus unless the record Owner of the Unit and all record owners of liens on the Unit join in the execution of the amendment providing for such change and unless all the record Owners of all the other Units approve such amendment.

**14.4 Inspection of Books and Records:** Institutional Lenders shall have the right to examine the Association's books and records during normal business hours.

**14.5 Right to Pay Overdue Charges:** Institutional Lenders may, jointly or singly, pay taxes or other charges which are in default and which may or have become a charge against any Condominium Property facilities and may pay any overdue premiums on hazard insurance policies, or secure new hazard insurance coverage on the lapse of a policy, for such property, and Institutional Lenders making such payments shall be owed immediate reimbursement therefor from the Association.

**14.6 Additional Rights of Mortgagees and Others:** Institutional First Mortgagees shall have the right, upon written request to the Association, to : (i) examine the Condominium documents and the Association's books and records, (ii) receive a copy of the Association's audited financial statement for the immediately preceding fiscal year, which audited financial statement must be available within 120 days of the Association's fiscal year end, (iii) receive notices of and attend Association meetings, (iv) receive notice of any alleged default in any obligations hereunder by any Unit Owner, on whose Unit such Institutional First Mortgage holds a mortgage, which is not cured within thirty (30) days of notice of default to the Unit Owner, and (v) receive notice of any substantial damages or loss to any portion of the Condominium Property.

Any holder, insurer or guarantor of a mortgage on a Unit shall have, if first requested in writing, the right to timely provide written notice of (i) any condemnation or casualty loss affecting a material portion of the Condominium Property or the affected mortgaged Unit (ii) a sixty (60) day delinquency in the payment of the Assessments on the Mortgaged Unit, (iii) the occurrence of a lapse, cancellation or material modification of any insurance policy or fidelity bond maintained by the Association, (iv) any proposed termination of the Condominium, and (v) any proposed action which requires the consent of a specified number of mortgage holders.

#### **15.0 COMPLIANCE; DEFAULT:**

**15.1 Compliance; Generally:** Each owner, tenant and occupant of a Unit shall comply with the provisions of this Declaration, the Articles of Incorporation and the By-Laws of the Association. Failure to comply therewith shall be grounds for relief sought by the Association which may include an action for damages, injunctive relief, foreclosure of lien or any combination of the foregoing.

**15.2 Unit Owner's Liability:** Each Unit Owner shall be liable for the expense of any maintenance, repair or replacement rendered necessary by his act, neglect or carelessness, or by the act of any member of his family, any guest, employee, agent or tenant, but only to the extent that such expense is not met by the insurance proceeds paid to the Association. The Association shall be entitled to recover its costs where judicial proceedings are involved in establishing liability, including reasonable attorneys' fees. In no event shall any Unit Owner be entitled to attorneys' fees.

**15.3 No Waiver:** The failure of the Association or of a Unit Owner to enforce any rights, provisions, covenant or condition which may be granted by this Declaration or other Condominium documents shall not constitute a waiver to enforce such rights, provisions, covenant or condition in the future.

**15.4 Fines:** The Association may levy a reasonable fine against a Unit and/or Unit Owner for the failure of the Owner of the Unit, the Unit's occupant, or the Unit Owner's lessee, licensee, or invitee to comply with this Declaration (including its exhibits and amendments) and/or the Rules and Regulations promulgated by the Association from time to time. No such fine levied by the Association shall exceed the maximum amount provided by any applicable Florida law. Each day of violation shall be deemed a separate violation.

subject to separate fine. The party against whom the fine is sought to be levied shall be afforded an opportunity for a hearing held before a committee of other unit owners after reasonable notice of at least fourteen (14) days, which notice shall include:

- (a) A statement of the date, time and place of the hearing;
- (b) A statement of the provisions of the Declaration of Condominium, By-Laws or Rules and Regulations which have allegedly been violated; and
- (c) A short and plain statement of the matters asserted by the Association.
- (d) The party against whom the fine may be levied shall have an opportunity to respond, to present evidence, and to provide written and oral argument on all issues involved and shall have an opportunity at the hearing to review, challenge and respond to any material considered by the Association.

**15.5 Cumulative Remedies:** All rights, remedies and privileges granted to the Association or the Unit Owners pursuant to any terms, provisions, covenants or conditions of this Declaration or other Condominium documents shall be deemed to be cumulative, and the exercise of any one or more shall not be deemed to constitute an election of remedies, nor shall it preclude the party thus exercising the same from exercising such other and additional rights, remedies or privileges as may be available at law or in equity. The failure of Developer to enforce any rights, privileges, covenant or condition which may be granted to Developer by this Declaration or other Condominium documents shall not constitute waiver of the right of Developer thereafter to enforce such right, provision, covenant or condition in the future.

#### **16.0 OFFICIAL RECORDS:**

**16.1 Itemization:** From the inception of the Association, the Association shall maintain a copy of each of the following, where applicable, which shall constitute the official records of the Association:

- (a) The plans, permits, warranties and other items provided by Developer pursuant to the Act.
- (b) A photocopy of the recorded Declaration and all amendments hereto.
- (c) A photocopy of the recorded By-Laws and all amendments thereto.
- (d) A certified copy of the Articles of Incorporation and all amendments thereto.
- (e) A copy of the current Rules of the Association.
- (f) A book or books containing the minutes of all meetings of the Association and the Board, which minutes shall be retained for a period of not less than seven (7) years.
- (g) A current roster of all Unit Owners, their mailing addresses, Unit identifications, voting certifications, and if known, telephone numbers. In the event of the sale or other transfer of any Unit to a third party, the Buyer or transferee shall notify the Association in writing of his interest in such Unit, together with such recording information as shall be pertinent to identify the instrument by which such Buyer or transferee has acquired his interest in any Unit. Further, each Unit Owner shall immediately notify the Association of each and every mortgage on the Unit, the mortgagee(s), the amount of each mortgage and all pertinent recording information. The mortgagee(s) for any Unit may notify the Association of the existence of any such mortgage(s). Upon receipt of such notice, the Association shall register in its records all pertinent information.
- (h) All current insurance policies of the Association.

20512 PG 1092

- (i) A current copy of any management agreement, lease or other contract to which the Association is a party or under which the Association or the Unit Owners have an obligation or responsibility.
- (j) Bills of sale or transfer for all property owned by the Association.
- (k) Accounting records of the Association prepared according to good accounting practices, which accounting records shall be maintained for a period of not less than seven (7) years. The accounting records shall include, but not be limited to:
  - (i) Accurate, itemized and detailed records of all receipts and expenditures.
  - (ii) A current account and a monthly, bimonthly or quarterly statement of the account for each Unit designating the name of the Unit Owner, the due date and amount of each assessment, the amount paid upon the account and the balance due.
  - (iii) All audits, reviews, accounting statements and financial reports of the Association.
  - (iv) All contracts for work to be performed. Bids for work to be performed shall also be considered official records and shall be maintained for a period of one (1) year.
- (l) Voting proxies which shall be maintained for a period of one (1) year from the date of the meeting for which the proxy was given.
- (m) All rental records where the Association is acting as agent for the rental of Units.

**16.2 Inspection:** The official records of the Association shall be maintained in Miami-Dade County and shall be open to inspection by any Member or the authorized representative of such Member at all reasonable times.

#### **17.0 IMPLIED AND EXPRESS WARRANTIES**

THE DEVELOPER EXPRESSLY DISCLAIMS ALL IMPLIED AND EXPRESS WARRANTIES WITH REGARD TO ANY ASPECT OF THIS CONDOMINIUM, INCLUDING THOSE OF MERCHANTABILITY AND FITNESS FOR A PARTICULAR PURPOSE, EXCEPT THOSE IMPLIED WARRANTIES PERTAINING TO THE DEVELOPER AS REQUIRED UNDER FLORIDA STATUTES SECTION 718.203.

#### **18. TERMINATION OF CONDOMINIUM**

**18.1 Termination - Generally:** Unless as otherwise provided in this Declaration, the Condominium Property shall be removed from the provisions of this chapter only by consent of all of the Unit Owners, evidenced by a recorded instrument to that effect, and upon the written consent by all of the holders of recorded liens affecting any of the Condominium Parcels. Upon recordation of the instrument evidencing consent of all the Unit Owners to terminate the Condominium, the Association shall notify the Division within 30 working days of the termination and the date the document was recorded, the county where the document was recorded, and the book and page number of the public records where the document was recorded.

Notwithstanding the above and except as otherwise provided for in this Declaration, including but not limited to Sections 12 and 13 of this Declaration, in the event that there is a taking of any Unit without compensation or if any Unit can not be rebuilt for any reason other than lack of funds, and said Unit Owner does not receive fair market value for said Unit as determined by an appraiser to be selected by the Association and whose determination shall be binding on the Unit Owner and the Association, then this Condominium shall automatically terminate.

**18.2 Powers and Duties of Directors:** Notwithstanding any contrary provision in the Declaration or the Bylaws, the powers and duties of the directors, or other person or persons appointed by the court pursuant to Subsection 18.4, after the commencement of a termination proceeding include, but are not limited to, the following acts in the name and on behalf of the Association:

- (a) To employ directors, agents, attorneys to liquidate or wind up its affairs.
- (b) To continue the conduct of the affairs of the Association insofar as necessary for the disposal or winding up thereof.
- (c) To carry out contracts and collect, pay, compromise, and settle debts and claims for and against the Association.
- (d) To defend suits brought against the Association.
- (e) To sue in the name of the Association, for all sums due or owing to the Association or to recover any of its Property.
- (f) to perform any act necessary to maintain, repair, or demolish unsafe and uninhabitable structures, or other Condominium Property in compliance with applicable codes.
- (g) To sell at public or private sale, exchange, convey, or otherwise dispose of all or any part of the assets of the Association, and to execute bills of sale and deeds of conveyance in the name of the Association.
- (h) To collect and receive any and all rents, profits, accounts receivable, income, maintenance fees, Special Assessments, and insurance proceeds for the Association.
- (i) In general, to make contracts and to do any and all things in the name of the Association which may be proper and convenient for the purposes of winding up, selling, and liquidating the affairs of the Association.

**18.3 Election of Vacancy:** Unless the Declaration or the Bylaws provide otherwise, a vacancy in the Board during a winding up proceeding, resulting from the resignation or expiration of term of any director, may be filled by a majority vote of the Unit Owners.

**18.4 Appointment of Receiver:** If, after a natural disaster, the identity of the directors or their right to hold office is in doubt, or if they are dead or unable to act, or if they fail or refuse to act or their whereabouts cannot be ascertained, any interested person may petition the circuit court to determine the identity of the directors, or if determined to be in the best interest of the Unit Owners, to appoint a receiver to wind up the affairs of the Association after hearing upon such notice to such persons as the court may direct. The receiver shall be vested with those powers as are given to the Board of directors pursuant to the Declaration and Bylaws and Subsection 18.2 and such others which may be necessary to wind up the affairs of the Association and set forth in the order of appointment. The appointment of the receiver shall be subject to such bonding requirements as the court may direct in the order of appointment. The order shall also provide for the payment of a reasonable fee for the services of the receiver from the sources identified in the order, which may include rents, profits, incomes, maintenance fees, or Special Assessments collected from the Condominium Property.

**18.5 Determination of Debts and Liabilities:** After determining that all known debts and liabilities of the Association in the process of winding up have been paid or adequately provided for, the Board, or other person or persons appointed by the court, pursuant to Subsection 18.4, shall distribute all the remaining assets in the manner set forth in Subsection 18.6. If the winding up is by court proceeding or subject to court supervision, the distribution shall not be made until after the expiration of any period for the presentation of claims that have been prescribed by order of the court.

**18.6 Distribution of Assets:** Assets held by the Association requiring return, transfer, or conveyance in accordance with this Declaration or statute shall be distributed as follows:

(a) If the Declaration or Bylaws provides the manner of disposition the assets shall be disposed in that manner.

(b) If the Declaration or Bylaws do not provide the manner of disposition, the assets shall be distributed among the Unit Owners in accordance with their respective rights therein, as set forth in Subsection 18.7.

**18.7 Effect:** Upon such termination, the Condominium Property shall be owned by the Unit Owners in the same shares as each Owner previously owned in the Common Elements, and the Condominium Property shall be subject to an action for partition by any Unit Owner or mortgagee. The net proceeds of such a partition shall be divided among all Unit Owners in proportion to their Common Interests; provided that no payment shall be made to a Unit Owner until all liens against his Unit have been satisfied out of his share of the proceeds in order of their priority.

**18.8 Form of Distribution:** Distribution may be made either in money or in property or securities and either in installments from time to time or as a whole, if this can be done fairly and ratably and in conformity with the Declaration and shall be made as soon as reasonably consistent with the beneficial liquidation of the assets.

**18.9 Continuance after Termination:** An association that has been terminated nevertheless continues to exist for the purpose of winding up its affairs, prosecuting and defending actions by or against it, and enabling it to collect and discharge obligations, dispose of and convey its property, and collect and divide its assets, but not for the purpose of conducting its activities except so far as necessary for the winding up thereof.

**18.10 Creation of New Condominium:** The termination of this Condominium shall not bar the creation of another condominium affecting all or any portion of the same property.

#### **19.0 AMENDMENT OF DECLARATION; CORRECTION OF ERRORS OR OMISSIONS**

**19.1 Approval of Amendments:** Except as otherwise provided in this Declaration, this Declaration may be amended as to all matters, except those described in Subsections 19.5 and 19.9 below, if the amendment is approved by at least two-thirds ( $\frac{2}{3}$ ) of the Unit Owners.

**19.2 Manner of Amendment:** No provision of this Declaration shall be revised or amended by reference to its title or number only. Proposals to amend existing provisions of this Declaration shall contain the full text of the provision to be amended) new words shall be inserted in the text and underlined; and words to be deleted shall be lined through with hyphens. However, if the proposed change is so extensive that this procedure would hinder, rather than assist, the understanding of the proposed amendment, it is not necessary to use underlining and hyphens as indicators of words added or deleted, but, instead, a notation must be inserted immediately preceding the proposed amendment in substantially the following language: "Substantial rewording of Declaration. See Section \_\_\_ for present text."

**19.3 Nonmaterial Errors:** Nonmaterial errors or omissions in the amendment process will not invalidate an otherwise properly promulgated amendment.

**19.4 Recording of Amendments:** An amendment (other than amendments made by the Developer pursuant to Sections 718.104, 718.403, and 718.504(6), (7) and (9), Florida Statutes without a vote of the Unit Owners and any rights the Developer may have in the Declaration to amend without consent of the Unit Owners which shall be limited to matters other than those described in Subsections 19.5 and 19.9 below) shall be evidenced by a certificate of the Association which shall include the recording data identifying the Declaration and shall be executed in the form required for the execution of a deed. An amendment by the Developer must be evidenced in writing, but a certificate of the Association is not required. An amendment of a Declaration is effective when properly recorded in the public records of the Miami-Dade County, Florida.

**19.5 Material Alterations:** No amendment may change the configuration or size of any Condominium Unit in any material fashion, materially alter or modify the appurtenances to the Unit, or change the proportion or percentage by which the owner of the parcel shares the Common Expenses and owns the Common Surplus unless the record Owner of the Unit and all record owners of liens on it join in the execution of the amendment and unless all the record Owners of all other Units approve the amendment. The acquisition of property by the Association, and material alterations or substantial additions to such property or the Common Elements by the Association in accordance with Section 718.111(7) or 718.113, Florida Statutes, shall not be deemed to constitute a material alteration or modification of the appurtenances to the Units. Unless required by any governmental entity, this Paragraph may not be amended by less than a majority of total voting interests.

**19.6 Scrivener Errors:** If it appears that through a scrivener's error a Unit has not been designated as owning an appropriate undivided share of the Common Elements or does not bear an appropriate share of the Common Expenses or that all the Common Expenses or interest in the Common Surplus or all of the Common Elements in the Condominium have not been distributed in the Declaration, so that the sum total of the shares of Common Elements which have been distributed or the sum total of the shares of the Common Expenses or ownership of Common Surplus fails to equal 100 percent, or if it appears that more than 100 percent of Common Elements or Common Expenses or ownership of the Common Surplus have been distributed, or there is some other scrivener's error, the error may be corrected by filing an amendment to the Declaration approved by the Board of Administration or a majority of the Unit Owners.

**19.7 Enlargement of Common Elements:** The Common Elements designated by the Declaration may be enlarged by an amendment to the Declaration. The amendment must describe the interest in the property and must submit the property to the terms of the Declaration. The amendment must be approved and executed as provided in this Section. The amendment divests the Association of title to the land and vests title in the Unit Owners as part of the Common Elements, without naming them and without further conveyance, in the same proportion as the undivided shares in the Common Elements that are appurtenant to the Unit owned by them.

**19.8 Merger of Condominiums:** The declarations, by-laws, and common elements of two or more independent condominiums of a single complex may be merged to form a single condominium, upon the approval of such voting interest of each condominium as is required by the declaration for modifying the appurtenances to the units or changing the proportion or percentages by which the owners of the parcel share the common expenses and own the common surplus; upon the approval of all record owners of liens; and upon the recording of new or amended articles of incorporation, declarations, and bylaws.

**19.9 Time-Share Estates:** No amendment to the Declaration may permit time-share estates to be created in any unit of the Condominium, unless the record Owner of each Unit of the Condominium and the record owners of liens on each Unit of the Condominium join in the execution of the amendment.

**19.10 Errors and Omissions:** If there is an omission or error in this Declaration of Condominium, or in any other document required by law to establish the Condominium, the Association may correct the error or omission by an amendment to this Declaration or to the other document required to create a condominium in the manner provided in the Declaration to amend the Declaration or, if none is provided, by vote of a majority of the Voting Interests. The amendment is effective when passed and approved and a certificate of the amendment is executed and recorded as provided in Section 718.110, Florida Statutes. This procedure for amendment cannot be used if such an amendment would materially or adversely affect property rights of Unit Owners, unless the affected Unit Owners consent in writing. This Paragraph does not restrict the powers of the Association to otherwise amend the Declaration, or other documentation, but authorizes a simple process of amendment requiring a lesser vote for the purpose of curing defects, errors, or omissions when the property rights of Unit Owners are not materially or adversely affected.

**19.11 Jurisdiction:** If there is an omission or error in this Declaration, or any other document required to establish the Condominium, which omission or error would affect the

valid existence of the Condominium, the Circuit Court has jurisdiction to entertain a petition of one or more of the Unit Owners in the Condominium, or of the Association, to correct the error or omission, and the action may be a class action. The court may require that one or more methods of correcting the error or omission be submitted to the Unit Owners to determine the most acceptable correction. All Unit Owners, the Association, and the mortgagees of a first mortgage of record must be joined as parties to the action. Service of process on Unit Owners may be by publication, but the plaintiff must furnish every Unit Owner not personally served with process with a copy of the petition and final decree of the court by certified mail, return receipt requested, at the Unit Owner's last known residence address. If an action to determine whether the Declaration or another condominium document complies with the mandatory requirements for the formation of a condominium is not brought within 3 years of the recording of the Declaration, the Declaration and other documents shall be effective under Chapter 718, Florida States, to create a condominium, as of the date this Declaration was recorded, whether or not the documents substantially comply with the mandatory requirements of law. However, both before and after the expiration of this 3-year period, the Circuit Court has jurisdiction to entertain a petition permitted under this Paragraph for the correction of the documentation, and other methods of amendment may be utilized to correct the errors or omissions at any time.

**19.12 Consent and Joinder of Mortgagee:** Notwithstanding any provision to the contrary contained in Section 718.110, Florida Statutes, this Declaration may not require the consent or joinder of some or all mortgagees of Units to or in amendments to the Declaration, unless the requirement is limited to amendments materially affecting the rights or interests of the mortgagees, or as otherwise required by the Federal National Mortgage Association or the Federal Home Loan Mortgage Corporation, and unless the requirement provides that such consent may not be unreasonably withheld. It shall be presumed that, except as to those matters described in Subsections 19.5 and 19.9 above, amendments to the Declaration do not materially affect the rights or interests of mortgagees. In the event mortgagee consent is provided other than by properly recorded joinder, such consent shall be evidenced by affidavit of the association recorded in the Public Records of Miami-Dade County, Florida.

**19.13 Amendments Prior to Turnover.** During the period of Developer control, the Declaration, Articles of Incorporation or the By-Laws of the Association may be amended to correct an omission or error, or to effect any other amendment by obtaining approval of a majority of the voting interests of the Board of Directors of the Association except that this procedure for amendment may not be used if such an amendment would materially and adversely affect substantial property rights of Unit Owners, unless the affected Unit Owners consent in writing.

## **20.0 MISCELLANEOUS PROVISIONS**

**20.1 Covenants Running with the Land:** The restrictions and burden imposed by this Declaration shall constitute covenants running with the land, and shall constitute an equitable servitude upon each Unit. This Declaration shall be binding upon Developer and all parties who become Unit Owners in the Condominium, and their respective heirs, legal representatives, successors and assigns.

**20.2 Limitation on Warranties and Representations:** Other than as set forth in Section 718.203, Florida Statutes, Developers specifically disclaims any intent to have made any warranty or representation in connection with the Condominium Property or the Condominium documents, except as specifically set forth therein, and no person shall rely upon any warranty or representation not so specifically made therein. Any estimates of Common Expenses, taxes or other charges are deemed accurate, but no warranty or guaranty is made or intended, nor may one be relied on.

**20.3 Developer's Miscellaneous Rights:** For as long as there are any unsold Units, Developer shall have the right: (1) to use any such Units and portions of the Common Elements for model Units and sales and re-sales offices or for any other purpose; (2) to display model Units and the Common Elements to prospective Buyers; and (3) to erect signs and other promotional materials upon the Condominium Property. Until Developer has conveyed the last residential Unit in the Condominium, Developer shall not be subject

to the use or other restrictions contained in any of the provisions of this Declaration and exhibits attached hereto. No representative of Developer serving on the Board shall be required to disqualify himself from voting upon any management contract, lease, or other matter involving Developer or a management company where Developer has a pecuniary interest in management company. As a Unit Owner, Developer shall not be required to disqualify itself from voting in any matter which may come before the membership of the Association, nor shall any alleged conflict of interest be a cause of partial or total invalidity of the matter voted upon, whether or not Developer's vote(s) was necessary for the adoption, ratification or execution of the same. For as long as Developer remains liable to the Condominium Association, under any warranty, whether statutory, express or implied, for any act or omission of Developer in the development, construction, sale, and marketing of the Condominium, then Developer and its agents shall have the right, in Developer's sole and absolute discretion, from time to time to enter the Condominium Property for the purpose of inspecting, testing, and surveying same, to determine the need for repairs, improvements, or replacements, so as to permit Developer to fulfill its obligations under such warranties. Failure of the Condominium Association or of a Unit Owner to grant such access may result in the appropriate warranty being nullified and of no further force or effect.

**20.4 Governing Law:** Should any dispute or litigation arise between any of the parties whose rights or duties are affected or determined by this Declaration, the exhibits annexed hereto or the rules and regulations, such dispute or litigation shall be governed by the laws of the State of Florida and all litigation shall originate in the appropriate court in Miami-Dade County, Florida.

**20.5 No Waiver:** No provisions contained in this Declaration shall be deemed to have been waived by reason of any failure to enforce the same, irrespective of the number of violations or breaches which may occur.

**20.6 Ratification:** Each Unit Owner, by reason of having acquired ownership (whether by purchase, gift, operation of law, or otherwise) shall be deemed to have agreed that all the provisions of this Declaration, and the exhibits attached hereto, as they maybe amended, are fair and reasonable in all material respects.

**20.7 Severability:** In the event that any of the terms, provisions or covenants of this Declaration are held to be invalid or unenforceable for any reason whatsoever, such holding shall not affect, alter, modify or impair in any manner any of the other terms, provisions or covenants hereof or the remaining portions of any terms, provisions or covenants.

**20.8 Interpretation of Content:** Whenever the context so requires, the use of any gender shall be deemed to include all genders, and the use of the singular shall include the plural, and plural shall include the singular. The provisions of this Declaration shall be liberally construed to effectuate its purpose of creating a uniform plan for the operation of the Condominium.

**20.9 Captions:** The captions in this Declaration and exhibits annexed hereto are inserted solely as a matter of convenience and shall not be used in construing the effect of meaning of any of the text of this Declaration or exhibits.

**20.10 Notices:** Unless otherwise provided, whenever notices are required to be sent hereunder, the same may be delivered to Unit Owners, either personally or by mail, addressed to such Unit Owners at their places of residence in the Condominium Property. Proof of such mailing or personal delivery by the Association shall be given by the affidavit of the person mailing or delivering said notices. Notices to the Association shall be sent by certified mail, return receipt requested, to the office of the Association as may be designated from time to time. All notices shall be deemed given when mailed. Any party may change his mailing address by written notice duly received for. Notices required to be given to the personal representative of a deceased owner, or devisee when there is no a personal representative, may be delivered either personally or by mail to such party at his or its address appearing in the records of the court wherein the estate of such deceased owner is being administered.

20512PG1098

**20.11 Condominium Association:** The affairs of the Condominium Association shall be governed by a Board of Administration consisting of three (3) persons, at least two (2) of whom shall be members of the Condominium Association.

IN WITNESS WHEREOF, the Developer has executed this Declaration of Condominium this 2<sup>nd</sup> day of JULY, 2002.

Signed, Sealed and Delivered  
in the presence of:

Signature - Witness #1

OSCAR R. RIVERA

Print Name - Witness #1

Signature - Witness #2

Print Name - Witness #2

CENTURY PARK AT FLAGLER, LTD.  
BY: CBG MANAGEMENT CORPORATION  
its sole general partner


BY: Cesario E. Llano  
NAME: CESARIO E. LLANO  
TITLE: VICE PRESIDENT

STATE OF FLORIDA  
COUNTY MIAMI-DADE

The foregoing instrument was acknowledged before me this 2<sup>nd</sup> day of JULY, 2002 by CESARIO E. LLANO, who is personally known to me and who executed the foregoing instrument in behalf of said Corporation.

NOTARY PUBLIC, STATE OF FLORIDA

My Commission No. is:  
My Commission Expires:

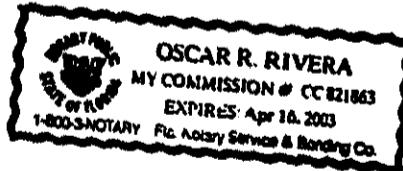

CONSENT OF MORTGAGEE

We, the undersigned, Colonial Bank, an Alabama banking corporation, a state banking corporation and holder of that certain Mortgage recorded the 29<sup>th</sup> day of July, 1999 in Official Records Book 18715, at Page 1954, of the Public Records of Miami-Dade County Public Records, and further modified by that certain Modification of Mortgage and Future Advance Agreement recorded in Official Records Book 18882, Page 1845 of the Public Records of Miami-Dade County, encumbering the real property described in Section A of this Declaration (the Condominium Property), DO HEREBY CONSENT to and do hereby join in the filing of this Declaration of Condominium of CENTURY PARK CONDOMINIUM No.2, A CONDOMINIUM.

It is specifically understood, however, that by such joinder, the said state banking corporation, incur no personal liability or responsibility of any nature whatsoever, but are merely joining in this Declaration of Condominium to acknowledge that the recording of such document among the Public Records of Miami-Dade County, Florida is satisfactory to them.

This Consent of Mortgagee is executed at Miami, Miami-Dade County, Florida, this 8 day of July, 2002.

Signed, Sealed and Delivered  
in the presence of:

Signature - Witness #1

SARA L FONSECA

Print Name - Witness #1

Signature - Witness #2

Print Name - Witness #2

COLONIAL BANK, a state  
banking corporation

By:

Carlos A. Martinez


Print Name: Carlos A. Martinez

Print Title: Vice President

STATE OF FLORIDA  
COUNTY OF MIAMI-DADE

The foregoing instrument was acknowledged before me by CARLOS A. MARTINEZ as  
VICE PRESIDENT of Colonial Bank who is personally known to me this 8<sup>th</sup> day of July, 2002.

NOTARY PUBLIC  
STATE OF FLORIDA  
My Commission Expires:

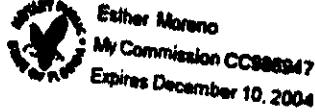

Esther Moreno  
My Commission CC888847  
Expires December 10, 2004

H1LIBRARYCASESW074120201631H20996 WPD

20512PG1100

**EXHIBIT "A"**  
**LEGAL DESCRIPTION**

20512PG1101

A portion of Tract "A" of "CENTURY PARK" according to the plat thereof as recorded in Plat Book 157 Page 19 of the Public Records of Miami-Dade County, Florida being more particularly described as follows:

Commence at the Northwest corner of said Tract "A"; thence S00deg24min34secW along the West line of said Tract "A", for a distance of 591.02 feet to the POINT OF BEGINNING of the herein described parcel; thence continue S00deg24min34secW for a distance of 190.12 feet; thence N89deg54min58secE for a distance of 70.00 feet; thence S00deg24min34secW for a distance of 5.74 feet; thence N89deg54min58secE for a distance of 18.00 feet; thence N00deg24min34secE for a distance of 1.45 feet to a Reference Point "A"; thence continue N00deg24min34secE for a distance of 99.61 feet; thence N89deg52min27secE for a distance of 75.74 feet; thence N00deg07min33secW for a distance of 95.00 feet; thence S89deg52min27secW for a distance of 162.98 feet to the POINT OF BEGINNING.

TOGETHER WITH

Commence at Reference Point "A"; thence N89deg54min58secE for a distance of 22.05 feet to the POINT OF BEGINNING "A" of the herein described parcel; thence continue N89deg54min58secE for a distance of 35.57 feet; thence N00deg05min02secW for a distance of 18.00 feet; thence S89deg54min58secW for a distance of 4.35 feet to Reference Point "B"; thence continue S89deg54min58secW for a distance of 21.15 feet to a point of curve; thence Southwesterly along the arc of said curve to the left, concave to the Southeast, having a central angle of 89deg30min24sec and a radius of 10.00 feet for an arc distance of 15.62 feet to a point of tangency; thence S00deg24min34secW for a distance of 8.09 feet to the POINT OF BEGINNING "A".

TOGETHER WITH

Commence at Reference Point "B"; thence N00deg05min02secW for a distance of 42.00 feet to the POINT OF BEGINNING "B"; thence S89deg54min58secW for a distance of 19.54 feet to a point of curve; thence Northeasterly along the arc of said curve to the right, concave to the Northeast, having a central angle of 108deg43min30sec and a radius of 10.00 feet for an arc distance of 18.98 feet to a point of compound curvature; thence Northwesterly, Northerly and Northeasterly along the arc of said curve to the right, concave to the Southeast, having a central angle of 67deg25min02sec and a radius of 38.00 feet for an arc distance of 42.36 feet to a non tangent point; thence S00deg05min02secE for a distance of 19.57 feet; thence S89deg54min58secW for a distance of 5.67 feet; thence S00deg05min02secE for a distance of 18.00 feet to the POINT OF BEGINNING "B".

**EXHIBIT "A"**

1 of 23

20512PG1102

A portion of Tract "A" of "CENTURY PARK" according to the plat thereof as recorded in Plat Book 157 Page 19 of the Public Records of Miami-Dade County, Florida being more particularly described as follows:

Commence at the Northwest corner of said Tract "A"; thence S00deg24min34secW along the West line of said Tract "A", for a distance of 591.02 feet; thence N89deg52min27secE for a distance of 162.98 feet to the POINT OF BEGINNING of the herein described parcel; thence continue N89deg52min27secE for a distance of 102.01 feet; thence S00deg05min02secE for a distance of 95.00 feet; thence S09deg52min27secW for a distance of 101.94 feet; thence N00deg07min33secE for a distance of 95.00 feet to the POINT OF BEGINNING.

EXHIBIT "A"

2 of 23

20512PG1103

A portion of Tract "A" of "CENTURY PARK" according to the plat thereof as recorded in Plat Book 157 Page 19 of the Public Records of Miami-Dade County, Florida being more particularly described as follows:

Commence at the Northwest corner of said Tract "A"; thence S00deg24min34secW along the West line of said Tract "A", for a distance of 591.02 feet; thence N89deg52min27secE for a distance of 264.99 feet to the POINT OF BEGINNING of the herein described parcel; thence continue N89deg52min27secE for a distance of 93.38 feet; thence S01deg50min39secW for a distance of 5.39 feet; thence S02deg28min21secW for a distance of 12.59 feet; thence S01deg32min42secW for a distance of 20.18 feet; thence S00deg23min09secW for a distance of 21.01 feet; thence S00deg05min02secE for a distance of 163.26 feet to a point of curve; thence Southwesterly along the arc of said curve to the right, concave to the Northwest, having a central angle of 45deg00min00sec and a radius of 22.00 feet for an arc distance of 17.28 feet to a point of tangency; thence S44deg54min58secW for a distance of 103.99 feet to a point of curve; thence Southwesterly along the arc of said curve to the right, concave to the Northwest, having a central angle of 24deg12min47sec and a radius of 24.00 feet for an arc distance of 10.14 feet to a non tangent point; thence S00deg05min02secE for a distance of 13.56 feet; thence S89deg54min58secW for a distance of 124.87 feet to a point of curve; thence Northwesterly along the arc of said curve to the right, concave to the Northeast, having a central angle of 90deg29min36sec and a radius of 36.00 feet for an arc distance of 56.86 feet to a point of tangency; thence N00deg24min34secE for a distance of 27.99 feet to a point of curve; thence Northeasterly along the arc of said curve to the right, concave to the Southeast, having a central angle of 89deg30min24sec and a radius of 36.00 feet for an arc distance of 56.74 feet to a point of tangency, also being the REFERENCE POINT "C"; thence N89deg54min58secE for a distance of 79.43 feet; thence N44deg54min58secE for a distance of 59.24 feet; thence N00deg05min02secE for a distance of 193.59 feet to the POINT OF BEGINNING.

TOGETHER WITH

Commence at Reference Point "C"; thence N00deg05min01secW for a distance of 22.00 feet to the POINT OF BEGINNING "C" of the herein described parcel; thence S89deg54min58secW for a distance of 25.36 feet to a point of curve; thence Northwesterly along the arc of said curve to the right, concave to the Northeast, having a central angle of 90deg29min36sec and a radius of 16.00 feet for an arc distance of 15.79 feet to a point of tangency; thence N00deg24min34secE for a distance of 7.02 feet to the REFERENCE POINT "D"; thence continue N00deg24min34secE for a distance of 1.63 feet; thence N89deg54min58secE for a distance of 35.57 feet; thence N00deg05min02secW for a distance of 18.00 feet to the REFERENCE POINT "E"; thence N89deg54min58secE for a distance of 87.47 feet to a point of curve; thence Southeasterly, Southerly and Southwesterly along the arc of said curve to the right, concave to the Southwest, having a central angle of 120deg59min37sec and a radius of 7.50 feet for an arc distance of 15.84 feet to a point of compound curvature; thence Southwesterly along the arc of said curve to the right, concave to the Northwest, having a central angle of 14deg00min23sec and a radius of 36.00 feet for an arc distance of 8.80 feet to a point of tangency; thence S44deg54min58secW for a distance of 11.19 feet to a point of curve; thence Southwesterly along the arc of said curve to the right, concave to the Northwest, having a central angle of 45deg00min00sec and a radius of 36.00 feet for an arc distance of 28.27 feet to a point of tangency; thence S89deg54min58secW for a distance of 56.41 feet to the POINT OF BEGINNING "C".

TOGETHER WITH

Commence at Reference Point "E"; thence N89deg53min23secW for a distance of 22.05 feet to the POINT OF BEGINNING "D" of the herein described parcel; thence S00deg24min34secW for a distance of 4.18 feet to a point of curve; thence Southwesterly along the arc of said curve to the right, concave to the Northwest, having a central angle of 89deg34min56sec and a radius of 8.00 feet for an arc distance of 12.51 feet to a point of tangency; thence S89deg54min58secW for a distance of 70.06 feet; thence S00deg24min34secW for a distance of 22.00 feet; thence N89deg4min58secE for a distance of 70.94 feet to a point of curve; thence Southeasterly along the arc of said curve to the right, concave to the Southwest, having a central angle of 90deg29min36sec and a radius of 7.00 feet for an arc distance of 11.06 feet to a point of tangency; thence S00deg24min34secW for a distance of 33.44 feet; thence N89deg53min00secW for a distance of 17.93 feet; thence N00deg24min34secE for a distance of 22.33 feet; thence S89deg54min58secW for a distance of 70.00 feet; thence N00deg24min34secE along the West Line of said Tract "A", for a distance of 58.00 feet; thence N89deg54min58secE for a distance of 70.00 feet; thence S00deg24min34secW for a distance of 5.74 feet; thence S89deg37min52secE for a distance of 18.00 feet to the POINT OF BEGINNING "D".

TOGETHER WITH

Commence at Reference Point "E"; thence N00deg05min01secW for a distance of 22.00 feet to the POINT OF BEGINNING "E" of the herein described parcel; thence S89deg54min58secW for a distance of 4.35 feet; thence N00deg05min02secW for a distance of 18.00 feet; thence N89deg54min58secE for a distance of 2.67 feet; thence N00deg05min02secW for a distance of 19.57 feet; thence N89deg52min27secE for a distance of 62.30 feet to a point of curve; thence Southeasterly along the arc of said curve to the right, concave to the Southwest, having a central angle of 71deg25min25sec and a radius of 36.00 feet for an arc distance of 44.66 feet to a point of compound curvature; thence Southeasterly, Southerly and Southwesterly along the arc of said curve to the right, concave to the Northwest, having a central angle of 108deg37min06sec and a radius of 10.00 feet for an arc distance of 18.96 feet to a point of tangency; thence S89deg54min58secW for a distance of 87.67 feet to the POINT OF BEGINNING "E".

**EXHIBIT A**

3 of 23

20512PG1104

A portion of Tract "A" of "CENTURY PARK" according to the plat thereof as recorded in Plat Book 157 Page 19 of the Public Records of Miami-Dade County, Florida being more particularly described as follows:

Commence at the Northwest corner of said Tract "A"; thence S00deg24min34secW along the West line of said Tract "A", for a distance of 1087.29 feet to the POINT OF BEGINNING of the herein described parcel; thence continue S00deg24min34secW for a distance of 95.04 feet; thence N89deg54min58secE for a distance of 55.25 feet; thence N44deg20min39secE for a distance of 47.20 feet; thence N00deg24min34secE for a distance of 70.98 feet to a point of curve; thence Northwesterly along the arc of said curve to the left, concave to the Southwest, having a central angle of 90deg29min36sec and a radius of 8.00 feet for an arc distance of 12.64 feet to a point of tangency; thence S89deg54min58secW for a distance of 49.09 feet; thence S00deg05min02secE for a distance of 18.00 feet; thence S89deg54min58secW for a distance of 31.00 feet to the POINT OF BEGINNING.

**EXHIBIT "A"**

4 of 23

**20512PG1105**

A portion of Tract "A" of "CENTURY PARK" according to the plat thereof as recorded in Plat Book 157 Page 19 of the Public Records of Miami-Dade County, Florida being more particularly described as follows:

Commence at the Northwest corner of said Tract "A"; thence S00deg24min34secW along the West line of said Tract "A", for a distance of 1182.05 feet to the POINT OF BEGINNING of the herein described parcel; thence N89deg54min58secE for a distance of 55.25 feet; thence N44deg20min39secE for a distance of 47.20 feet; thence S00deg05min02secE for a distance of 0.67 feet; thence N89deg54min58secE for a distance of 201.44 feet to a point of curve; thence Southeasterly along the arc of said curve to the right, concave to the Southwest, having a central angle of 65deg48min52sec and a radius of 36.00 feet for an arc distance of 41.35 feet to a point of reverse curvature; thence Southeasterly along the arc of said curve to the left, concave to the Northeast, having a central angle of 09deg57min04sec and a radius of 58.00 feet for an arc distance of 10.07 feet to a non tangent point; thence S00deg00min17secW for a distance of 25.16 feet; thence N89deg54min58secE for a distance of 34.00 feet; thence S00deg00min17secW for a distance of 43.07 feet; thence S89deg54min58secW along the South Line of said Tract "A", for a distance of 361.44 feet; thence N00deg24min34secE along the West line of said Tract "A", for a distance of 65.00 feet to the POINT OF BEGINNING.

**EXHIBIT "A"**

20512PG1106

A portion of Tract "A" of "CENTURY PARK" according to the plat thereof as recorded in Plat Book 157 Page 19 of the Public Records of Miami-Dade County, Florida being more particularly described as follows:

Commence at the Northwest corner of said Tract "A"; thence S00deg24min34secW along the West line of said Tract "A", for a distance of 1029.29 feet to the POINT OF BEGINNING of the herein described parcel; thence continue S00deg24min34secW for a distance of 56.00 feet; thence N89deg54min58secE for a distance of 31.00 feet; thence N00deg05min02secW for a distance of 4.13 feet to REFERENCE POINT "F"; thence continue N00deg05min02secW for a distance of 13.67 feet; thence S89deg54min58secW for a distance of 30.81 feet; thence N00deg24min34secE for a distance of 22.01 feet; thence N89deg54min58secE for a distance of 71.06 feet to a point of curve; thence Northeasterly along the arc of said curve to the left, concave to the Northwest, having a central angle of 80deg09min24sec and a radius of 7.00 feet for an arc distance of 9.79 feet to a non tangent point; thence N89deg37min52secW for a distance of 22.61 feet; thence N00deg24min34secE for a distance of 13.02 feet; thence S89deg54min58secW for a distance of 65.00 feet to the POINT OF BEGINNING.

TOGHETER WITH

Commence at Reference Point "F"; thence N89deg54min58secE for a distance of 79.04 feet to the POINT OF BEGINNING "F" of the herein described parcel; thence S00deg24min34secW for a distance of 7.54 feet to a point of curve; thence Southeasterly along the arc of said curve to the left, concave to the Northeast, having a central angle of 52deg04min13sec and a radius of 36.00 feet for an arc distance of 32.71 feet to a point of compound curvature; thence Southwesterly, Easterly and Northeasterly along the arc of said curve to the left, concave to the Northwest, having a central angle of 128deg25min13sec and a radius of 10.00 feet for an arc distance of 22.41 feet to a point of tangency, also being the Reference Point "G"; thence N00deg05min02secW for a distance of 35.59 feet to a point of curve; thence Northwesterly along the arc of said curve to the left, concave to the Southwest, having a central angle of 9deg30min04sec and a radius of 7.50 feet for an arc distance of 11.78 feet to a point of tangency; thence S89deg54min58secW for a distance of 7.08 feet to a point of curve; thence Southwesterly along the arc of said curve to the left, concave to the Southeast, having a central angle of 89deg30min24sec and a radius of 15.00 feet for an arc distance of 23.43 feet to the POINT OF BEGINNING "F".

TOGHETER WITH

Commence at Reference Point "G"; thence N89deg54min58secE for a distance of 21.00 feet to the POINT OF BEGINNING "G" of the herein described parcel; thence S00deg05min02secE for a distance of 9.63 feet to a point of curve; thence Southeasterly along the arc of said curve to the left, concave to the Northeast, having a central angle of 90deg00min00sec and a radius of 6.00 feet for an arc distance of 9.42 feet to a point of tangency; thence N89deg54min58secE for a distance of 29.00 feet to a point of curve; thence Northeasterly along the arc of said curve to the left, concave to the Northwest, having a central angle of 90deg00min00sec and a radius of 6.00 feet for an arc distance of 9.42 feet to a point of tangency; thence N00deg05min02secW for a distance of 46.72 feet to a point of curve, also being the Reference Point "H"; thence Northwesterly along the arc of said curve to the left, concave to the Southwest, having a central angle of 90deg00min00sec and a radius of 6.00 feet for an arc distance of 9.42 feet to a point of tangency; thence S89deg54min58secW for a distance of 29.00 feet to a point of curve; thence Southwesterly along the arc of said curve to the left, concave to the Southeast, having a central angle of 90deg00min00sec and a radius of 6.00 feet for an arc distance of 9.42 feet to a point of tangency; thence S00deg05min02secE for a distance of 37.09 feet to the POINT OF BEGINNING "G".

TOGHETER WITH

Commence at Reference Point "H"; thence N89deg54min58secE for a distance of 22.00 feet to the POINT OF BEGINNING "H" of the herein described parcel; thence S00deg05min02secE for a distance of 44.72 feet to a point of curve; thence Southeasterly along the arc of said curve to the left, concave to the Northeast, having a central angle of 90deg00min00sec and a radius of 8.00 feet for an arc distance of 12.57 feet to a point of tangency; thence N89deg54min58secE for a distance of 65.16 feet to a point of curve; thence Northeasterly along the arc of said curve to the left, concave to the Northwest, having a central angle of 90deg00min00sec and a radius of 20.00 feet for an arc distance of 31.42 feet to a point of tangency; thence N00deg05min02secW for a distance of 127.70 feet to a point of curve; thence Northwesterly along the arc of said curve to the left, concave to the Southwest, having a central angle of 41deg48min40sec and a radius of 36.00 feet for an arc distance of 26.27 feet to a non tangent point; thence S89deg54min58secW for a distance of 34.19 feet; thence N00deg05min02secW for a distance of 12.00 feet; thence S89deg54min58secW for a distance of 125.68 feet to a point of curve; thence Southwesterly along the arc of said curve to the left, concave to the Southeast, having a central angle of 89deg30min24sec and a radius of 36.00 feet for an arc distance of 56.24 feet to a point of tangency; thence S00deg24min34secW for a distance of 52.87 feet to a point of curve; thence Southeasterly along the arc of said curve to the left, concave to the Northeast, having a central angle of 90deg29min36sec and a radius of 15.00 feet for an arc distance of 23.69 feet to a point of tangency; thence N89deg54min58secE for a distance of 97.35 feet; thence S00deg05min02secE for a distance of 26.00 feet to the POINT OF BEGINNING "H".

EXHIBIT "A"

6 of 23

**20512PG1107**

A portion of Tract "A" of "CENTURY PARK" according to the plat thereof as recorded in Plat Book 157 Page 19 of the Public Records of Miami-Dade County, Florida being more particularly described as follows:

Commence at the Northwest corner of said Tract "A"; thence S00deg24min34secW along the West line of said Tract "A", for a distance of 1247.05 feet; thence N89deg54min58secE along the South line of said Tract "A", for a distance of 375.57 feet; thence N00deg05min02secW for a distance of 65.07 to the POINT OF BEGINNING of the herein described parcel; thence N89deg54min58secE for a distance of 66.61 feet to a point of curve; thence Northeasterly along the arc of said curve to the left, concave to the Northwest, having a central angle of 90deg00min00sec and a radius of 36.00 feet for an arc distance of 56.55 feet to a point of tangency; thence N00deg05min02secW for a distance of 70.93 feet to a point of curve; thence Northwesterly along the arc of said curve to the left, concave to the Southwest, having a central angle of 90deg00min00sec and a radius of 7.50 feet for an arc distance of 11.78 feet to a point of tangency; thence S89deg54min58secW for a distance of 123.61 feet to a point of curve; thence Southwesterly along the arc of said curve to the left, concave to the Southeast, having a central angle of 90deg00min00sec and a radius of 7.50 feet for an arc distance of 11.78 feet to a point of tangency; thence S00deg05min02secE for a distance of 70.93 feet to a point of curve; thence Southeasterly along the arc of said curve to the left, concave to the Northeast, having a central angle of 90deg00min00sec and a radius of 36.00 feet for an arc distance of 56.55 feet to the POINT OF BEGINNING.

**EXHIBIT "A"**

7 OF 23

## 20512PG1108

A portion of Tract "A" of "CENTURY PARK" according to the plat thereof as recorded in Plat Book 157 Page 19 of the Public Records of Miami-Dade County, Florida being more particularly described as follows:

Commence at the Northwest corner of said Tract "A"; thence S00deg24min34secW along the West Line of said Tract "A", for a distance of 1347.05 feet; thence N89deg54min58secE along the South Line of said Tract "A", for a distance of 361.44 feet to the POINT OF BEGINNING of the herein described parcel; thence continue N89deg54min58secE for a distance of 127.50 feet; thence N00deg00min17secE for a distance of 43.07 feet to REFERENCE POINT "I"; thence S89deg54min58secW for a distance of 177.50 feet; thence S00deg00min17secW for a distance of 43.07 feet to the POINT OF BEGINNING.

## TOGHETER WITH

Commence at Reference Point "I"; thence N00deg00min17secE for a distance of 112.97 feet; thence N89deg54min58secE for a distance of 10.78 feet to the POINT OF BEGINNING "I" of the herein described parcel; thence N00deg05min02secW for a distance of 167.72 feet to a point of curve; thence Northeastly along the arc of said curve to the right, concave to the Southeast, having a central angle of 41deg48min47sec and a radius of 36.00 feet for an arc distance of 26.27 feet to a non tangent point; thence N89deg54min58secE for a distance of 187.89 feet to a non tangent point on a curve, said point bears S18deg06min18secW to center of the curve; thence Southeasterly along the arc of said curve to the right, concave to the Southwest, having a central angle of 41deg49min11sec and a radius of 36.00 feet for an arc distance of 26.28 feet to a point of tangency; thence S00deg05min02secE for a distance of 49.98 feet to a point of curve; thence Southwesterly along the arc of said curve to the right, concave to the Northwest, having a central angle of 84deg59min24sec and a radius of 15.00 feet for an arc distance of 23.56 feet to a point of tangency; thence S89deg54min21secW for a distance of 95.08 feet; thence S00deg05min02secE for a distance of 28.99 feet to the Reference Point "J"; thence continue S00deg05min02secE for a distance of 41.72 feet to a point of curve; thence Southwesterly along the arc of said curve to the right, concave to the Northwest, having a central angle of 90deg00min00sec and a radius of 8.00 feet for an arc distance of 11.87 feet to a point of tangency; thence S89deg54min58secW for a distance of 52.15 feet to a point of curve; thence Northwesterly along the arc of said curve to the right, concave to the Northeast, having a central angle of 90deg00min00sec and a radius of 36.00 feet for an arc distance of 56.45 feet to the POINT OF BEGINNING "I".

## TOGHETER WITH

Commence at Reference Point "J"; thence N89deg54min58secE for a distance of 32.00 feet to the POINT OF BEGINNING "J" of the herein described parcel; thence S00deg05min02secE for a distance of 40.72 feet to a point of curve; thence Southeasterly along the arc of said curve to the left, concave to the Northeast, having a central angle of 90deg00min00sec and a radius of 7.00 feet for an arc distance of 11.00 feet to a point of tangency; thence N89deg54min58secE for a distance of 37.00 feet to a point of curve; thence Northeastly along the arc of said curve to the left, concave to the Northwest, having a central angle of 90deg00min00sec and a radius of 7.00 feet for an arc distance of 11.00 feet to a point of tangency; thence N00deg05min02secW for a distance of 13.87 feet to the Reference Point "K"; thence continue N00deg05min02secW for a distance of 28.85 feet a point of curve; thence Northwesterly along the arc of said curve to the left, concave to the Southwest, having a central angle of 90deg00min36sec and a radius of 7.00 feet for an arc distance of 11.00 feet to a point of tangency; thence S89deg54min22secW for a distance of 27.00 feet to a point of curve; thence Southwesterly along the arc of said curve to the left, concave to the Southeast, having a central angle of 89deg59min24sec and a radius of 7.00 feet for an arc distance of 10.99 feet to the POINT OF BEGINNING "J".

## TOGHETER WITH

Commence at Reference Point "K"; thence N89deg54min58secE for a distance of 21.00 feet to the POINT OF BEGINNING "K" of the herein described parcel; thence N00deg05min02secW for a distance of 28.36 feet to a point of curve; thence Northeasterly along the arc of said curve to the right, concave to the Southeast, having a central angle of 89deg59min24sec and a radius of 7.50 feet for an arc distance of 11.78 feet to a point of tangency; thence N89deg54min22secE for a distance of 7.26 feet to a point of curve; thence Southeasterly along the arc of said curve to the right, concave to the Southwest, having a central angle of 89deg31min00sec and a radius of 10.00 feet for an arc distance of 15.62 feet to a point of tangency; thence S00deg34min38secE for a distance of 10.51 feet to a point of curve; thence Southwesterly along the arc of said curve to the right, concave to the Northeast, having a central angle of 36deg04min46sec and a radius of 36.00 feet for an arc distance of 22.67 feet to a point of compound curvature; thence Southwesterly, Westerly and Northwesterly, along the arc of said curve to the right, concave to the Northeast, having a central angle of 144deg24min50sec and a radius of 10.00 feet for an arc distance of 25.20 feet to the POINT OF BEGINNING "K".

**EXHIBIT "A"**

8 of 23

20512PG1109

A portion of Tract "A" of "CENTURY PARK" according to the plat thereof as recorded in Plat Book 157 Page 19 of the Public Records of Miami-Dade County, Florida being more particularly described as follows:

Commence at the Northwest corner of said Tract "A"; thence S00deg24min34secW along the West line of said Tract "A", for a distance of 591.02 feet; thence N89deg52min27secE for a distance of 444.94 feet to the POINT OF BEGINNING of the herein described parcel; thence continue N89deg52min27secE for a distance of 123.04 feet; thence S00deg05min02secE for a distance of 10.02 feet; thence S89deg54min58secW for a distance of 21.00 feet; thence S00deg05min02secE for a distance of 183.11 feet; thence S45deg05min02secE for a distance of 55.45 feet; thence N89deg54min58secE for a distance of 80.87 feet to a point of curve, also being the REFERENCE POINT "L"; thence Southeasterly along the arc of said curve to the right, concave to the Southwest, having a central angle of 90deg00min24sec and a radius of 36.00 feet for an arc distance of 56.55 feet to a point of tangency; thence S00deg05min02secE for a distance of 35.33 feet to a point of curve; thence Southwesterly along the arc of said curve to the right, concave to the Northwest, having a central angle of 32deg13min51sec and a radius of 15.00 feet for an arc distance of 6.44 feet to a non tangent point; thence S89deg54min58secW for a distance of 160.22 feet to a point of curves; thence Northwesterly along the arc of said curve to the right, concave to the Northeast, having a central angle of 45deg00min00sec and a radius of 25.00 feet for an arc distance of 19.63 feet to a point of tangency; thence N45deg05min02secW for a distance of 93.63 feet to a point of curve; thence Northwesterly along the arc of said curve to the right, concave to the Northeast, having a central angle of 45deg00min00sec and a radius of 22.00 feet for an arc distance of 17.28 feet to a point of tangency; thence N00deg05min02secW for a distance of 162.96 feet to a point of curves; thence Northwesterly along the arc of said curve to the left, concave to the Southwest, having a central angle of 06deg44min52sec and a radius of 446.25 feet for an arc distance of 52.56 feet to a point of compound curvature; thence Northwesterly along the arc of said curve to the left, concave to the Southwest, having a central angle of 06deg09min42sec and a radius of 67.00 feet for an arc distance of 7.21 feet to the POINT OF BEGINNING.

TOGETHER WITH

Commence at Reference Point "L"; thence N00deg05min02secW for a distance of 22.00 feet to the POINT OF BEGINNING "L" of the herein described parcel; thence S89deg54min58secW for a distance of 56.55 feet to a point of curve; thence Northwesterly along the arc of said curve to the right, concave to the Northeast, having a central angle of 45deg00min00sec and a radius of 36.00 feet for an arc distance of 28.27 feet to a point of tangency; thence N45deg05min02secW for a distance of 7.40 feet to a point of curves; thence Northwesterly along the arc of said curve to the right, concave to the Northeast, having a central angle of 18deg27min31sec and a radius of 36.00 feet for an arc distance of 11.60 feet to a point of compound curvature; thence Northwesterly, Northerly and Northeasterly along the arc of said curve to the right, concave to the Southeast, having a central angle of 116deg32min29sec and a radius of 7.50 feet for an arc distance of 15.36 feet to a point of tangency, also being the REFERENCE POINT "M"; thence N89deg54min58secE for a distance of 113.59 feet to a point of curve; thence Southeasterly along the arc of said curve to the right, concave to the Southwest, having a central angle of 90deg00min00sec and a radius of 10.00 feet for an arc distance of 15.71 feet to a point of tangency; thence S00deg05min02secE for a distance of 16.00 feet to a point of curve; thence Southwesterly along the arc of said curve to the right, concave to the Northwest, having a central angle of 90deg00min00sec and a radius of 10.00 feet for an arc distance of 15.71 feet to a point of tangency; thence S89deg54min58secW for a distance of 26.00 feet to the POINT OF BEGINNING "L".

TOGETHER WITH

Commence at Reference Point "M"; thence N00deg05min02secW for a distance of 22.00 feet to the POINT OF BEGINNING "M" of the herein described parcel; thence S89deg54min58secW for a distance of 2.00 feet to a point of curve; thence Northwesterly along the arc of said curve to the right, concave to the Northeast, having a central angle of 105deg15min27sec and a radius of 7.50 feet for an arc distance of 13.78 feet to a point of compound curvature; thence Northeasterly along the arc of said curve to the right, concave to the Southeast, having a central angle of 74deg45min00sec and a radius of 36.00 feet for an arc distance of 46.97 feet to a point of tangency; thence N89deg54min58secE for a distance of 62.08 feet to a point of curve; thence Southeasterly along the arc of said curve to the right, concave to the Southwest, having a central angle of 67deg23min11sec and a radius of 36.00 feet for an arc distance of 42.34 feet to a point of compound curvature; thence Southeasterly, Southerly and Southwesterly along the arc of said curve to the right, concave to the Northwest, having a central angle of 112deg37min12sec and a radius of 10.00 feet for an arc distance of 19.66 feet to a point of tangency; thence S89deg54min58secW for a distance of 111.59 feet to the POINT OF BEGINNING "M".

**EXHIBIT "A"**

9 of 23

20512PG1110

A portion of Tract "A" of "CENTURY PARK" according to the plat thereof as recorded in Plat Book 157 Page 19 of the Public Records of Miami-Dade County, Florida being more particularly described as follows:

Commence at the Northwest corner of said Tract "A"; thence S00deg24min34secW along the West line of said Tract "A", for a distance of 591.02 feet; thence N89deg52min27secE for a distance of 568.03 feet to the POINT OF BEGINNING of the herein described parcel; thence continue N89deg52min27secE for a distance of 134.09 feet; thence S00deg05min02secE for a distance of 88.43 feet to a point of curve; thence Southwesterly along the arc of said curve to the right, concave to the Northwest, having a central angle of 90deg00min00sec and a radius of 6.00 feet for an arc distance of 9.42 feet to a point of tangency; thence S89deg54min58secW for a distance of 122.09 feet to a point of curve; thence Northwesterly along the arc of said curve to the right, concave to the Northeast, having a central angle of 90deg00min00sec and a radius of 6.00 feet for an arc distance of 9.42 feet to a point of tangency; thence N00deg05min02secW for a distance of 88.33 feet to the POINT OF BEGINNING.

**EXHIBIT "A"**

20512PG!!!!

A portion of Tract "A" of "CENTURY PARK" according to the plat thereof as recorded in Plat Book 157 Page 19 of the Public Records of Miami-Dade County, Florida being more particularly described as follows:

Commence at the Northwest corner of said Tract "A"; thence S00deg24min34secW along the West line of said Tract "A", for a distance of 591.02 feet; thence N89deg52min27secE for a distance of 702.12 feet to the POINT OF BEGINNING of the herein described parcel; thence continue N89deg52min27secE for a distance of 110.04 feet; thence S00deg07min06secE for a distance of 153.34 feet; thence S89deg54min58secW for a distance of 3.72 feet; thence S00deg05min02secE for a distance of 10.00 feet; thence S89deg54min58secW for a distance of 77.42 to a point of curve; thence Northwesterly along the arc of said curve to the right, concave to the Northeast, having a central angle of 90deg00min00sec and a radius of 8.00 feet for an arc distance of 12.57 feet to a point of tangency; thence N00deg05min02secW for a distance of 153.28 feet; thence S89deg53min27secW for a distance of 22.00 feet; thence N00deg05min02secW for a distance of 10.00 feet to the POINT OF BEGINNING.

EXHIBIT "A"

11 OF 23

20512PG1112

A portion of Tract "A" of "CENTURY PARK" according to the plat thereof as recorded in Plat Book 157 Page 19 of the Public Records of Miami-Dade County, Florida being more particularly described as follows:

Commence at the Northwest corner of said Tract "A"; thence S00deg24min34secW along the West line of said Tract "A", for a distance of 591.02 feet; thence N89deg52min27secE for a distance of 812.16 feet; thence S00deg07min06secE for a distance of 153.34 feet; thence N89deg54min58secE for a distance of 31.28 feet; thence S00deg05min02secE for a distance of 40.00 feet to the POINT OF BEGINNING of the herein described parcel; thence N89deg54min58secE for a distance of 47.00 feet to a point of curve; thence Southeasterly along the arc of said curve to the right, concave to the Southwest, having a central angle of 90deg00min00sec and a radius of 10.00 feet for an arc distance of 15.71 feet to a point of tangency; thence S00deg05min02secE for a distance of 65.00 feet to a point of curve; thence Southwesterly along the arc of said curve to the right, concave to the Northwest, having a central angle of 90deg00min00sec and a radius of 36.00 feet for an arc distance of 56.55 feet to a point of tangency; thence S89deg54min58secW for a distance of 104.42 feet to a point of curve; thence Northwesterly along the arc of said curve to the right, concave to the Northeast, having a central angle of 90deg00min00sec and a radius of 36.00 feet for an arc distance of 56.55 feet to a point of tangency; thence N00deg05min02secW for a distance of 65.00 feet to a point of curve; thence Northeasterly along the arc of said curve to the right, concave to the Southeast, having a central angle of 90deg00min00sec and a radius of 10.00 feet for an arc distance of 15.71 feet to a point of tangency; thence N89deg54min58secE for a distance of 109.42 feet to the POINT OF BEGINNING.

EXHIBIT "A"

12 OF 23

20512PG1113

A portion of Tract "A" of "CENTURY PARK" according to the plat thereof as recorded in Plat Book 157 Page 19 of the Public Records of Miami-Dade County, Florida being more particularly described as follows:

Commence at the Northwest corner of said Tract "A"; thence 300deg24min34secW along the West line of said Tract "A", for a distance of 1247.05 feet; thence N89deg54min58secE along the South line of said Tract "A", for a distance of 816.90 feet; thence N00deg05min00secW for a distance of 129.76 feet; thence S89deg54min58secW for a distance of 2.21 feet to the POINT OF BEGINNING of the herein described parcel; thence continue S89deg54min58secW for a distance of 63.50 feet; thence S00deg05min02secE for a distance of 8.84 feet; thence S89deg54min58secW for a distance of 23.00 feet; thence N00deg05min02secW for a distance of 20.84 feet to a point of curve; thence Northeasterly along the arc of said curve to the right, concave to the Southeast, having a central angle of 90deg00min00sec and a radius of 10.00 feet for an arc distance of 15.71 feet to a point of tangency; thence N89deg54min58secE for a distance of 76.50 feet to the REFERENCE POINT "N"; thence S00deg05min02secE for a distance of 22.00 feet to the POINT OF BEGINNING.

TOGHETER WITH

Commence at Reference Point "N"; thence N00deg05min02secW for a distance of 22.00 feet to the POINT OF BEGINNING "N" of the herein described parcel; thence S89deg54min58secW for a distance of 79.00 feet to a point of curve; thence Northwesterly along the arc of said curve to the right, concave to the Northeast, having a central angle of 90deg00min00sec and a radius of 7.50 feet for an arc distance of 11.78 feet to a point of tangency; thence N00deg05min02secW for a distance of 67.50 feet to a point of curve; thence Northeasterly along the arc of said curve to the right, concave to the Southeast, having a central angle of 90deg00min00sec and a radius of 36.00 feet for an arc distance of 56.55 feet to a point of tangency; thence N89deg54min58secE for a distance of 106.00 feet to a point of curve; thence Southeasterly along the arc of said curve to the right, concave to the Southwest, having a central angle of 90deg00min00sec and a radius of 36.00 feet for an arc distance of 56.55 feet to a point of tangency; thence S00deg05min02secE for a distance of 67.50 feet to a point of curve; thence Southwesterly along the arc of said curve to the right, concave to the Northwest, having a central angle of 90deg00min00sec and a radius of 7.50 feet for an arc distance of 11.78 feet to a point of tangency; thence S89deg54min58secW for a distance of 84.00 feet to the POINT OF BEGINNING "N"

EXHIBIT "A"

20512PG1114

A portion of Tract "A" of "CENTURY PARK" according to the plat thereof as recorded in Plat Book 157 Page 19 of the Public Records of Miami-Dade County, Florida being more particularly described as follows:

Commence at the Northwest corner of said Tract "A"; thence S00deg24min34secW along the West line of said Tract "A", for a distance of 1247.05 feet; thence N89deg54min58secE along the South line of said Tract "A", for a distance of 735.69 feet to the POINT OF BEGINNING of the herein described parcel; thence continue N89deg54min58secE for a distance of 81.21 feet; thence N00deg05min02secW for a distance of 129.76 feet; thence S89deg54min58secW for a distance of 65.71 feet; thence S00deg05min02secE for a distance of 8.84 feet; thence S89deg54min58secW for a distance of 23.00 feet; thence S00deg05min02secE for a distance of 98.92 feet to a point of curve; thence Southeasterly along the arc of said curve to the left, concave to the Northeast, having a central angle of 37deg40min12sec and a radius of 36.00 feet for an arc distance of 23.67 feet to the POINT OF BEGINNING.

EXHIBIT "A"

20512PG1115

A portion of Tract "A" of "CENTURY PARK" according to the plat thereof as recorded in Plat Book 157 Page 19 of the Public Records of Miami-Dade County, Florida being more particularly described as follows:

Commence at the Northwest corner of said Tract "A"; thence S00deg24min34secW along the West line of said Tract "A", for a distance of 1247.05 feet; thence N89deg54min58secE along the South Line of said Tract "A", for a distance of 489.16 feet to the POINT OF BEGINNING of the herein described parcel; thence continue N89deg54min58secE for a distance of 209.74 feet to a non tangent point, said point bears N52deg24min50secW to center of the curve; thence Northwesterly along the arc of said curve to the left, concave to the Northwest, having a central angle of 37deg40min12sec and a radius of 36.00 feet for an arc distance of 23.67 feet to a point of tangency; thence N00deg05min02secW for a distance of 40.04 feet to a point of curve; thence Northwesterly along the arc of said curve to the left, concave to the Southwest, having a central angle of 90deg00min00sec and a radius of 36.00 feet for an arc distance of 56.55 feet to a point of tangency; thence S89deg54min58secW for a distance of 142.71 feet to a point of curve; thence Southwesterly along the arc of said curve to the left, concave to the Southeast, having a central angle of 62deg28min04sec and a radius of 36.00 feet for an arc distance of 41.13 feet to a point of reverse curvature; thence Southwesterly along the arc of said curve to the right, concave to the Northwest, having a central angle of 11deg11min48sec and a radius of 58.00 feet for an arc distance of 11.33 feet to a non tangent point; thence S00deg00min17secW for a distance of 67.20 feet to the POINT OF BEGINNING.

EXHIBIT "A"

20512PG1116

A portion of Tract "A" of "CENTURY PARK" according to the plat thereof as recorded in Plat Book 157 Page 19 of the Public Records of Miami-Dade County, Florida being more particularly described as follows:

Commence at the Northwest corner of said Tract "A"; thence S00deg24min34secW along the West line of said Tract "A", for a distance of 1247.05 feet; thence N89deg54min58secE along the South Line of said Tract "A", for a distance of 816.90 feet to the POINT OF BEGINNING of the herein described parcel; thence continue N89deg54min58secE for a distance of 229.10 feet to a point of curve; thence Northeasterly along the arc of said curve to the left, concave to the Northwest, having a central angle of 90deg00min00sec and a radius of 25.00 feet for an arc distance of 39.27 feet to a point of tangency; thence N00deg05min02secW for a distance of 37.80 feet to a point of curve; thence Northwesterly along the arc of said curve to the left, concave to the Southwest, having a central angle of 89deg47min53sec and a radius of 11.97 feet for an arc distance of 18.76 feet to a point of tangency; thence N89deg52min55secW for a distance of 6.97 feet; thence N00deg10min13secW for a distance of 21.95 feet to a non tangent point in a curve, said point bears S12deg57min21secW to center of the curve; thence Northwesterly along the arc of said curve to the left, concave to the Southwest, having a central angle of 12deg57min23sec and a radius of 36.00 feet for an arc distance of 8.14 feet to a point of tangency; thence S89deg54min58secW for a distance of 137.81 feet; thence N00deg05min02secW for a distance of 44.10 feet to a point of curve; thence Northwesterly along the arc of said curve to the left, concave to the Southwest, having a central angle of 90deg00min00sec and a radius of 10.00 feet for an arc distance of 15.71 feet to a point of tangency; thence S89deg54min58secW for a distance of 81.50 feet; thence S00deg05min02secE for a distance of 22.00 feet; thence N89deg54min58secE for a distance of 2.21 feet; thence S00deg05min02secE for a distance of 129.76 feet to the POINT OF BEGINNING.

EXHIBIT A

20512PG1117

A portion of Tract "A" of "CENTURY PARK" according to the plat thereof as recorded in Plat Book 157 Page 19 of the Public Records of Miami-Dade County, Florida being more particularly described as follows:

Commence at the Northwest corner of said Tract "A"; thence S00deg24min34secW along the West line of said Tract "A", for a distance of 1247.05 feet; thence N89deg54min58secE along the South line of said Tract "A", for a distance of 1046.00 feet to a point of curve; thence Northeasterly along the arc of said curve to the left, concave to the Northwest, having a central angle of 90deg00min00sec and a radius of 25.00 feet for an arc distance of 39.27 feet to a point of tangency; thence N00deg05min02secW for a distance of 37.80 feet to a point of curve; thence Northwesterly along the arc of said curve to the left, concave to the Southwest, having a central angle of 89deg47min53sec and a radius of 11.97 feet for an arc distance of 18.76 feet to a point of tangency; thence N89deg52min55secW for a distance of 6.97 feet; thence N00deg10min13secW for a distance of 44.87 feet to the POINT OF BEGINNING of the herein described parcel; thence S89deg54min58secW for a distance of 49.04 feet to a point of curve; thence Northwesterly along the arc of said curve to the right, concave to the Northeast, having a central angle of 90deg00min00sec and a radius of 15.00 feet for an arc distance of 23.56 feet to a point of tangency; thence N00deg05min02secW for a distance of 34.10 feet to the REFERENCE POINT "O"; thence continue N00deg05min02secW for a distance of 30.00 feet thence S89deg54min58secW for a distance of 44.81 feet to a point of curve; thence Northwesterly along the arc of said curve to the right, concave to the Northeast, having a central angle of 90deg00min00sec and a radius of 15.00 feet for an arc distance of 23.56 feet to a point of tangency; thence N00deg05min02secW for a distance of 49.00 feet; thence N89deg54min58secE for a distance of 12.00 feet; thence N00deg05min02secW for a distance of 10.00 feet to a point of curve; thence Northeasterly along the arc of said curve to the right, concave to the Southeast, having a central angle of 90deg00min00sec and a radius of 15.00 feet for an arc distance of 23.56 feet to a point of tangency; thence N89deg54min58secE for a distance of 74.26 feet to a point of curve; thence Southeasterly along the arc of said curve to the right, concave to the Southwest, having a central angle of 45deg00min00sec and a radius of 24.00 feet for an arc distance of 18.85 feet to a point of tangency; thence S45deg05min02secE for a distance of 33.32 feet to a point of curve; thence Southeasterly along the arc of said curve to the right, concave to the Southwest, having a central angle of 45deg00min00sec and a radius of 24.00 feet for an arc distance of 18.85 feet to a point of tangency; thence S00deg05min02secE for a distance of 95.83 feet; thence Southwesterly along the arc of said curve to the right, concave to the Northwest, having a central angle of 90deg00min00sec and a radius of 12.50 feet for an arc distance of 19.63 feet to a point of tangency; thence S89deg54min58secW for a distance of 12.48 feet; thence S00deg10min13secE for a distance of 12.22 feet to the POINT OF BEGINNING.

TOGHETER WITH

Commence at Reference Point "O"; thence S89deg54min58secW for a distance of 20.00 feet to the POINT OF BEGINNING "O" of the herein described parcel; thence S00deg05min02secE for a distance of 38.27 feet to a point of curve; thence Southwesterly along the arc of said curve to the right, concave to the Northwest, having a central angle of 103deg46min11sec and a radius of 10.00 feet for an arc distance of 18.11 feet to a point of compound curvature; thence Northwesterly along the arc of said curve to the right, concave to the Northeast, having a central angle of 76deg13min49sec and a radius of 36.00 feet for an arc distance of 47.90 feet to a point of tangency; thence N00deg05min02secW for a distance of 13.01 feet to a point of curve; thence Northeasterly along the arc of said curve to the right, concave to the Southeast, having a central angle of 90deg00min00sec and a radius of 10.00 feet for an arc distance of 15.71 feet to a point of tangency; thence N89deg54min58secE for a distance of 19.81 feet to a point of curve; thence Southeasterly along the arc of said curve to the right, concave to the Southwest, having a central angle of 90deg00min00sec and a radius of 10.00 feet for an arc distance of 15.71 feet to the POINT OF BEGINNING "O".

EXHIBIT "A"

17 OF 23

A portion of Tract "A" of "CENTURY PARK" according to the plat thereof as recorded in Plat Book 157 Page 14 of the Public Records of Miami-Dade County, Florida being more particularly described as follows:

Commence at the Northwest corner of said Tract "A"; thence S00deg24min34secW along the West line of said Tract "A", for a distance of 591.02 feet; thence N89deg52min27secE for a distance of 812.16 feet; thence S00deg07min06secE for a distance of 153.34 feet; thence N89deg54min58secE for a distance of 31.28 feet to the POINT OF BEGINNING of the herein described parcel; thence S00deg05min02secE for a distance of 18.00 feet; thence N89deg54min58secE for a distance of 53.00 feet to a point of curve; thence Northeasterly along the arc of said curve to the left, concave to the Northwest, having a central angle of 90deg06min00sec and a radius of 4.00 feet for an arc distance of 6.28 feet to a non tangent point, also being the REFERENCE POINT "P"; thence S89deg54min58secW for a distance of 18.00 feet; thence N00deg05min02secW for a distance of 13.37 feet; thence S89deg54min58secW for a distance of 39.00 feet to the POINT OF BEGINNING.

TOGETHER WITH

Commence at Reference Point "P"; thence N89deg54min58secE for a distance of 22.00 feet to the POINT OF BEGINNING "P" of the herein described parcel; thence N00deg05min02secW for a distance of 9.66 feet to a point of curve; thence Northeasterly along the arc of said curve to the right, concave to the Southeast, having a central angle of 77deg13min51sec and a radius of 36.00 feet for an arc distance of 48.53 feet to a point of compound curvature; thence Southeasterly along the arc of said curve to the right, concave to the Southwest, having a central angle of 102deg46min09sec and a radius of 8.00 feet for an arc distance of 14.35 feet to a point of tangency; thence S00deg05min02secE for a distance of 60.10 feet to a point of curve, also being the REFERENCE POINT "Q"; thence Southwesterly along the arc of said curve to the right, concave to the Northwest, having a central angle of 90deg00min00sec and a radius of 8.00 feet for an arc distance of 12.57 feet to a point of tangency; thence S89deg54min58secW for a distance of 19.81 feet to a point of curve; thence Northwesterly along the arc of said curve to the right, concave to the Northeast, having a central angle of 90deg00min00sec and a radius of 10.00 feet for an arc distance of 15.71 feet to a point of tangency; thence N00deg05min02secW for a distance of 21.13 to the POINT OF BEGINNING "P".

TOGETHER WITH

Commence at Reference Point "Q"; thence N89deg54min58secE for a distance of 22.00 feet to the POINT OF BEGINNING "Q" of the herein described parcel; thence N00deg05min02secW for a distance of 58.85 feet to a point of curve; thence Northeasterly along the arc of said curve to the right, concave to the Southeast, having a central angle of 89deg54min49sec and a radius of 10.00 feet for an arc distance of 15.69 feet to a point of tangency; thence N89deg49min47secE for a distance of 54.52 feet; thence S00deg05min02secE for a distance of 22.00 feet; thence N89deg49min47secE for a distance of 3.47 feet to a point of curve; thence Southeasterly along the arc of said curve to the right, concave to the Southwest, having a central angle of 90deg05min11sec and a radius of 21.00 feet for an arc distance of 33.02 feet to a point of tangency; thence S00deg05min02secE for a distance of 100.86 feet to a point of curve; thence Southwesterly along the arc of said curve to the right, concave to the Northwest, having a central angle of 45deg00min00sec and a radius of 21.00 feet for an arc distance of 16.49 feet to a point of tangency; thence S44deg54min58secW for a distance of 27.60 feet to a point of curve; thence Southwesterly along the arc of said curve to the right, concave to the Northwest, having a central angle of 50deg19min47sec and a radius of 21.31 feet for an arc distance of 18.72 feet to a point of tangency; thence S89deg54min58secW for a distance of 64.74 feet to a point of curve; thence Northwesterly along the arc of said curve to the right, concave to the Northeast, having a central angle of 90deg00min00sec and a radius of 10.00 feet for an arc distance of 15.71 feet to a point of tangency; thence N00deg05min02secW for a distance of 28.50 feet; thence S89deg54min58secW for a distance of 12.00 feet; thence N00deg05min02secW for a distance of 35.50 feet to a point of curve; thence Northeasterly along the arc of said curve to the right, concave to the Southeast, having a central angle of 90deg00min00sec and a radius of 15.00 feet for an arc distance of 23.56 feet to a point of tangency; thence N89deg54min58secE for a distance of 44.81 feet; thence N00deg05min02secW for a distance of 28.00 feet to the POINT OF BEGINNING "Q".

**EXHIBIT A**

18 OF 23

20512PG1119

A portion of Tract "A" of "CENTURY PARK" according to the plat thereof as recorded in Plat Book 157 Page 19 of the Public Records of Miami-Dade County, Florida being more particularly described as follows:

Commence at the Northwest corner of said Tract "A"; thence S00deg24min34secW along the West line of said Tract "A", for a distance of 591.02 feet; thence N89deg52min27secE for a distance of 812.16 feet to the POINT OF BEGINNING of the herein described parcel; thence continue N89deg52min27secE for a distance of 371.18 feet; thence S00deg05min02secE for a distance of 62.91 feet to a point of curve; thence Southwesterly along the arc of said curve to the right, concave to the Northwest, having a central angle of 90deg00min00sec and a radius of 36.00 feet for an arc distance of 56.55 feet to a point of tangency; thence S89deg54min58secW for a distance of 146.81 feet; thence S00deg05min02secE for a distance of 68.00 feet; thence S89deg54min58secW for a distance of 23.00 feet; thence N00deg05min02secW for a distance of 13.37 feet; thence S89deg54min58secW for a distance of 65.28 feet; thence N00deg07min06secW for a distance of 153.34 feet to the POINT OF BEGINNING.

EXHIBIT "A"

19 OF 23

20512PG1120

A portion of Tract "A" of "CENTURY PARK" according to the plat thereof as recorded in Plat Book 167 Page 19 of the Public Records of Miami-Dade County, Florida being more particularly described as follows:

Commence at the Northwest corner of said Tract "A"; thence S00deg24min34secW along the West line of said Tract "A", for a distance of 591.00 feet; thence N89deg52min27secE for a distance of 1105.34 feet to the POINT OF BEGINNING of the herein described parcel; thence continue N89deg52min27secE for a distance of 114.66 feet; thence S01deg14min31secW along the East line of said Tract "A", for a distance of 202.11 feet; thence S89deg49min47secW for a distance of 87.48 feet; thence N00deg10min13secW for a distance of 15.07 feet; thence N10deg13min12secW for a distance of 88.16 feet; thence S89deg83min58secW for a distance of 76.29 feet to the REFERENCE POINT "R"; thence continue S89deg83min58secW for a distance of 13.11 feet to a point of curve; thence Northwesterly along the arc of said curve to the right, concave to the Northeast, having a central angle of 90deg31min03sec and a radius of 36.31 feet for an arc distance of 56.56 feet to a point of tangency; thence N00deg05min03secW for a distance of 61.41 feet to the POINT OF BEGINNING.

TOGETHER WITH

Commence at Reference Point "R"; thence S01deg11min58secW for a distance of 11.04 feet to the POINT OF BEGINNING "R" of the herein described parcel; thence N89deg49min47secE for a distance of 31.39 feet to a point of curve; thence Southeasterly along the arc of said curve to the right, concave to the Southwest, having a central angle of 53deg51min40sec and a radius of 36.00 feet for an arc distance of 33.84 feet to a point of compound curvature; thence Southeasterly along the arc of said curve to the right, concave to the Southwest, having a central angle of 20deg40min22sec and a radius of 10.00 feet for an arc distance of 3.61 feet to a non tangent point; thence S89deg49min47secW for a distance of 61.08 feet; thence N00deg01min03secE for a distance of 19.01 feet to the POINT OF BEGINNING "R".

EXHIBIT "A"

20512PG112i

A portion of Tract "A" of "CENTURY PARK" according to the plat thereof as recorded in Plat Book 157 Page 19 of the Public Records of Miami-Dade County, Florida being more particularly described as follows:

Commence at the Northwest corner of said Tract "A"; thence S00deg24min34secW along the West Line of said Tract "A", for a distance of 591.02 feet; thence N89deg52min27secE for a distance of 1319.20 feet; thence S00deg24min31secW along the East Line of said Tract "A" for a distance of 202.22 feet to the POINT OF BEGINNING of the herein described parcel; thence continue S00deg24min31secW for a distance of 278.92 feet; thence S89deg59min51secE for a distance of 84.99 feet; thence N00deg05min02secW for a distance of 2.28 feet; thence N89deg54min58secE for a distance of 110.63 feet to a point of curve, also being the REFERENCE POINT "S"; thence Northwesterly along the arc of said curve to the right, concave to the Northeast, having a central angle of 07deg39min43sec and a radius of 15.00 feet for an arc distance of 2.01 feet to a non tangent point; thence N00deg05min02secW for a distance of 101.36 feet to a non tangent point on a curve, said point bears S16deg43min57secE to center of the curve; thence Northeasterly along the arc of said curve to the right, concave to the Southeast, having a central angle of 16deg38min55sec and a radius of 24.00 feet for an arc distance of 6.94 feet to a point of tangency; thence N89deg54min58secE for a distance of 55.98 feet to REFERENCE POINT "T"; thence continue N89deg54min58secE for a distance of 35.00 feet; thence N00deg05min02secW for a distance of 80.00 feet; thence S89deg54min58secW for a distance of 95.86 feet to a point of curve; thence Northwesterly along the arc of said curve to the right, concave to the Northeast, having a central angle of 11deg32min12sec and a radius of 15.00 feet for an arc distance of 3.02 feet to a non tangent point; thence N00deg05min02secW for a distance of 102.17 feet to a non tangent point on a curve, said point bears S41deg53min38secE to center of the curve; thence Northeasterly along the arc of said curve to the right, concave to the Southeast, having a central angle of 11deg43min26sec and a radius of 36.00 feet for an arc distance of 26.22 feet to a point of tangency; thence N89deg49min47secE for a distance of 34.63 feet to REFERENCE POINT "U"; thence continue N89deg49min47secE for a distance of 64.84 feet; thence S00deg10min13secE for a distance of 18.00 feet; thence N89deg49min47secE for a distance of 87.48 feet to the POINT OF BEGINNING.

## TOGHETER WITH

Commence at Reference Point "S"; thence S00deg05min02secE for a distance of 22.00 feet to the POINT OF BEGINNING "S" of the herein described parcel; thence N89deg54min58secE for a distance of 73.52 feet to a point of curve; thence Southeasterly along the arc of said curve to the right, concave to the Southwest, having a central angle of 90deg01min15sec and a radius of 15.00 feet for an arc distance of 23.57 feet to a point of tangency; thence S00deg03min47secE for a distance of 3.07 feet; thence S89deg54min58secW for a distance of 103.52 feet; thence N00deg05min02secW for a distance of 3.08 feet to a point of curve; thence Northeasterly along the arc of said curve to the right, concave to the Southeast, having a central angle of 90deg00min00sec and a radius of 15.00 feet for an arc distance of 23.56 feet to the POINT OF BEGINNING "S".

## TOGHETER WITH

Commence at Reference Point "T"; thence N00deg05min02secW for a distance of 22.00 feet to the POINT OF BEGINNING "T" of the herein described parcel; thence S89deg54min58secW for a distance of 55.98 feet to a point of curve; thence Southwesterly along the arc of said curve to the left, concave to the Southeast, having a central angle of 25deg30min4usec and a radius of 46.00 feet for an arc distance of 20.48 feet to a non tangent point; thence N00deg05min02secW for a distance of 42.76 feet to a non tangent point on a curve, said point bears N18deg01min07secE to center of the curve; thence Southeasterly along the arc of said curve to the left, concave to the Northeast, having a central angle of 16deg06min09sec and a radius of 46.00 feet for an arc distance of 14.51 feet to a point of tangency; thence N89deg54min58secE for a distance of 61.50 feet to a point of curve; thence Southeasterly along the arc of said curve to the right, concave to the Southwest, having a central angle of 90deg00min00sec and a radius of 15.00 feet for an arc distance of 23.56 feet to a point of tangency; thence S00deg05min02secE for a distance of 6.00 feet to a point of curve; thence Southwesterly along the arc of said curve to the right, concave to the Northwest, having a central angle of 90deg00min00sec and a radius of 15.00 feet for an arc distance of 23.56 feet to the POINT OF BEGINNING "T".

## TOGHETER WITH

Commence at Reference Point "U"; thence N00deg10min13secW for a distance of 22.00 feet to the POINT OF BEGINNING "U" of the herein described parcel; thence S89deg49min47secW for a distance of 55.52 feet; thence N00deg00min05secE for a distance of 41.33 feet; thence N89deg49min47secE for a distance of 34.00 feet; thence S00deg00min05secW for a distance of 18.00 feet; thence N89deg49min47secE for a distance of 52.08 feet to a non tangent point on a curve, said point bears S74deg21min43secW to center of the curve; thence Southwesterly along the arc of said curve to the right, concave to the Northwest, having a central angle of 51deg36min24sec and a radius of 10.00 feet for an arc distance of 9.01 feet to a point of compound curvature; thence Southwesterly along the arc of said curve to the right, concave to the Northwest, having a central angle of 53deg52min07sec and a radius of 36.00 feet for an arc distance of 33.85 feet to the POINT OF BEGINNING "U".

EXHIBIT A

20512PG1122

A portion of Tract "A" of "CENTURY PARK" according to the plat thereof as recorded in Plat Book 157 Page 19 of the Public Records of Miami-Dade County, Florida being more particularly described as follows:

Commence at the Northwest corner of said Tract "A"; thence S00deg24min34secW along the West line of said Tract "A", for a distance of 591.02 feet; thence N89deg52min27secE for a distance of 1319.20 feet; thence S00deg24min31secW along the East Line of said Tract "A" for a distance of 481.14 feet to the POINT OF BEGINNING of the herein described parcel; thence continue S00deg24min31secW for a distance of 175.85 feet; thence S89deg54min58secW along the South line of said Tract "A", for a distance of 173.00 feet to a point of curve; thence Northwesterly along the arc of said curve to the right, concave to the Northeast, having a central angle of 90deg00min00sec and a radius of 25.00 feet for an arc distance of 39.27 feet to a point of tangency; thence N00deg05min02secW for a distance of 71.44 feet to a non tangent point on a curve; said point bears S23deg39min42secE to center of the curve; thence Northeasterly along the arc of said curve to the right, concave to the Southeast, having a central angle of 23deg34min40sec and a radius of 15.00 feet for an arc distance of 6.17 feet to a point tangency; thence N89deg54min58secE for a distance of 108.53 feet; thence N00deg05min02secW for a distance of 40.49 feet to the REFERENCE POINT "V"; thence continue N00deg05min02secW for a distance of 37.80 feet thence N89deg59min51secW for a distance of 84.99 feet to the POINT OF BEGINNING.

TOGETHER WITH

Commence at Reference Point "V"; thence S89deg54min58secW for a distance of 22.01 feet to the POINT OF BEGINNING "V" of the herein described parcel; thence S00deg03min47secE for a distance of 3.49 feet to a point of curve; thence Southwesterly along the arc of said curve to the right, concave to the Northwest, having a central angle of 89deg58min45sec and a radius of 15.00 feet for an arc distance of 23.56 feet to a point of tangency; thence S89deg54min58secW for a distance of 73.52 feet to a point of curve; thence Northwesterly along the arc of said curve to the right, concave to the Northeast, having a central angle of 90deg00min00sec and a radius of 15.00 feet for an arc distance of 23.56 feet to a point of tangency; thence N00deg05min02secW for a distance of 3.49 feet; thence N89deg54min58secE for a distance of 103.52 feet to the POINT OF BEGINNING "V".

EXHIBIT A

20512PG1123

A portion of Tract "A" of "CENTURY PARK" according to the plat thereof as recorded in Plat Book 157 Page 19 of the Public Records of Miami-Dade County, Florida being more particularly described as follows:

Commence at the Northwest corner of said Tract "A"; thence S00deg24min34secW along the West line of said Tract "A", for a distance of 591.02 feet; thence N89deg52min27secE for a distance of 358.37 feet; thence S02deg56min39secW for a distance of 5.39 feet; thence S02deg28min21secW for a distance of 12.59 feet; thence S01deg32min42secW for a distance of 20.18 feet; thence S00deg23min09secW for a distance of 21.02 feet; thence S00deg05min02secE for a distance of 163.26 feet to a point of curve; thence Southwesterly along the arc of said curve to the right, concave to the Northwest, having a central angle of 45deg00min00sec and a radius of 22.00 feet for an arc distance of 17.28 feet to a non tangent point; thence S45deg05min02secE for a distance of 34.00 feet to the POINT OF BEGINNING of the herein described parcel;

thence N44deg54min58secE for a distance of 1.66 feet to a point of curve;

thence Northeasterly along the arc of said curve to the right, concave to the Southeast, having a central angle of 45deg00min00sec and a radius of 25.00 feet for an arc distance of 19.63 feet to a point of tangency;

thence N89deg54min58secE for a distance of 19.57 feet to a point of curve;

thence Southeasterly along the arc of said curve to the right, concave to the Southwest, having a central angle of 45deg00min00sec and a radius of 25.00 feet for an arc distance of 19.63 feet to a point of tangency;

thence S45deg05min02secE for a distance of 44.26 feet to a point of curve;

thence Southeasterly along the arc of said curve to the right, concave to the Southwest, having a central angle of 45deg00min00sec and a radius of 36.00 feet for an arc distance of 28.27 feet to a point of tangency;

thence S00deg05min02secE for a distance of 122.18 feet to a point of curve;

thence Southwesterly along the arc of said curve to the right, concave to the Northwest, having a central angle of 90deg00min00sec and a radius of 15.00 feet for an arc distance of 23.56 feet to a point of tangency;

thence S89deg54min58secW for a distance of 108.61 feet to a point of curve;

thence Northwesterly along the arc of said curve to the right, concave to the Northeast, having a central angle of 90deg00min00sec and a radius of 15.00 feet for an arc distance of 23.56 feet to a point of tangency;

thence N00deg05min02secW for a distance of 122.18 feet to a point of curve;

thence Northeasterly along the arc of said curve to the right, concave to the Southeast, having a central angle of 45deg00min00sec and a radius of 36.00 feet for an arc distance of 28.27 feet to a point of tangency;

thence N44deg54min58secE for a distance of 40.60 feet to the POINT OF BEGINNING.

**EXHIBIT "A"**  
23 OF 23


OFF. REC BK.

20512PG1124


**EXHIBIT "B"**  
**SURVEY and FLOOR PLANS**

~~OFF. REC'D.~~


20512PG1125

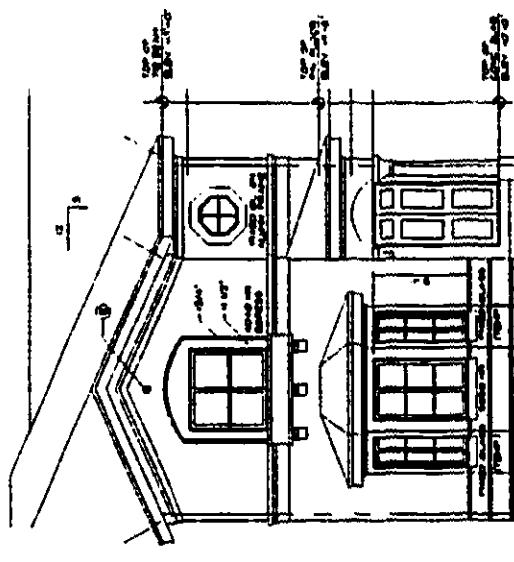

FRONT ELEVATION  
SCALE: 1" = 10'

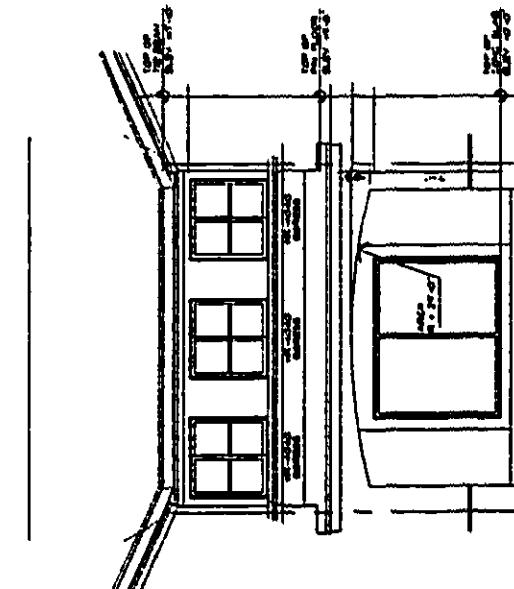


REAR ELEVATION

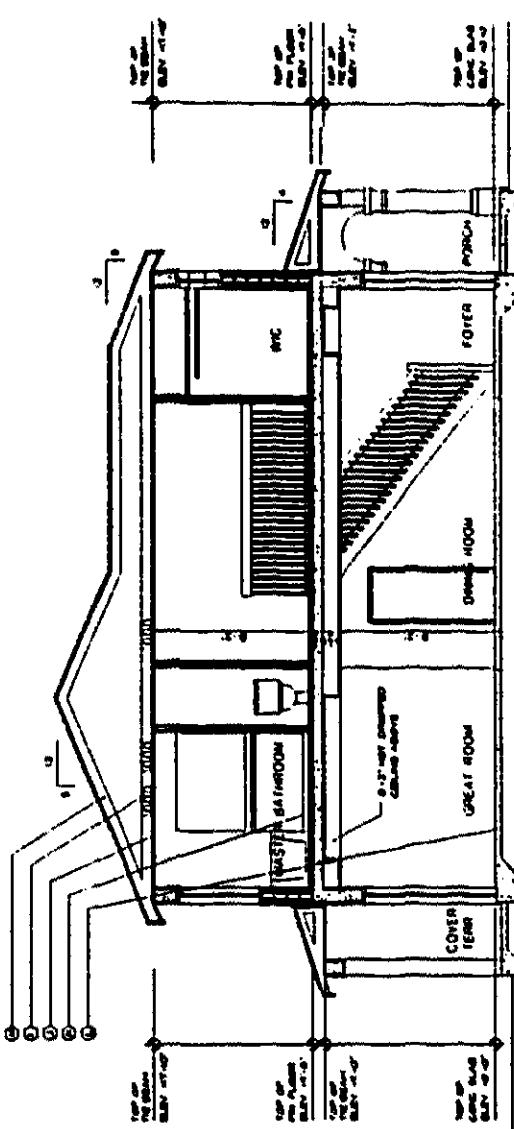


SECTION 1" = 10'

NOTE:  
ALL IMPROVEMENTS ARE PROPOSED

NOTE

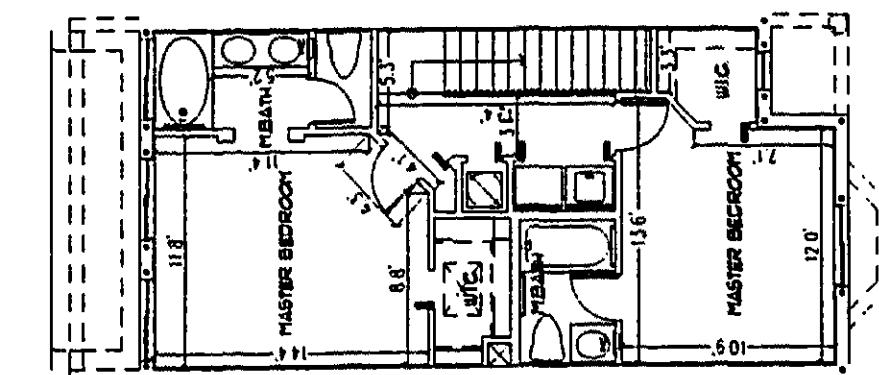

SECOND FLOOR PLAN  
SCALE: 1" = 10'

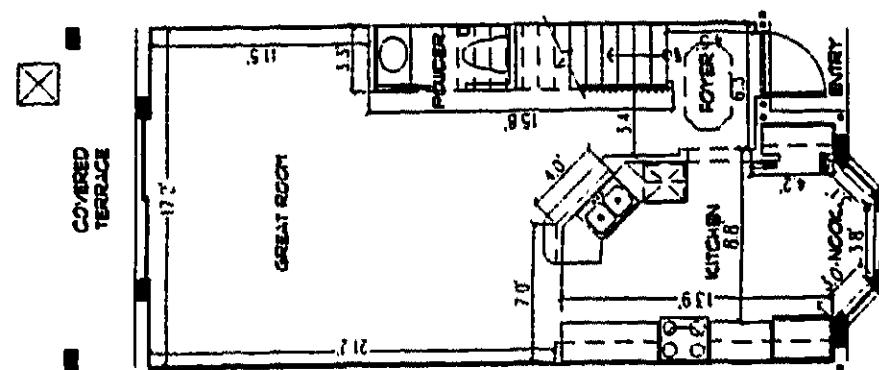

FIRST FLOOR PLAN  
SCALE: 1" = 10'

**CLERK NOTE:**  
FOR DECLARATION OF CONDOMINIUM  
SEE OFFICIAL RECORD BK 20512 PG. 1061


OLEMK NOTE:

1

MAY 3 0 2006

**MANUEL FELIPE, P.S.M.**  
Professional Surveyor and Mapper  
6000 S.E. Sub Street, Suite 202, Miami, Florida  
Phone: (305) 253-9300 - Fax: (305) 253-9100

**EXHIBIT "A" PAGE 1**  
**CENTURY PARK CONDOMINIUM No. 2**  
**A FRANCHISE**

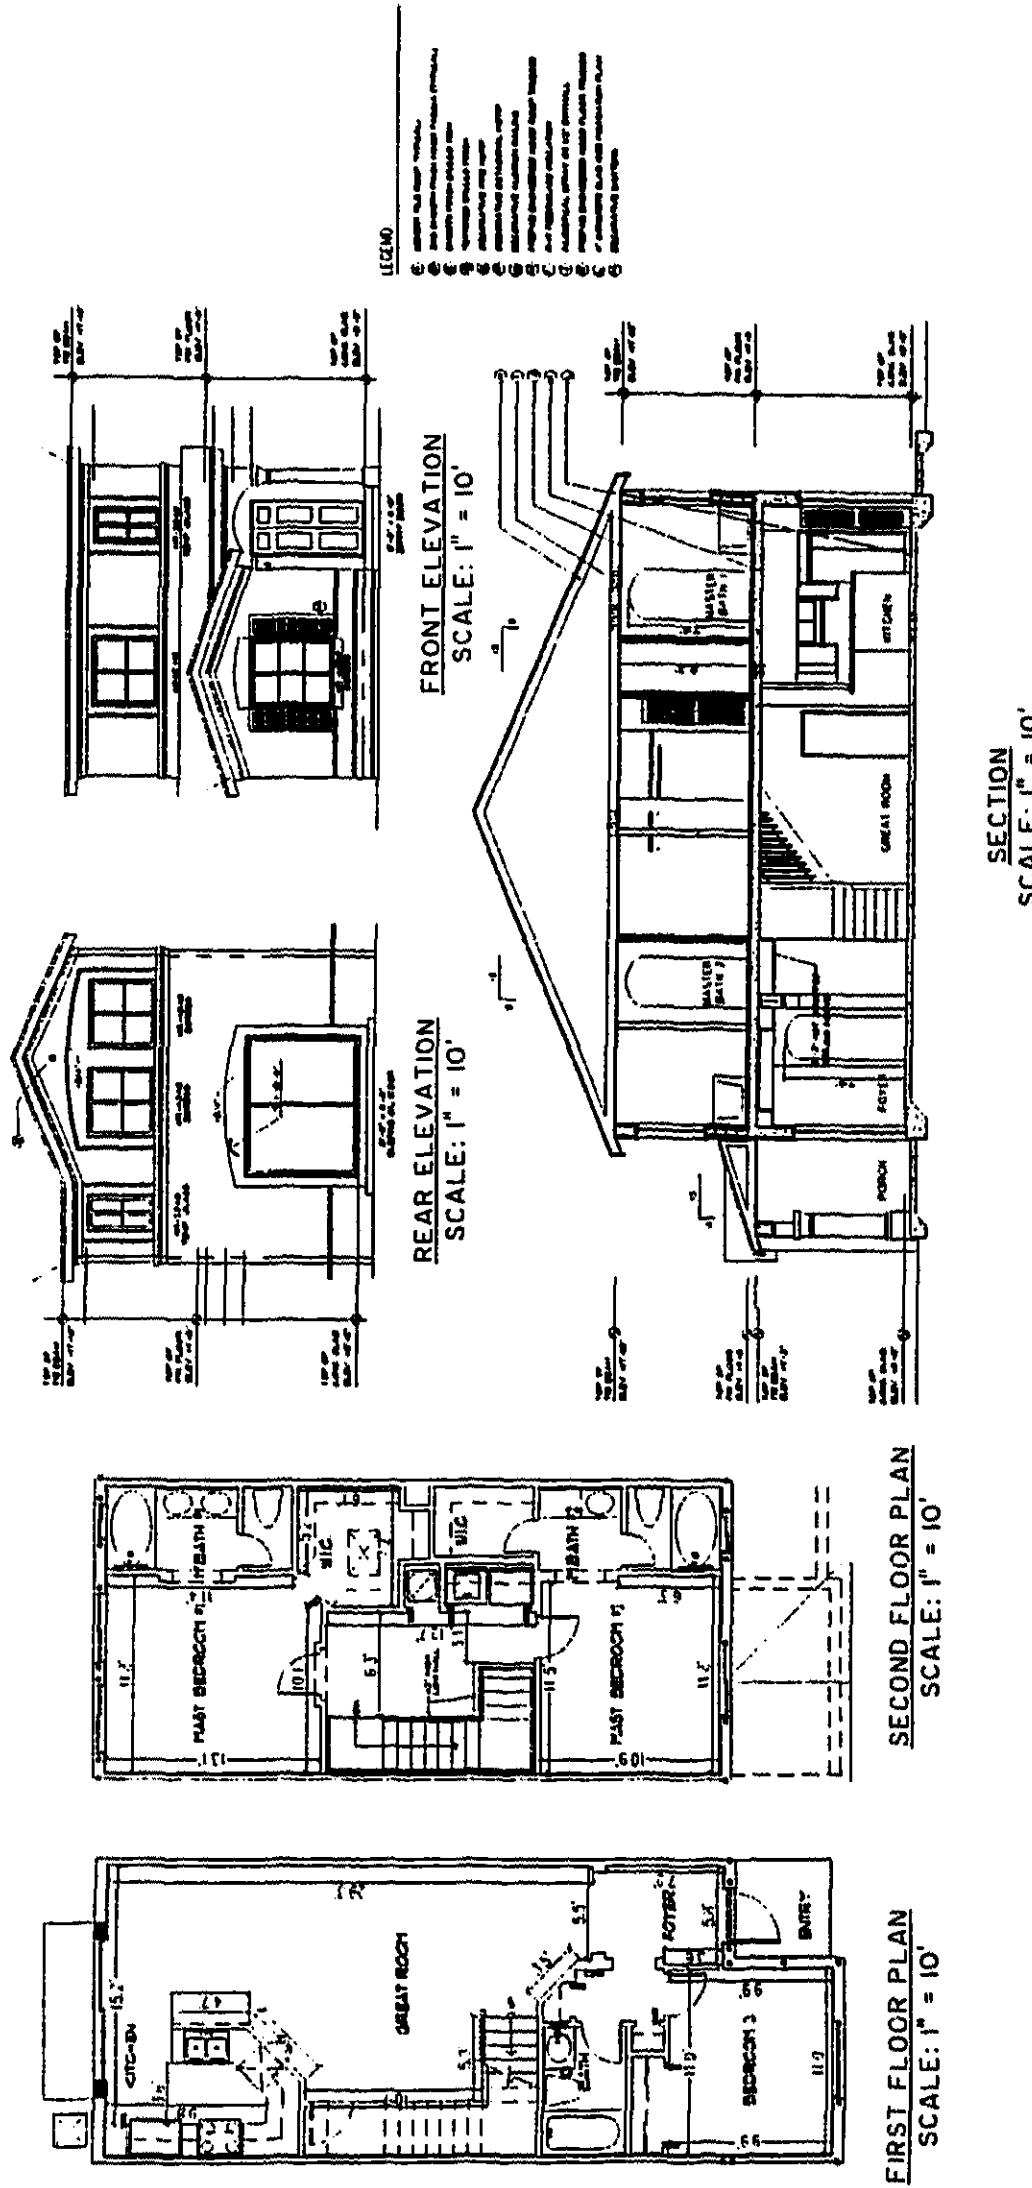


NOTE:  
**ALL IMPROVEMENTS ARE PROPOSED**

<b>MANUEL FELIPE, P.S.M.</b>	
Professional Surveyor and Mapper	
800 S.W. 8th Street, Suite 202, Miami, Florida 33164	
Phone: (305) 265-8268 - Fax: (305) 265-8262	
<b>EXHIBIT " " PAGE 2</b>	
<b>CENTURY PARK CONDOMINIUM No. 2</b>	
<b>A CONDOMINIUM</b>	


20512 PG 1127

MANUEL FELIPE, P.S.M.	
Professional Surveyor and Mapper	
6600 S.W. 8th Street, Suite 300, Miami, Florida 33143	
Phone: (305) 225-8380 Fax: (305) 223-8882	
EXHIBIT "C" PAGE 3	
CENTURY PARK CONDOMINIUM No. 2	
A CONDOMINIUM	
FLOOR MODEL "C" FLOOR PLAN	

SECOND FLOOR PLAN  
SCALE: 1" = 10'

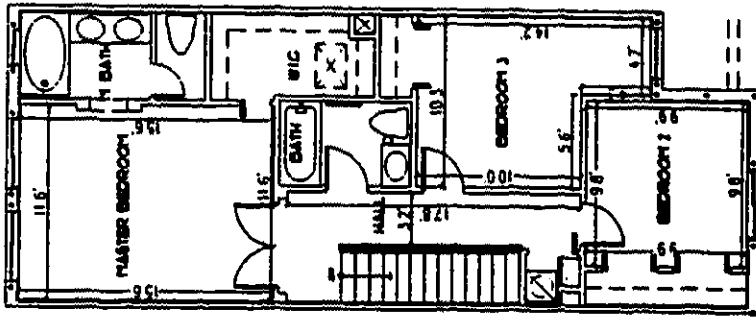


FIRST FLOOR PLAN  
SCALE: 1" = 10'

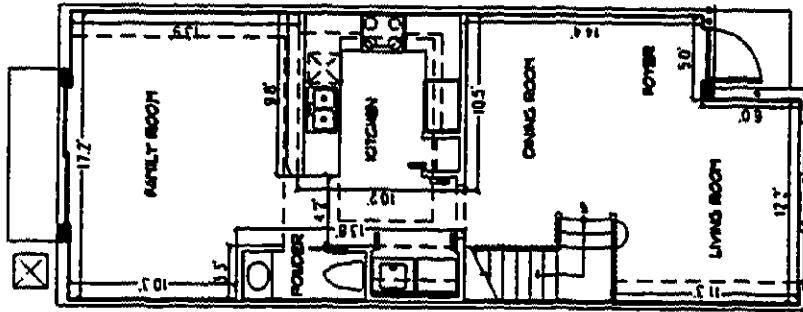

NOTE:  
**ALL IMPROVEMENTS ARE PROPOSED**

NOTE:  
ALL IMPROVEMENTS ARE PROPOSED

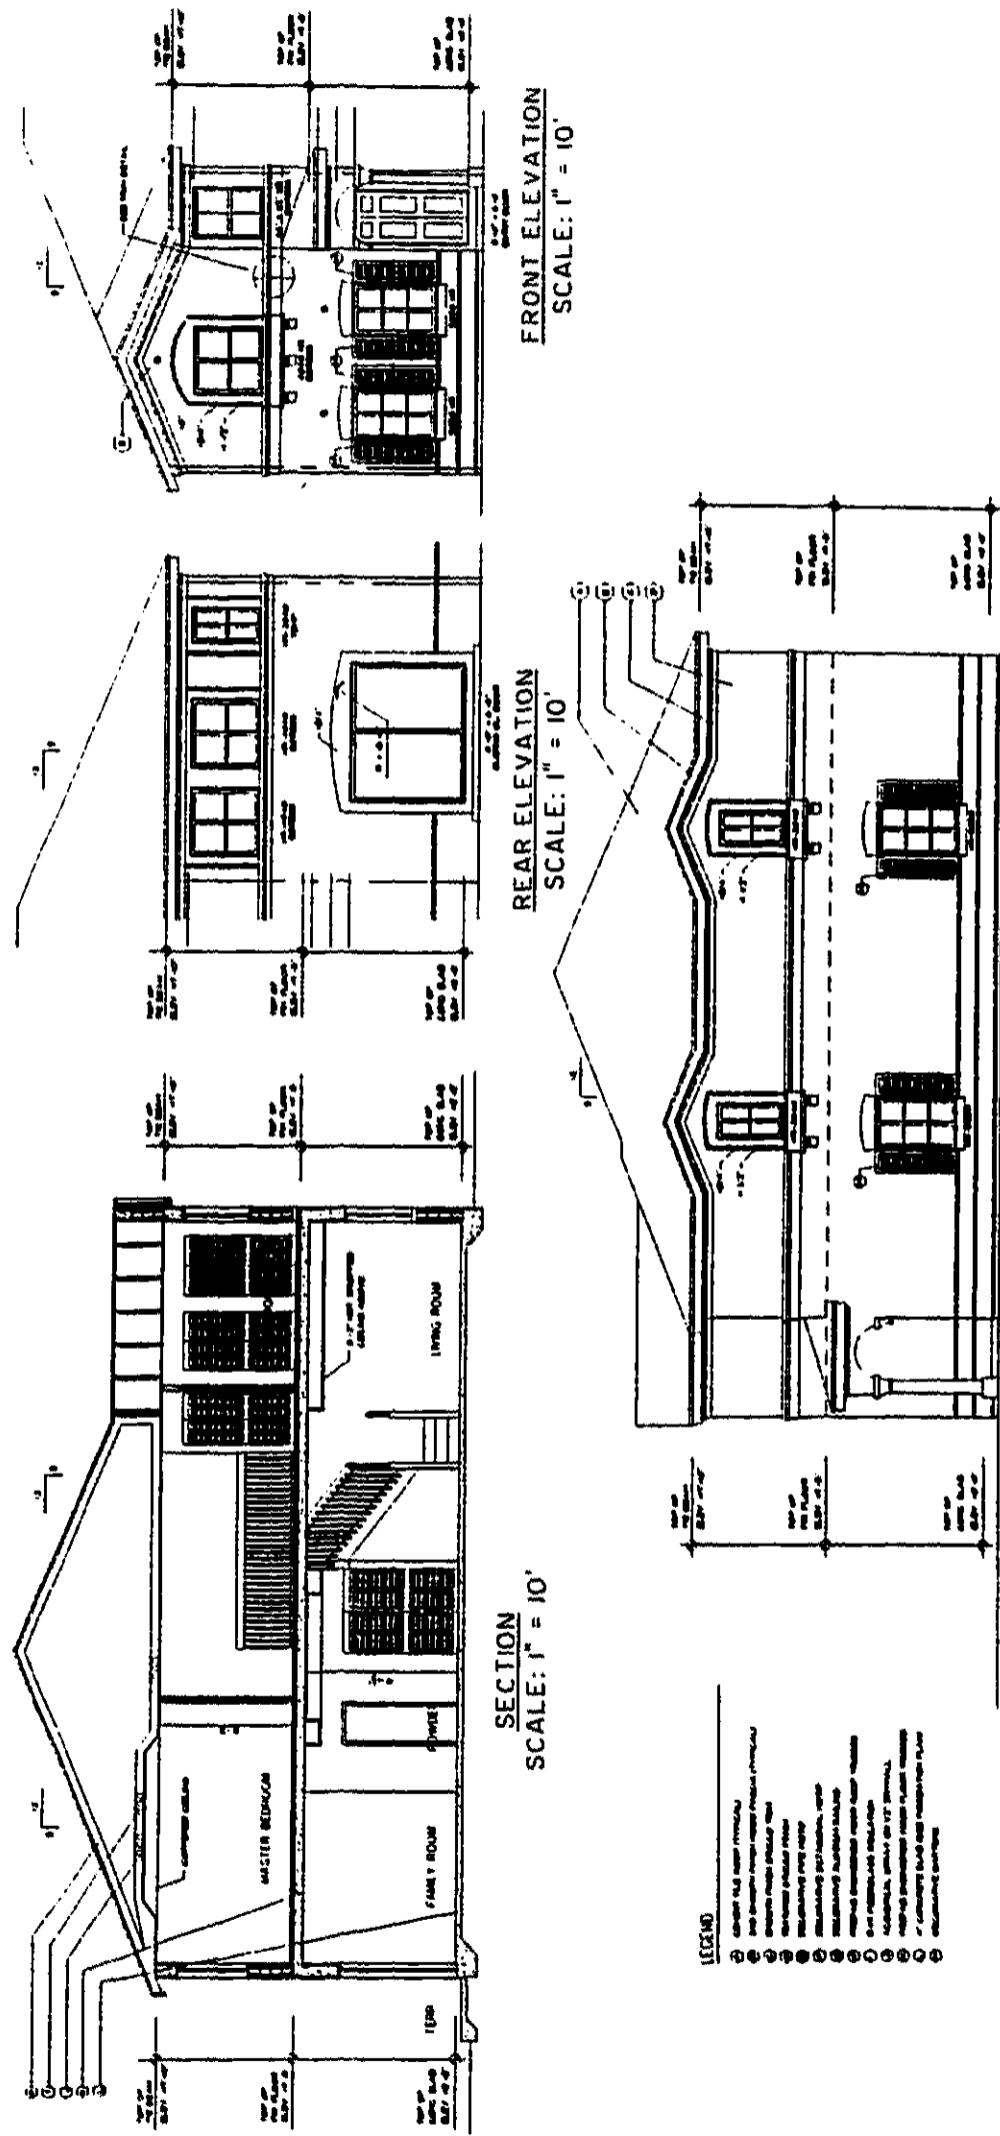


<b>MANUEL FELIPE, P.S.M.</b>	
Professional Surveyor and Mapper	
6500 S.W. 6th Street, Suite 202, Miami, Florida 33144	
Phone: (305) 263-8300 - Fax: (305) 263-8002	
<b>EXHIBIT PAGE 4</b>	
<b>CENTURY PARK CONDOMINIUM No. 2</b>	
A CONDOMINIUM	
IMPROVEMENTS	

20512PG1129


**MANUEL FELIPE, P.S.M.**  
 Professional Surveyor and Mapper  
 6500 S.W. 8th Street, Suite 202, Miami, Florida 33164  
 Phone: (305) 235-8388 - Fax: (305) 235-9082

**EXHIBIT "C" PAGE 5**  
**CENTURY PARK CONDOMINIUM No. 2**  
 A CONDOMINIUM

OFFICIAL NUMBER "C" FLOOR PLAN  

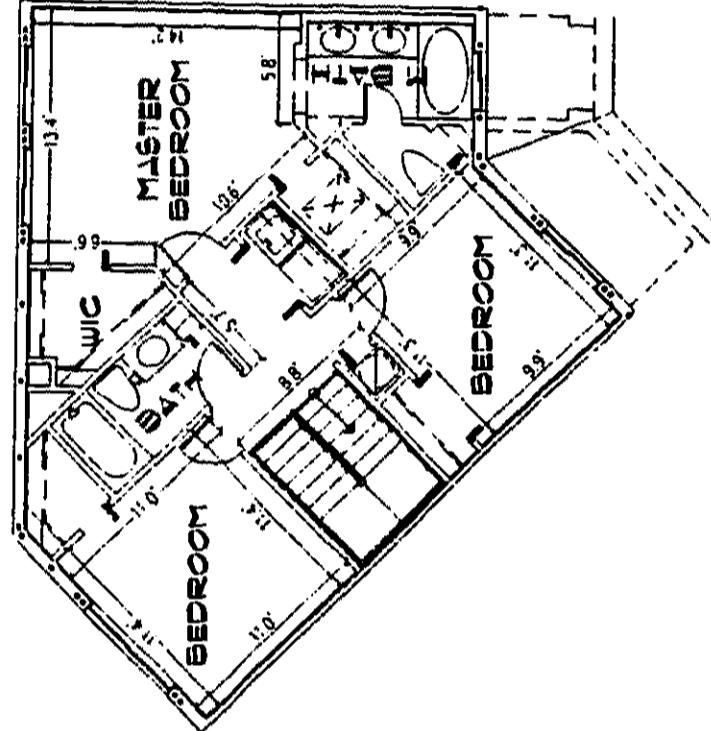


SECOND FLOOR PLAN  
SCALE: 1" = 10'

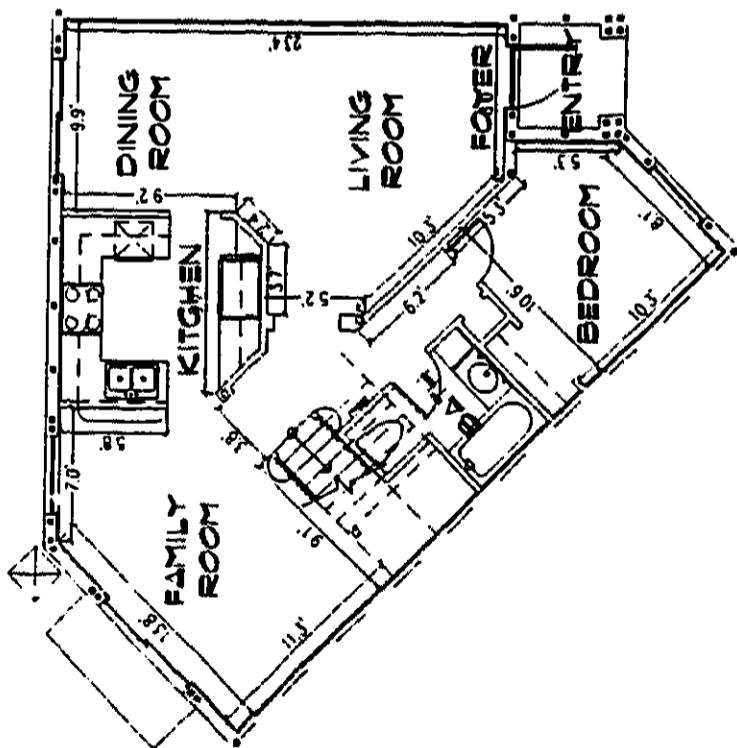

FIRST FLOOR PLAN  
SCALE: 1" = 10'


NOTE:  
ALL IMPROVEMENTS ARE PROPOSED

20512PG1130

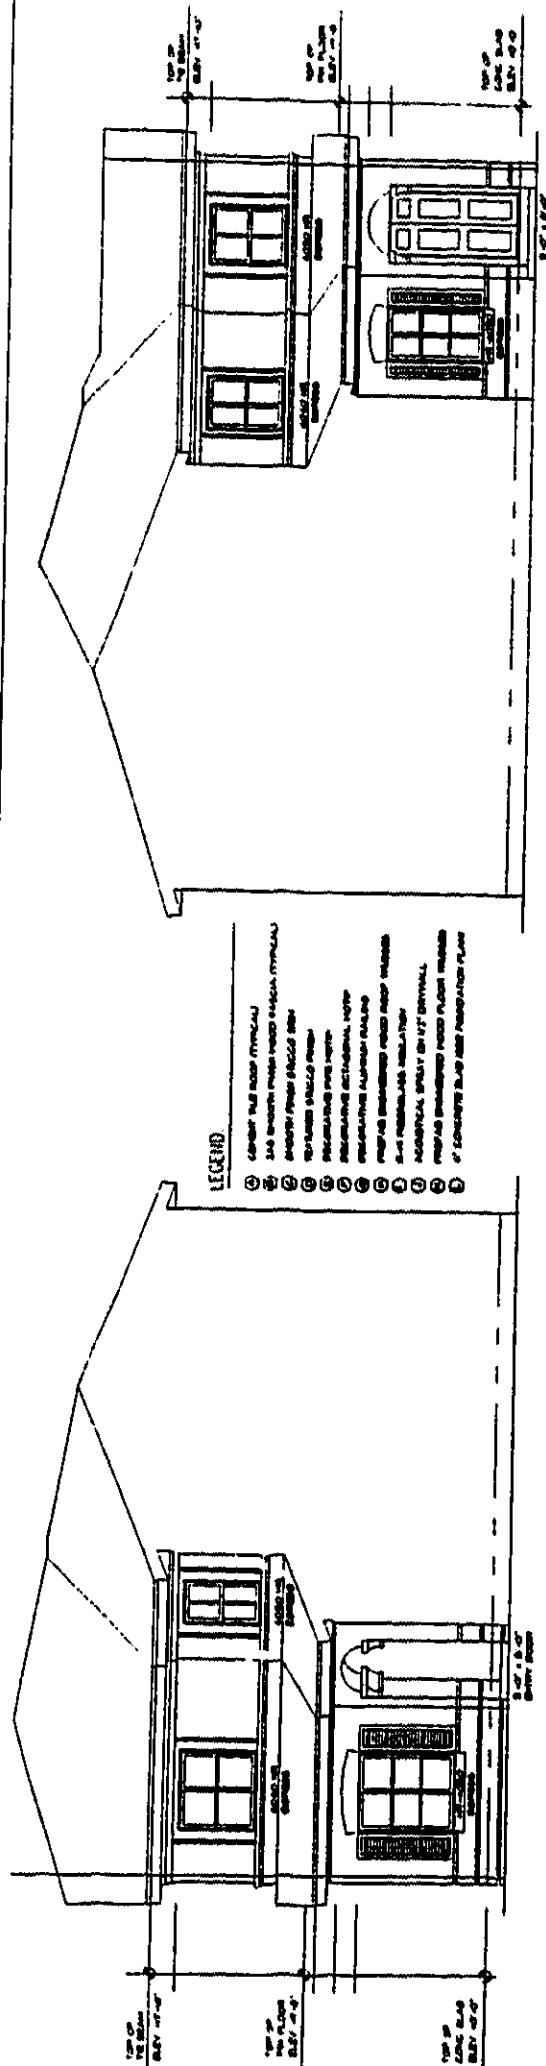

FRONT ELEVATION  
SCALE: 1" = 10'

FRONT ELEVATION  
SCALE: 1" = 10'

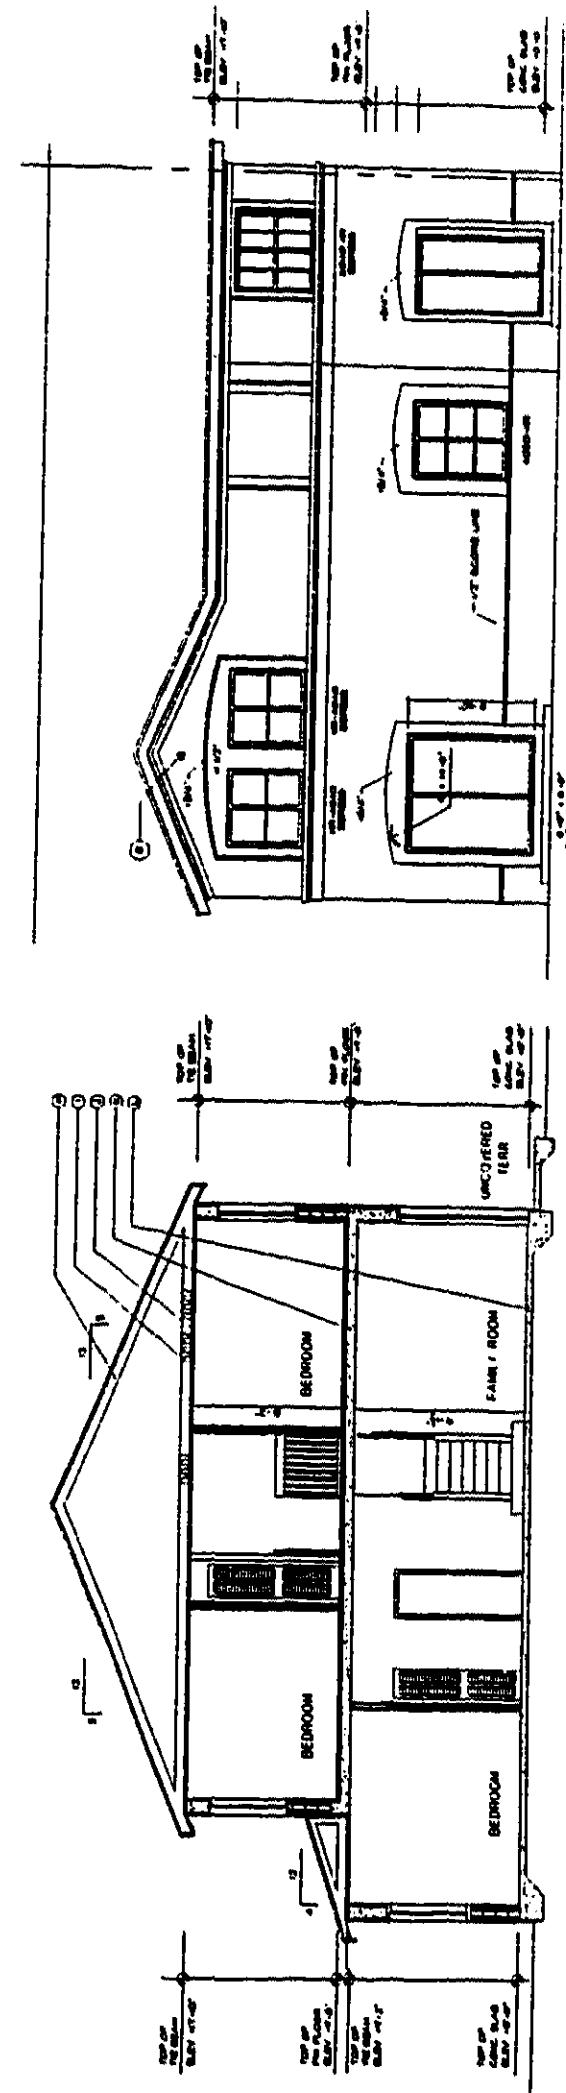

SECTION  
SCALE: 1" = 10'

REAR ELEVATION  
SCALE: 1" = 10'

NOTE:  
ALL IMPROVEMENTS ARE PROPOSED

NOTE:

**MANUEL FELIPE, P.S.M.**  
Professional Surveyor and Mapper  
5500 S.E. 9th Street, Suite 202, Miami, Florida 33144  
Phone: (305) 253-6506 - Fax: (305) 351-8042

EXHIBIT "B" PAGE 6  
CENTURY PARK CONDOMINIUM NO. 2  
A CONDOMINIUM  



20512PG1131

**MANUEL FELIPE, P.S.M.**  
 Professional Surveyor and Mapper  
 4600 S.W. 8th Street, Suite 200, Miami, Florida 33143  
 Phone: (305) 265-3000 - Fax: (305) 265-3002


**EXHIBIT " " PAGE 7**  
**CENTURY PARK CONDOMINIUM No. 2**


**SECOND FLOOR PLAN**  
 SCALE: 1" = 10'

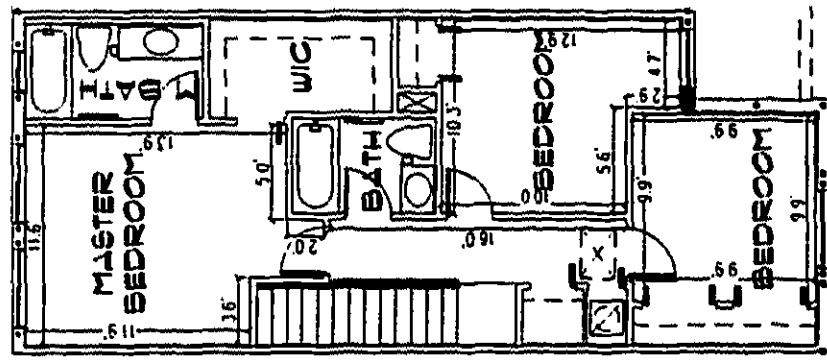


**FIRST FLOOR PLAN**  
 SCALE: 1" = 10'

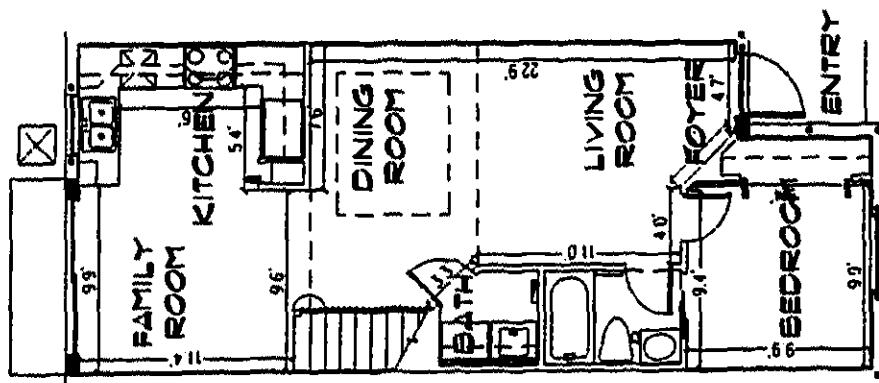


**NOTE:**  
**ALL IMPROVEMENTS ARE PROPOSED**

20512PG1132


NOTE:  
ALL IMPROVEMENTS ARE PROPOSED

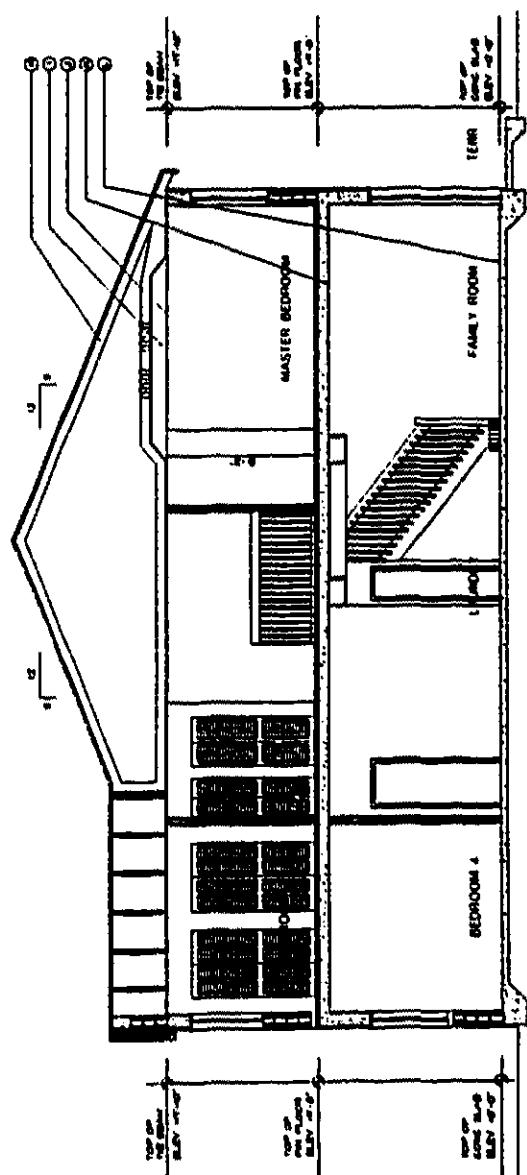


SECTION  
SCALE: 1" = 10'

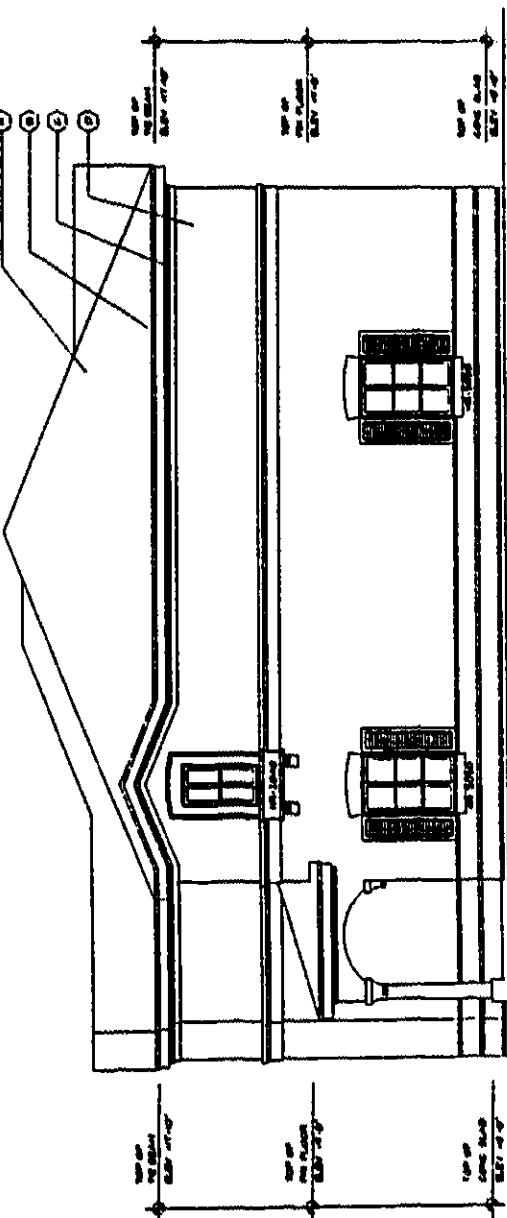


SIDE ELEVATION  
SCALE: 1" = 10'

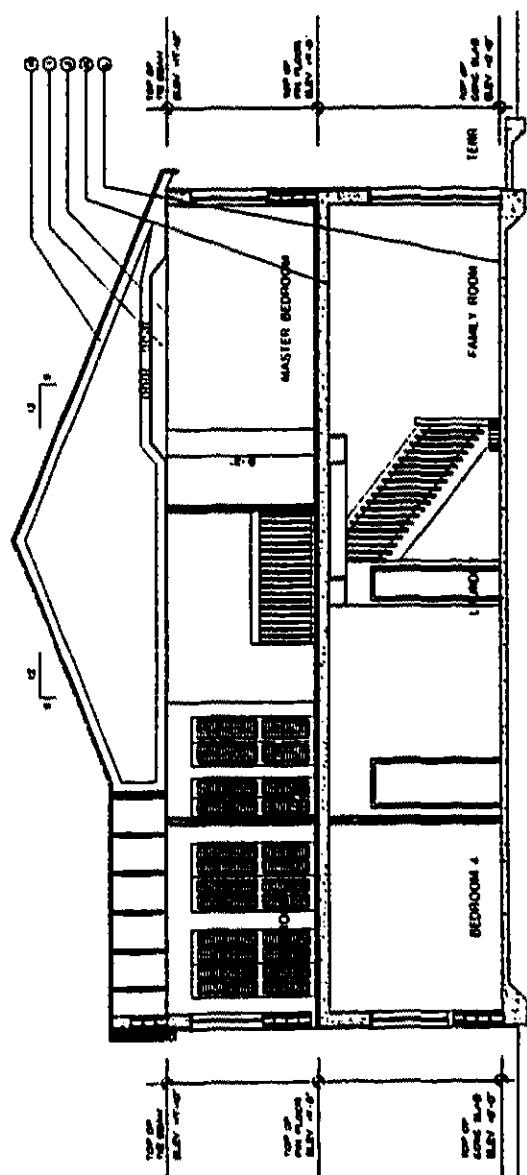


REAR ELEVATION  
SCALE: 1" = 10'

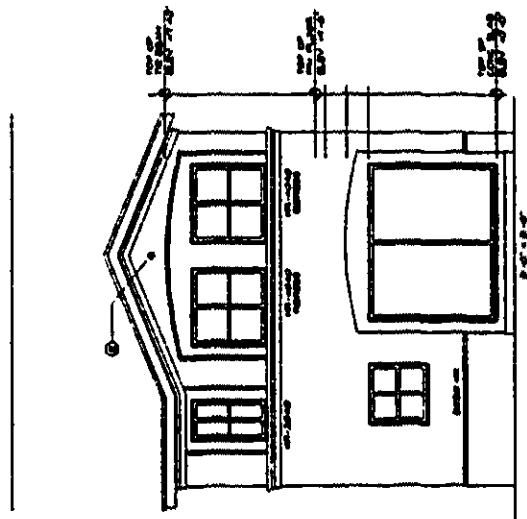

FRONT ELEVATION  
SCALE: 1" = 10'

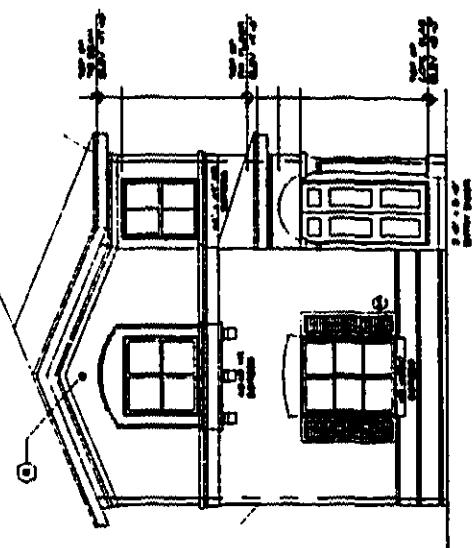

FRONT ELEVATION  
SCALE: 1" = 10'

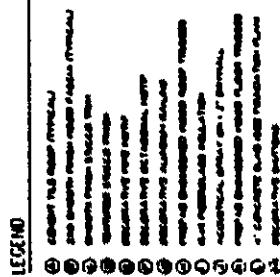


LEGEND

**MANUEL FELIPE, P.S.M.**  
Professional Surveyor and Mapper  
8600 S.W. 8th Street, Suite 202, Miami, Florida 33166  
Phone: (305) 265-0300 - Fax: (305) 265-0302

**EXHIBIT "PAGE 8**  
**CENTURY PARK CONDOMINIUM No. 2**


NOTE:  
ALL IMPROVEMENTS ARE PROPOSED

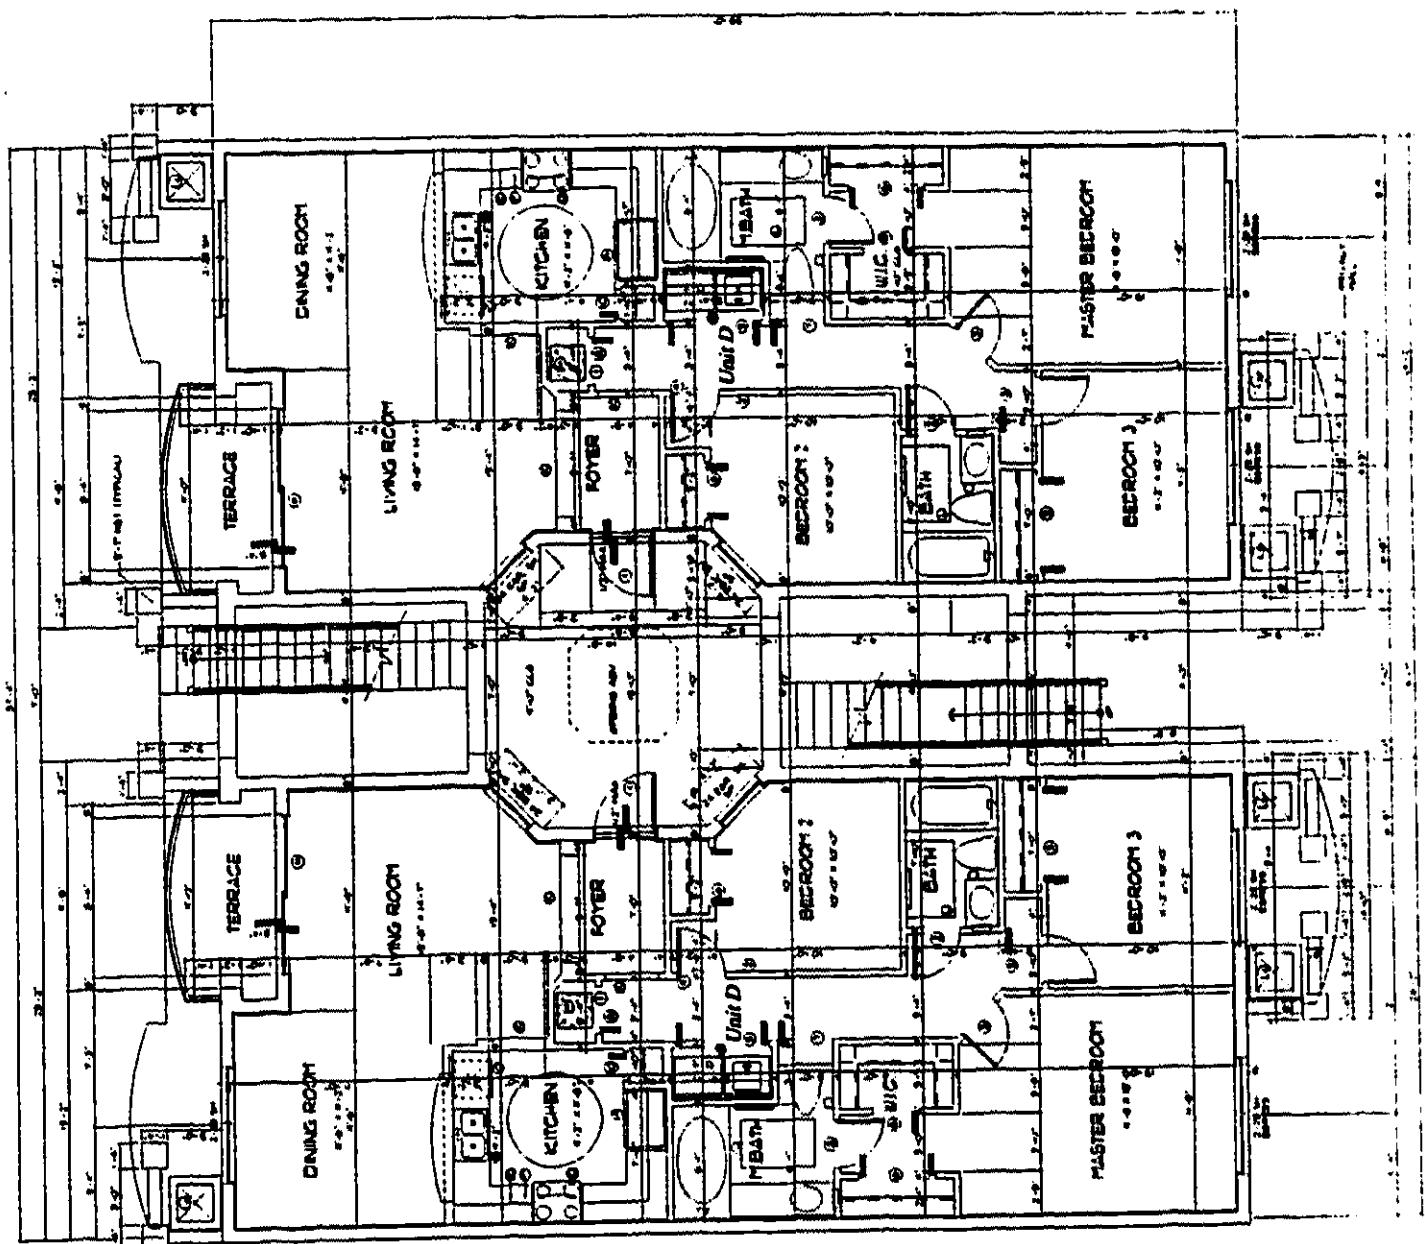

FIRST FLOOR PLAN  
SCALE: 1" = 10'


MANUEL FELIPE, P.S.M.  
Professional Surveyors and Reporters  
2600 S.W. 8th Street, Suite 202, Miami, Florida 33144  
Phone: (305) 253-8300 - Fax: (305) 253-9002

EXHIBIT "B" PAGE 9  
CENTURY PARK CONDOMINIUM No. 2

A CONDOMINIUM  

20512PG1134

NOTE:  
ALL IMPROVEMENTS ARE PROPOSED

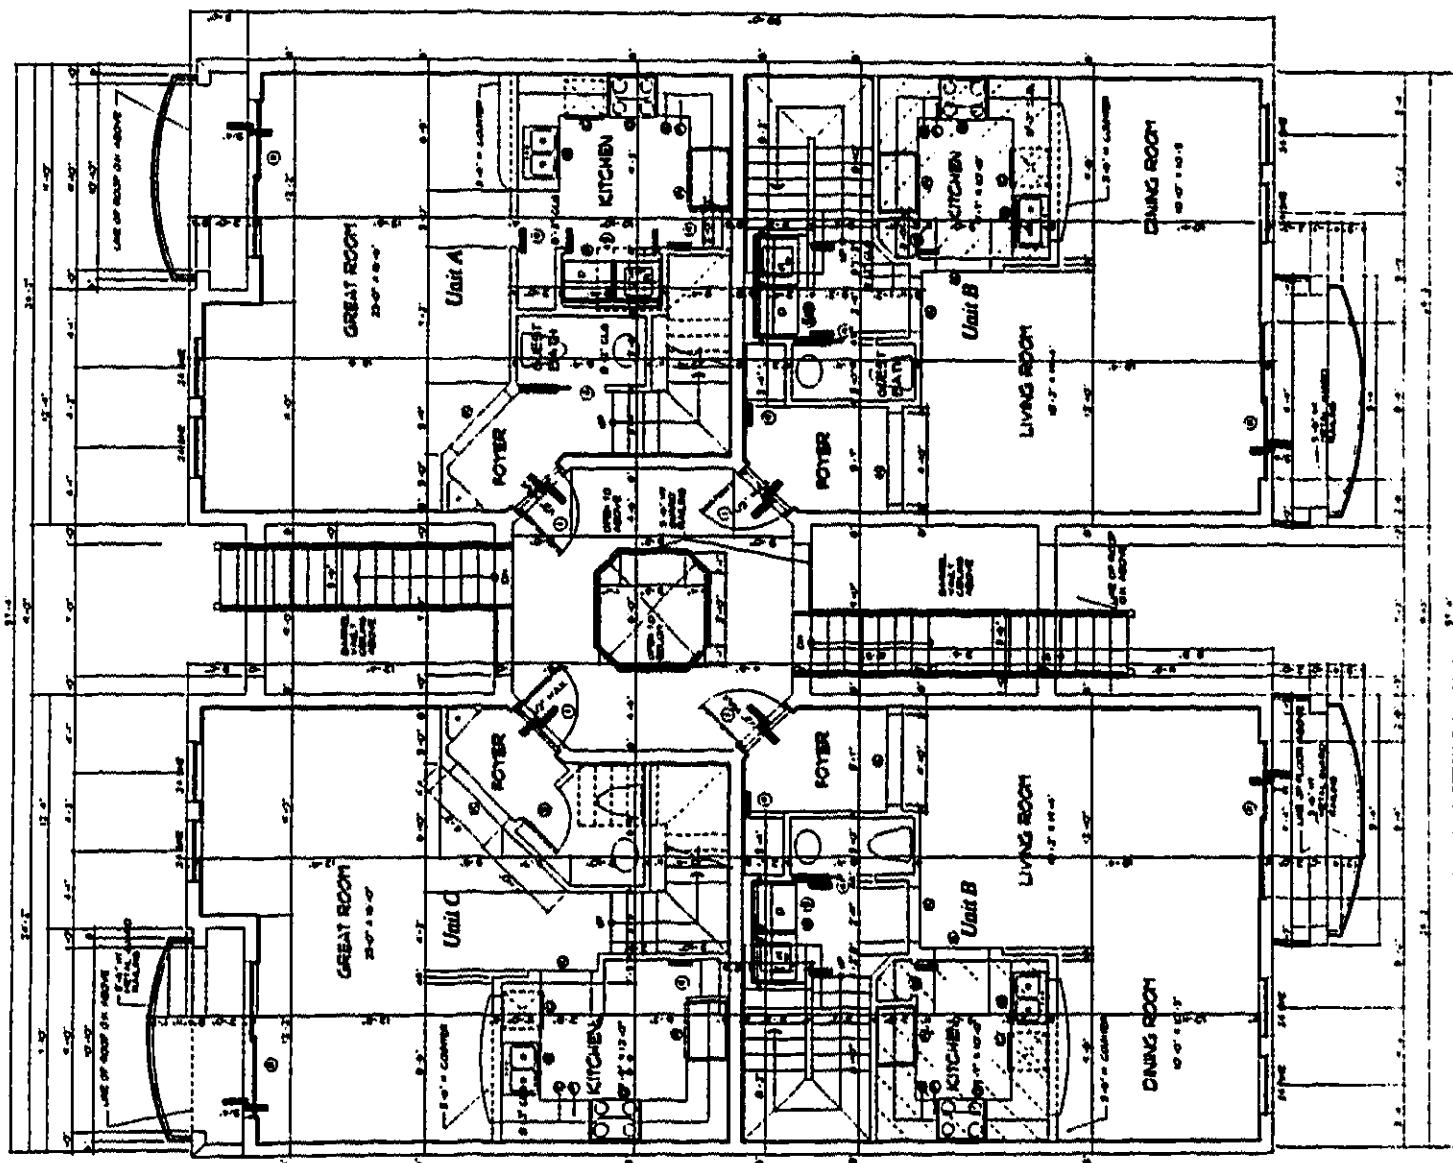


SECOND FLOOR PLAN  
SCALE: 1" = 10'

MAY 30 2008

**MANUEL FELIPE, P.S.M.**  
6000 S.E. 8th Street, Suite 200, Miami, Florida 33164  
Phone: (305) 263-6308 - Fax: (305) 263-9082

**EXHIBIT "C" PAGE 10**  
**CENTURY PARK CONDOMINIUM No. 2**  
A CONDOMINIUM  

NOTE:  
ALL IMPROVEMENTS ARE PROPOSED

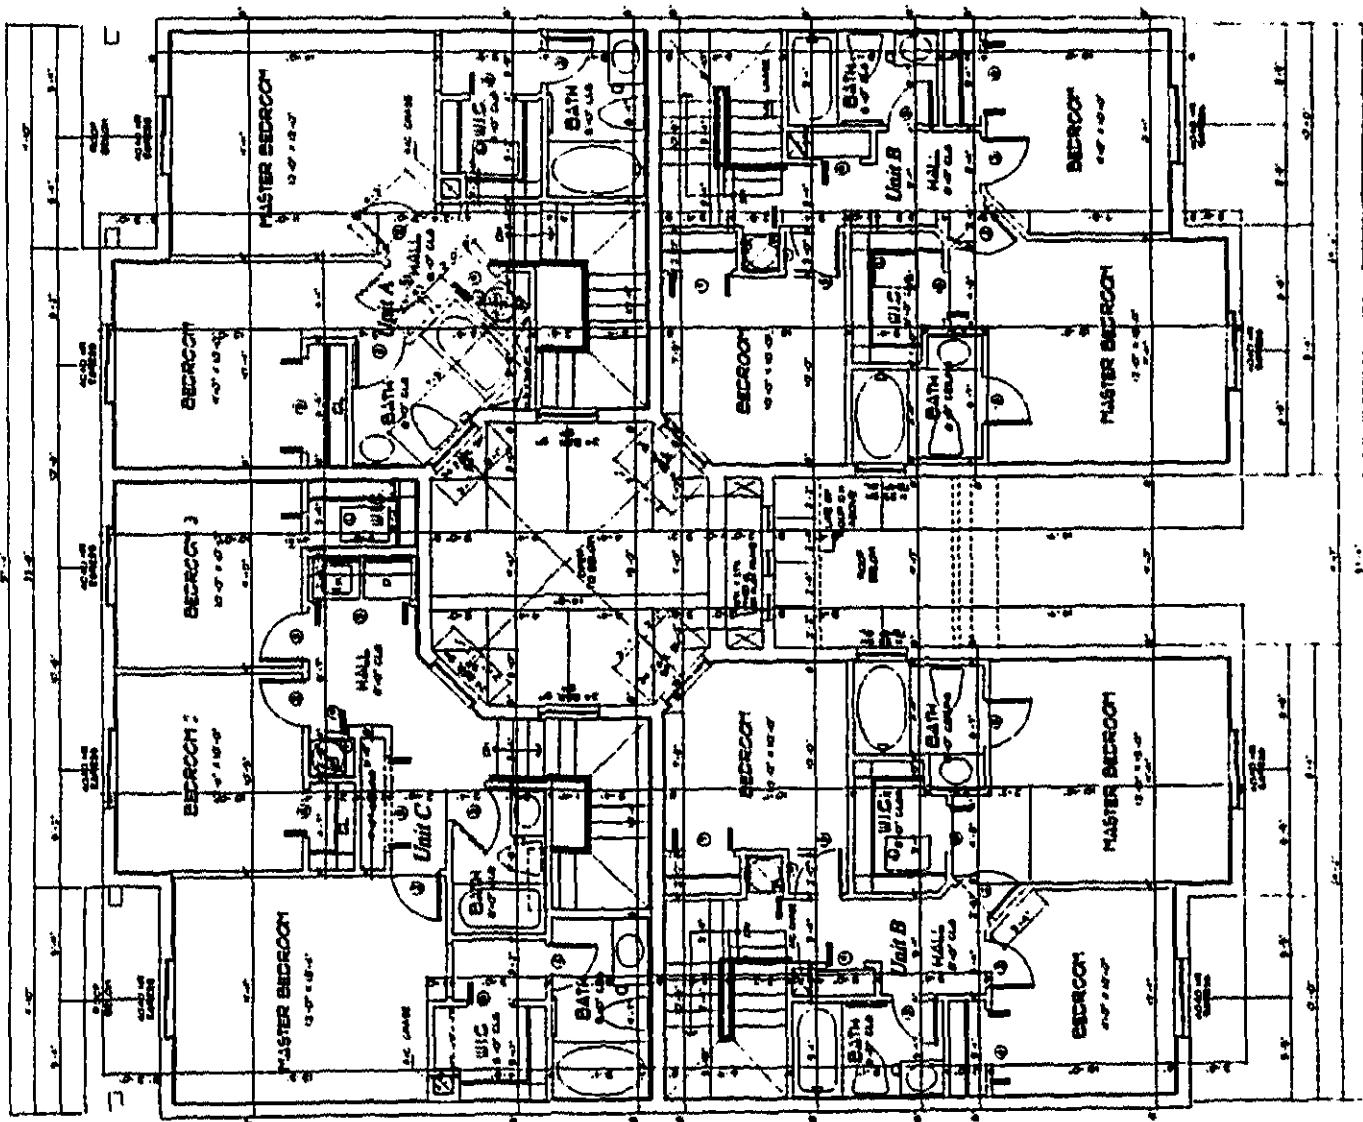


THIRD FLOOR PLAN  
SCALE: 1" = 10'

MANUEL FELIPE, P.S.M.  
Professional Surveyor and Mapper  
1000 SW 1st Street, Suite 802, Miami, Florida 33134  
Phone: (305) 255-8508 - Fax: (305) 255-8682

EXHIBIT "PAGE 11  
CENTURY PARK CONDOMINIUM NO. 2  
A CONDOMINIUM  
FLOOR PLAN  
Date: 3/22/22  
Page: 11  
Sheet: 11  
Scale: 1" = 10'

20512PGI136

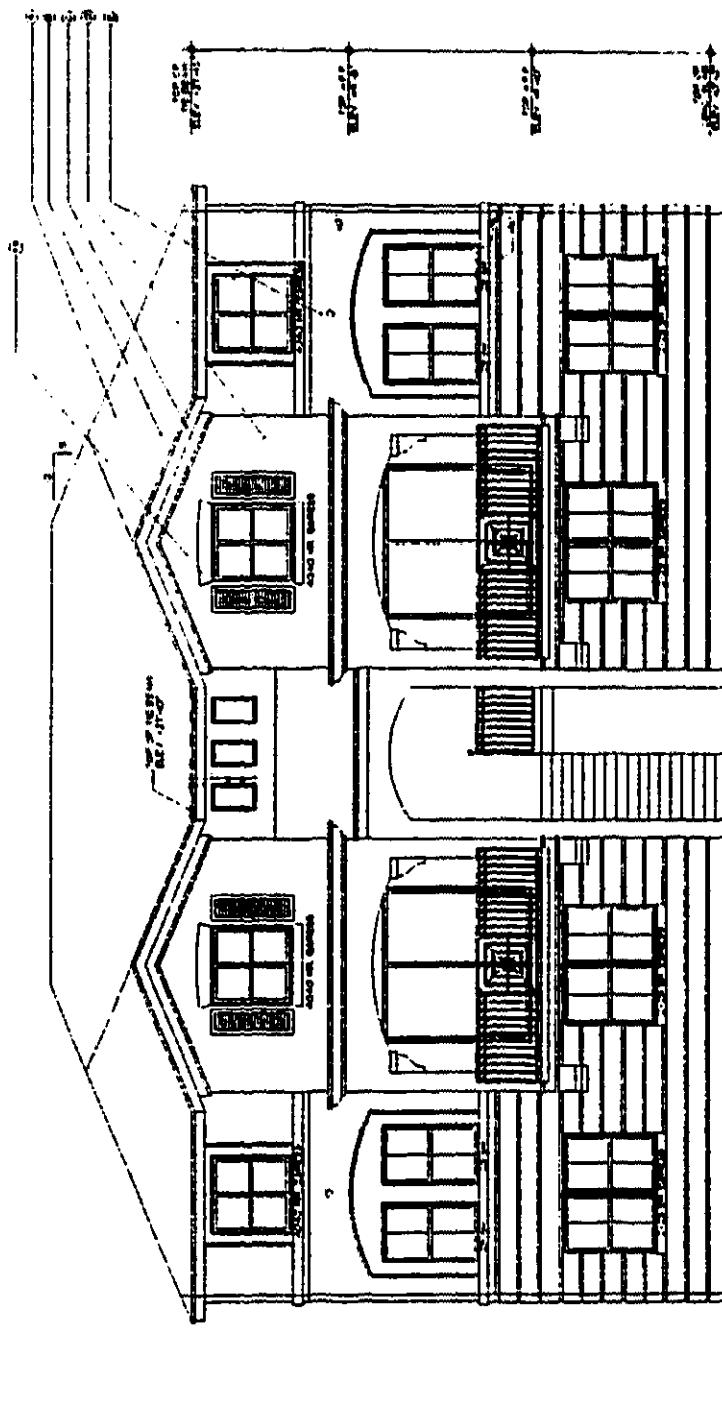

COURTYARD ELEVATION      SCALE: 1" = 10'

NOTE:  
ALL IMPROVEMENTS ARE PROPOSED





**MANUEL FELIPE, P.S.M.**  
Professional Surgeon and Mapper  
5000 SW 6th Street, Suite 200; Miami, Florida  
Phone: (305) 225-5200 - Fax: (305) 225-9121

**EXHIBIT "C" PAGE 12**  
**CENTURY PARK CONDOMINIUM No. 2**

MAY 30 2002

20512PG1137

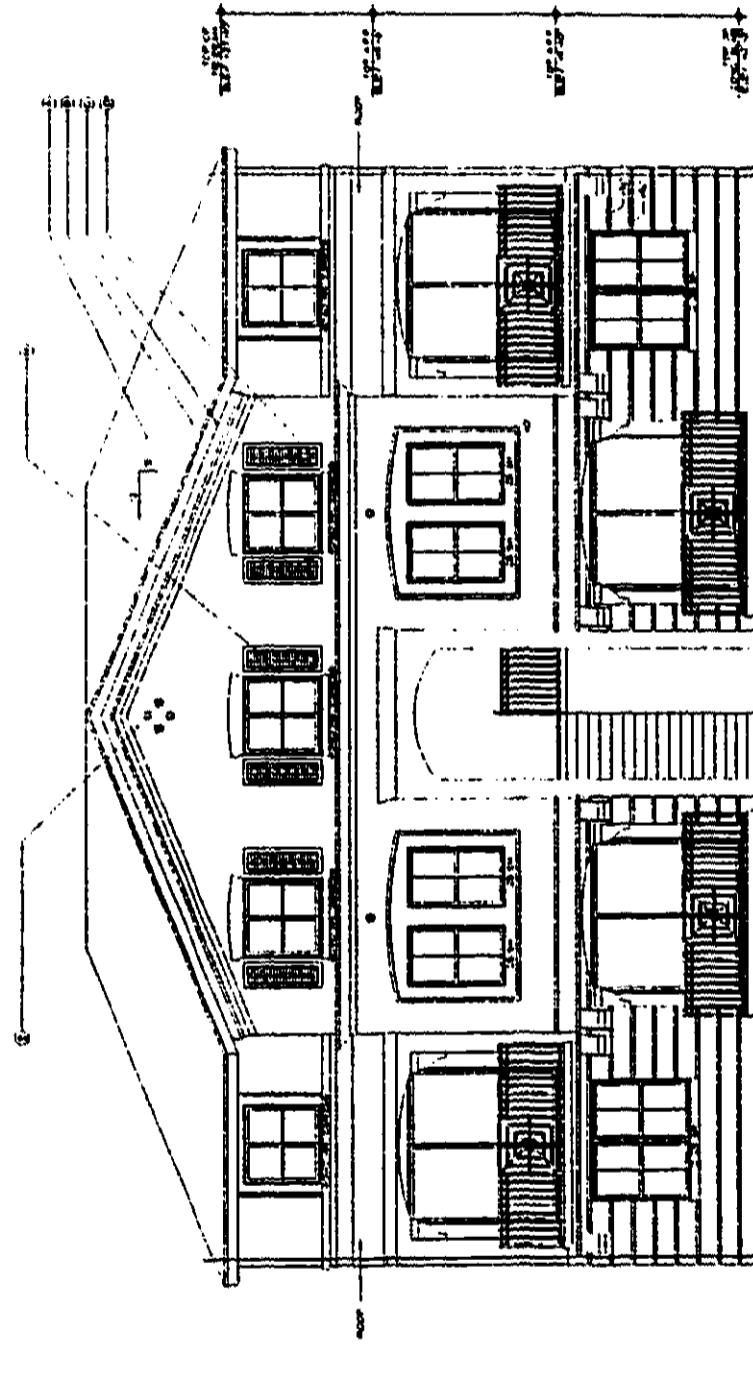

STREET ELEVATION  
SCALE: 1" = 10'

SCALE: 1 = 10'

**MANUEL FELIPE, P.S.M.**  
 Professional Surveyor and Mapper  
 6500 S.W. 6th Street, Suite 202, Miami, Florida 33146  
 Phone: (305) 253-6306 • Fax: (305) 253-9042

**EXHIBIT "B" PAGE 13**  
**CENTURY PARK CONDOMINIUM No. 2**  
A **LANDMARK**


NOTE: ALL IMPROVEMENTS ARE PROPOSED

20

CENTURY PARK CONDOMINIUM No. 2  
EXHIBIT "B" PAGE 13


20512PG1138

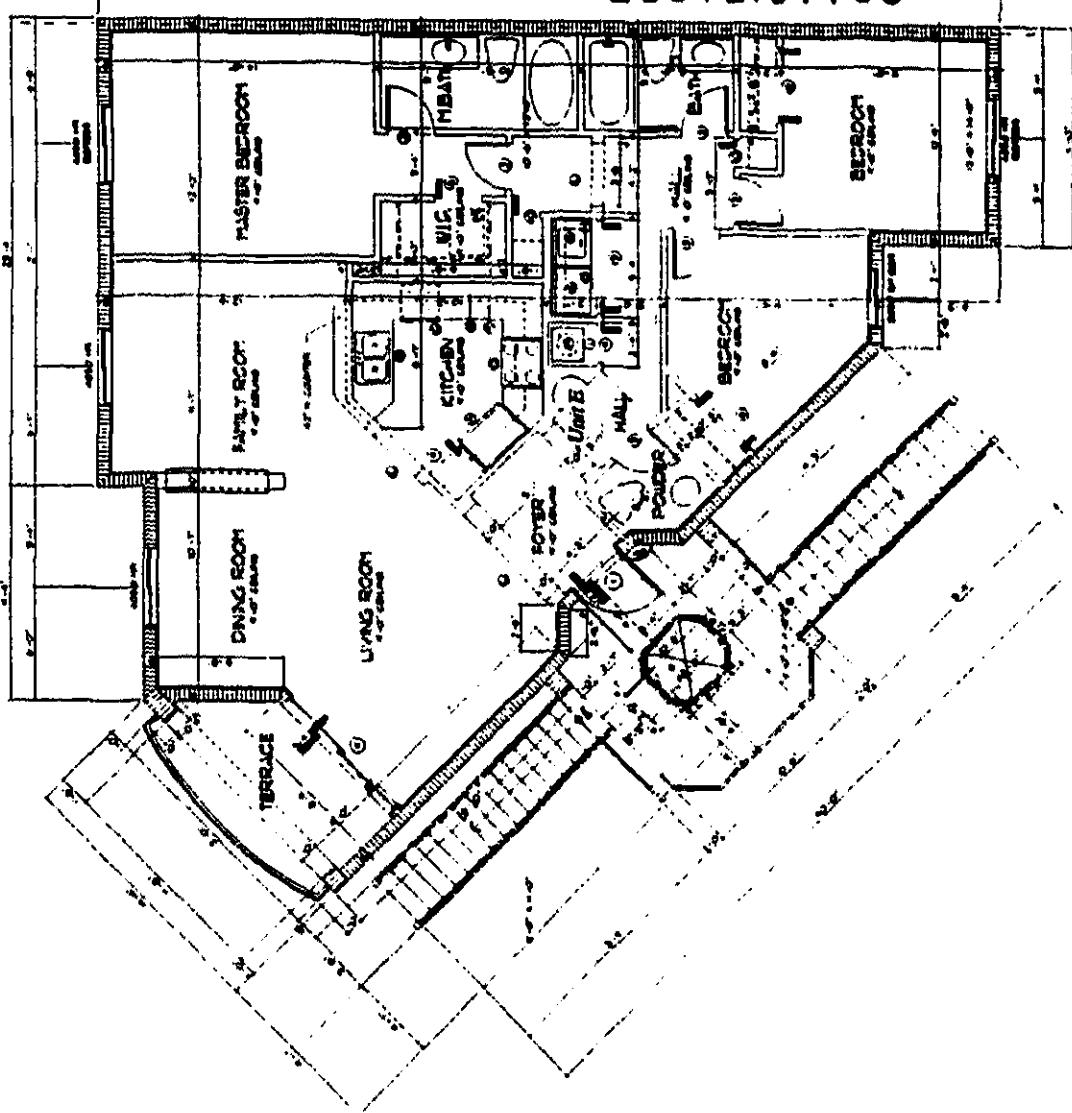


SECOND FLOOR PLAN - CORNER UNIT

SCALE: 1" = 10'

**MANUEL FELIPE, P.S.M.**  
 Professional Surveyor and Mapper  
 8500 S.W. 6th Street, Suite 200, Miami, Florida 33144  
 Phone: (305) 265-6368 - Fax: (305) 265-9052

**EXHIBIT "C" PAGE 14**  
**CENTURY PARK CONDOMINIUM No. 2**  
 A CONDOMINIUM

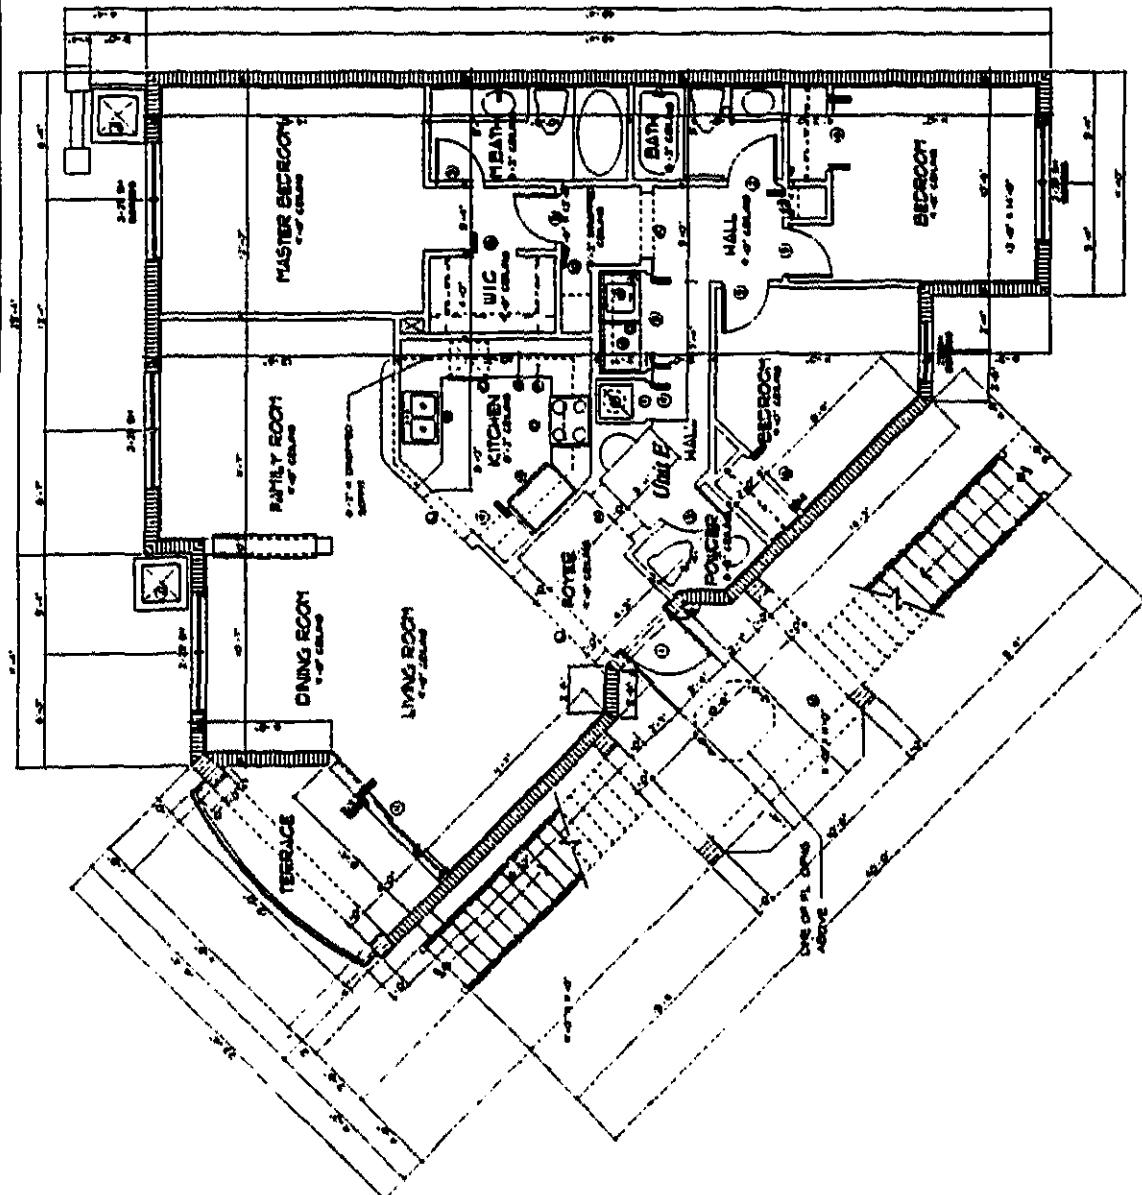ALL IMPROVEMENTS ARE PROPOSEDNOTE:

FIRST FLOOR PLAN - CORNER UNIT

SCALE: 1" = 10'

MAY 30 2002


20512PG1139

**MANUEL FELIPE, P.S.M.**  
 Professional Services and Design  
 6500 S.W. 6th Street, Suite 202, Miami, Florida 33164  
 Phone: (305) 255-8500 - Fax: (305) 855-9042

**EXHIBIT "PAGE 15**  
**CENTURY PARK CONDOMINIUM NO. 2**

A CONDOMINIUM  

**NOTE:**  
**ALL IMPROVEMENTS ARE PROPOSED**

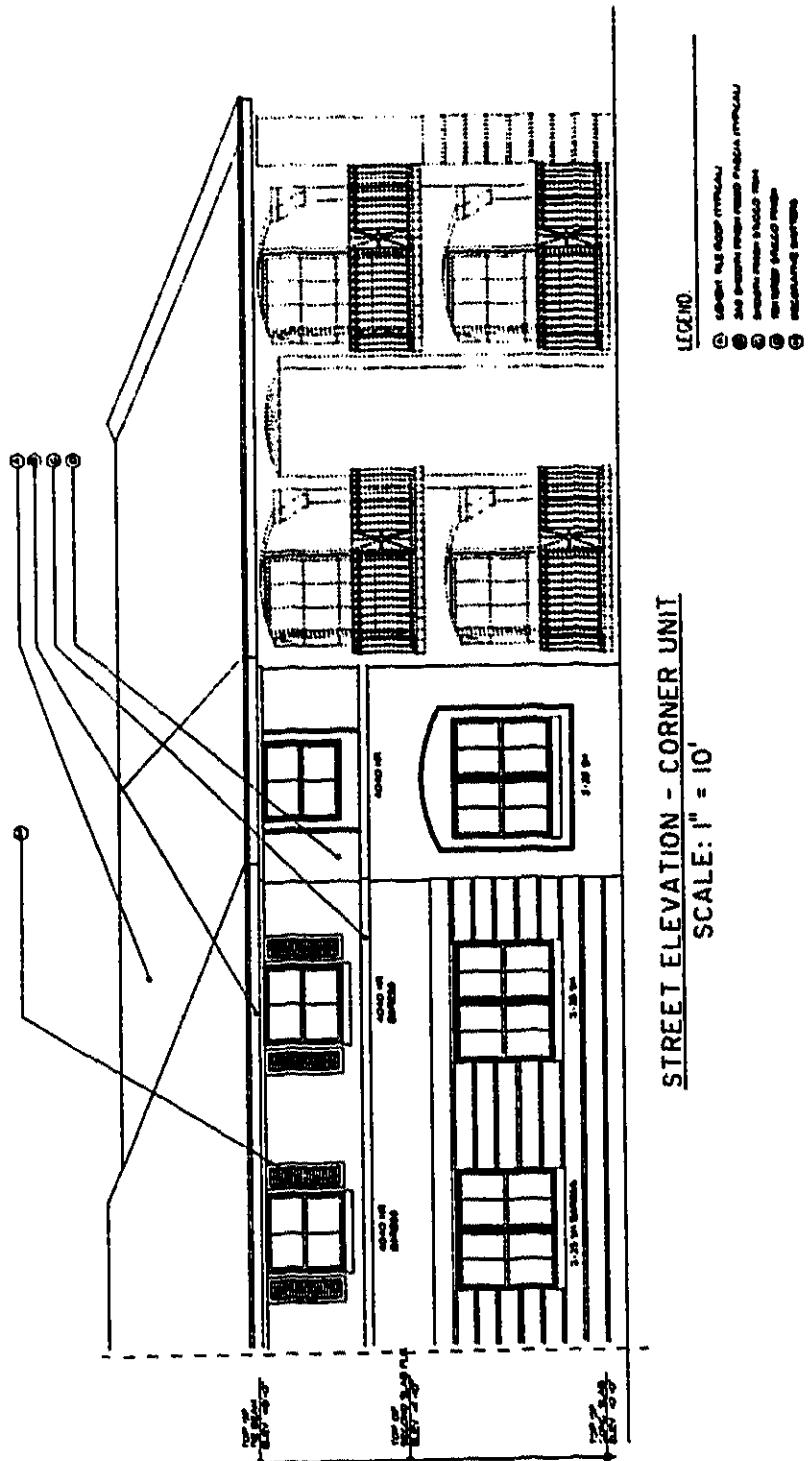

20512PGI140

## ALL IMPROVEMENTS ARE PROPOSED


**MANUEL FELIPE, P.S.M.**  
Professional Surveyor and Mapper  
1000 N.W. 10th Street, Suite 200, Miami, Florida 33144  
Phone: (305) 253-8300 • Fax: (305) 253-8082

**EXHIBIT " " PAGE 16  
CENTURY PARK CONDOMINIUM No. 2**



SECOND FLOOR PLAN  
SCALE: 1" = 10'


SCALE: 1" = 10'

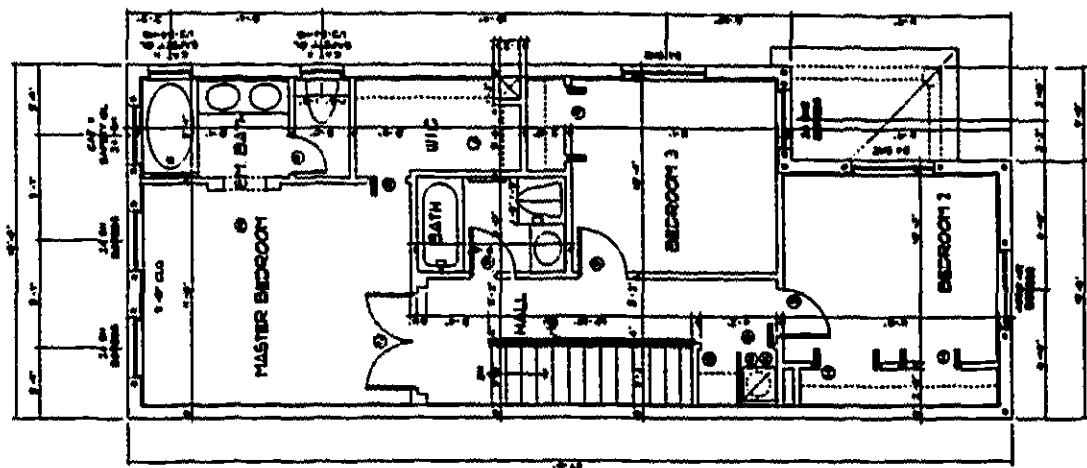


FIRST FLOOR PLAN  
SCALE: 1" = 10'

HSI FLUOR PL  
SCALE: 1" = 10'

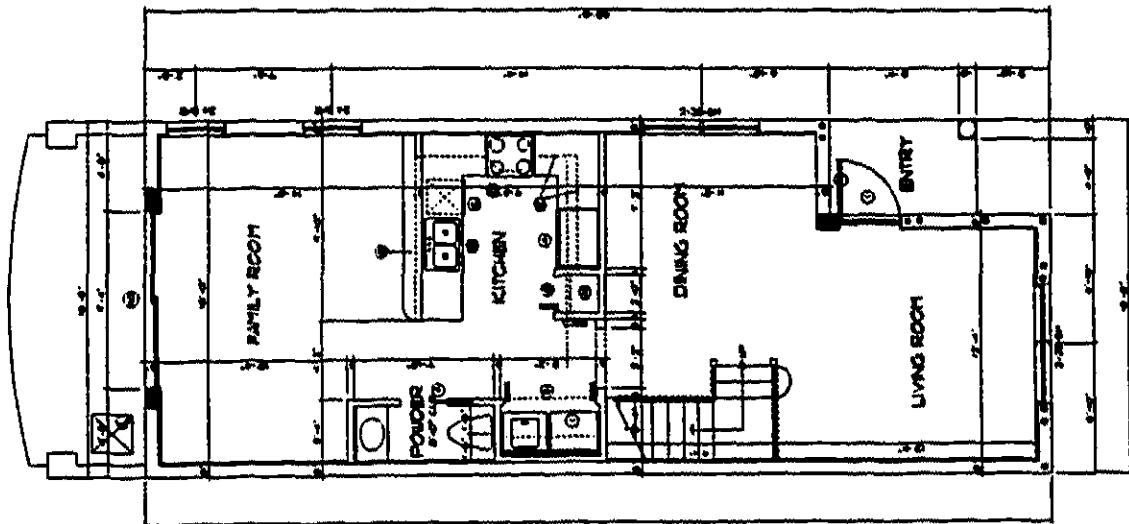


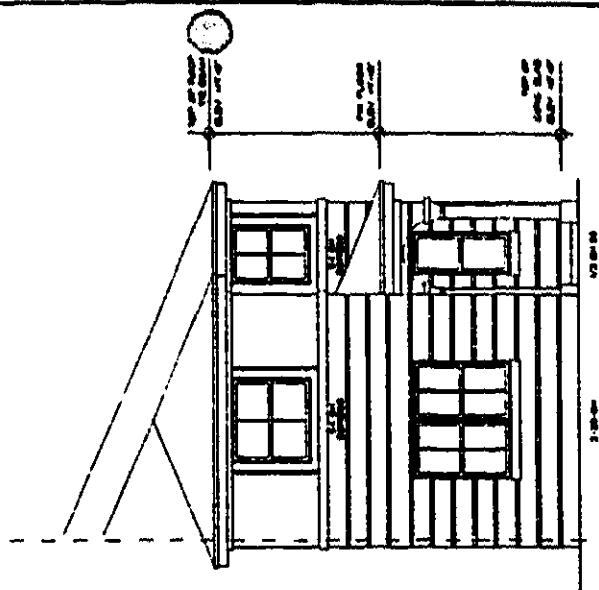

FRONT ELEVATION  
SCALE: 1" = 10'

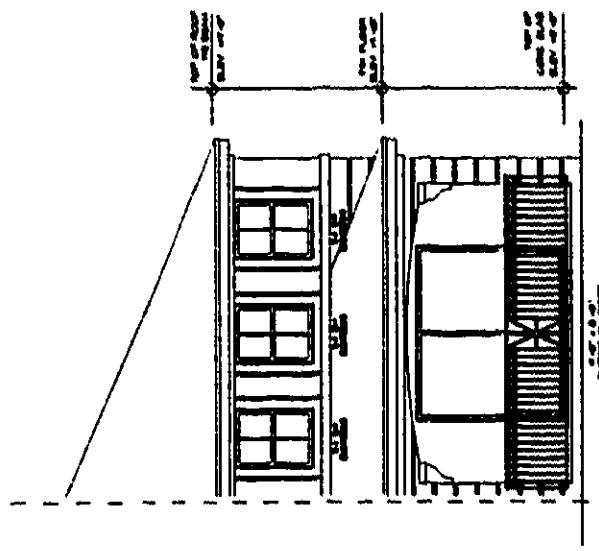

REAR ELEVATION  
SCALE: 1" = 10'

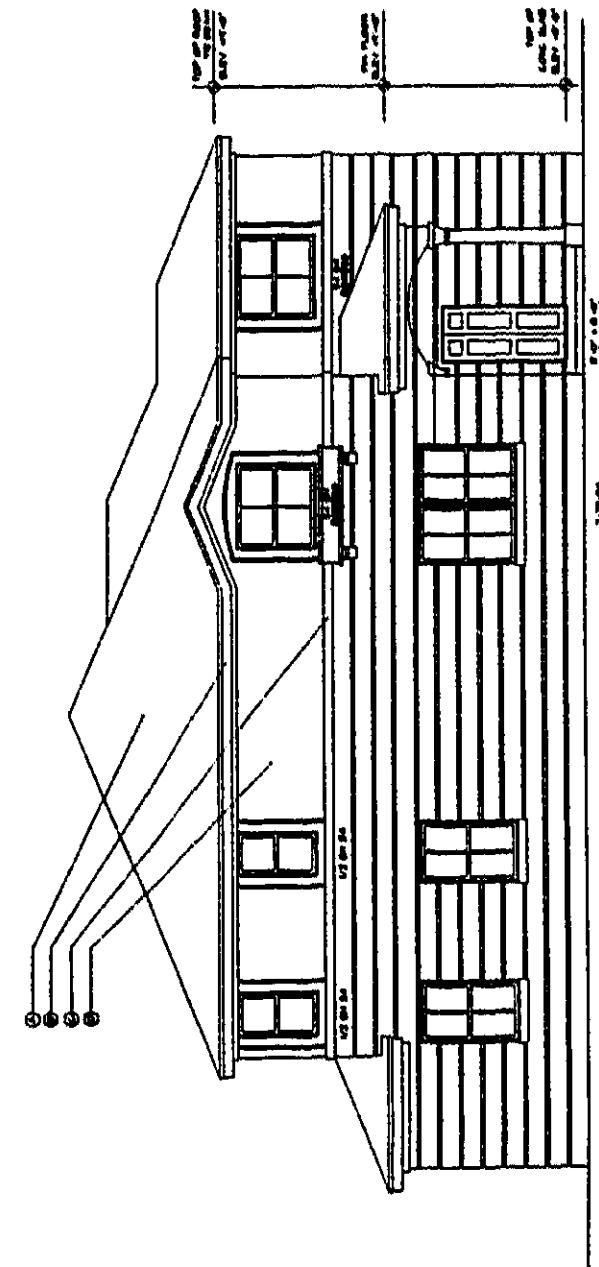

SIDE ELEVATION  
SCALE: 1" = 10'

LEGEND



**MANUEL FELIPE, P.S.M.**  
Professional Surveyor and Mapper  
4630 S.W. 6th Street, Suite 200, Miami, Florida 33144  
Phone: (305) 263-5300 - Fax: (305) 263-9052

**EXHIBIT " " PAGE 17**  
**CENTURY PARK CONDOMINIUM No. 2**  
**A CONDOMINIUM**  

**NOTE:**  
**ALL IMPROVEMENTS ARE PROPOSED**

20512PG1142

# *Century Park Condominium No. 2 - Recreation Building*

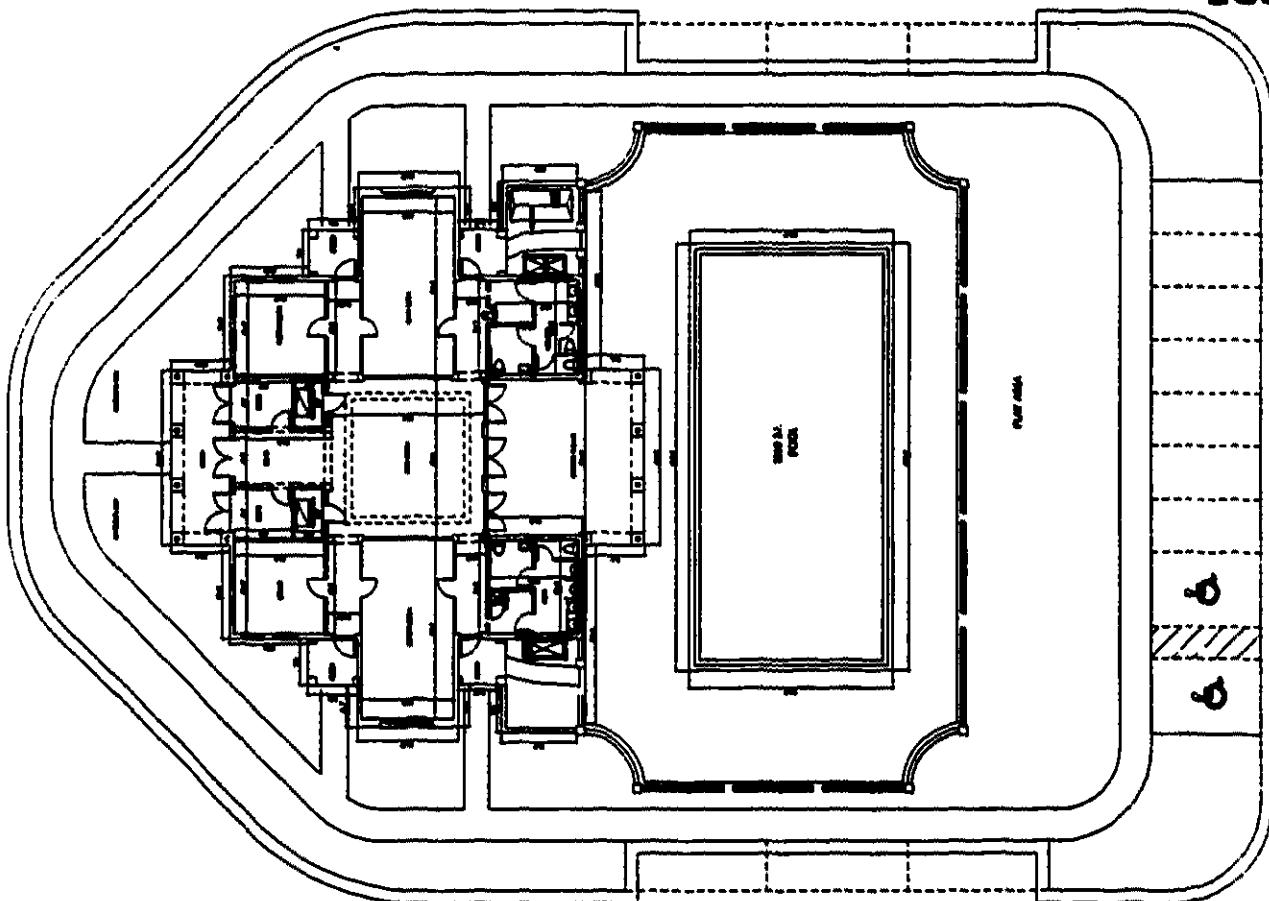

Scale:  
1" = 30'

<b>NOE AGUILAR, PSM</b> PROFESSIONAL SURVEYOR & MAPPER 8210 SW 32nd STREET MIAMI, FL 33155 (305) 554-0456	<b>EXHIBIT "C" PAGE 18</b> <b>CENTURY PARK CONDOMINIUM No 2</b> A CONDOMINIUM RECREATION BLDG FLOOR PLAN AS BLDG 1
MM 04/15/02 <small>RECEIVED MIAMI Dade COUNTY CLERK'S OFFICE 04/15/02</small>	MM 04/15/02 <small>RECEIVED MIAMI Dade COUNTY CLERK'S OFFICE 04/15/02</small>

**NOTE**  
**COMMON ELEMENTS:**  

MAY 30 2002






FLAGLER ST.

N89°49'55"E

1320.00'

592.03  
N00°24'31"E592.03  
N00°24'31"E

## CENTURY PARK TRACT - "A"

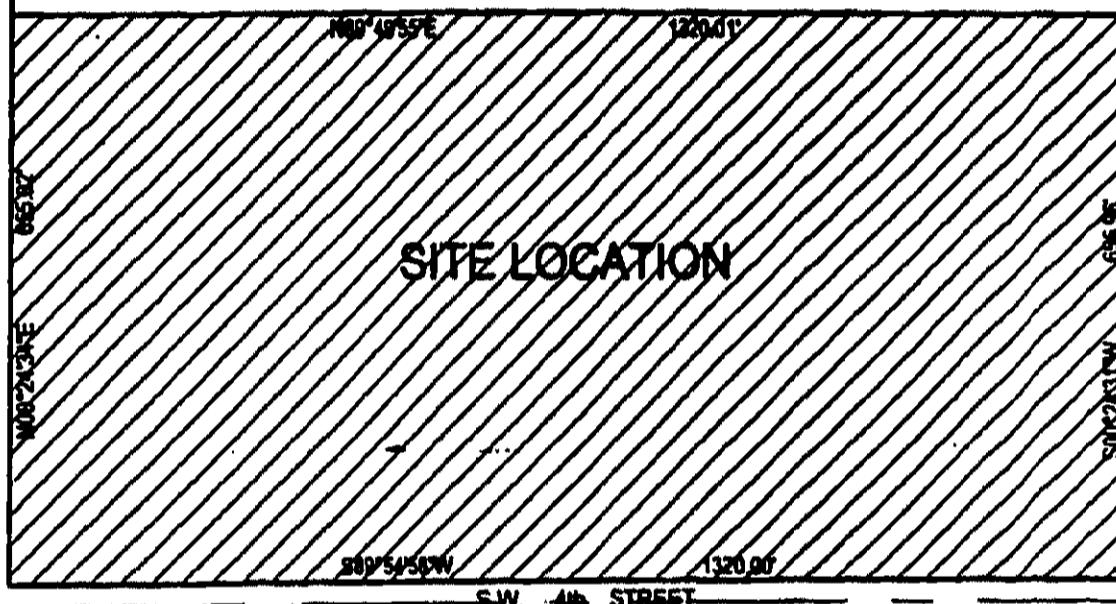

## LOCATION MAP

N.T.S.

### SURVEYOR'S NOTES:

- 1)- North arrow direction and Bearings shown hereon are based on an assumed value of: N89deg49min55secE along the East line of of Tract "A" of "CENTURY PARK" Plat Book 157 at Page 19 of the Public Records of Miami-Dade County Florida.

### LEGAL DESCRIPTON :

A portion of Tract "A" of "CENTURY PARK" according to the plat thereof as recorded in Plat Book 157 Page 19 of the Public Records of Miami-Dade County, Florida being more particularly described as follows:

Commence at the Northwest corner of said Tract "A"; thence S00deg24min34secW along the West line of said Tract "A", for a distance of 592.03 feet to the POINT OF BEGINNING of the herein described parcel; thence N89deg49min55secE for a distance of 1320.01 feet; thence S00deg24min31secW along the East line of said Tract "A" for a distance of 656.96 feet; thence S89deg54min58secW along the South line of said Tract "A" for a distance of 1320.00 feet; thence N00deg24min34secE along the West line of said Tract "A" for a distance of 655.02 feet to the POINT OF BEGINNING.



L702 S.E. 10th CENTRE 2nd FLOOR  
MIAMI FLORIDA 33160  
TEL (305) 379-4441 FAX (305) 379-4387

PROJECT NAME

## CENTURY PARK CONDOMINIUM No.2

REF# 2-26-2002

PROJECT TYPE

SKETCH AND LEGAL

NAME N/A

DRAWN BY



R. CABRERA

PROJECT NO. N/A

DUE DATE/REV.#

0000

## GRAPHIC SCALE

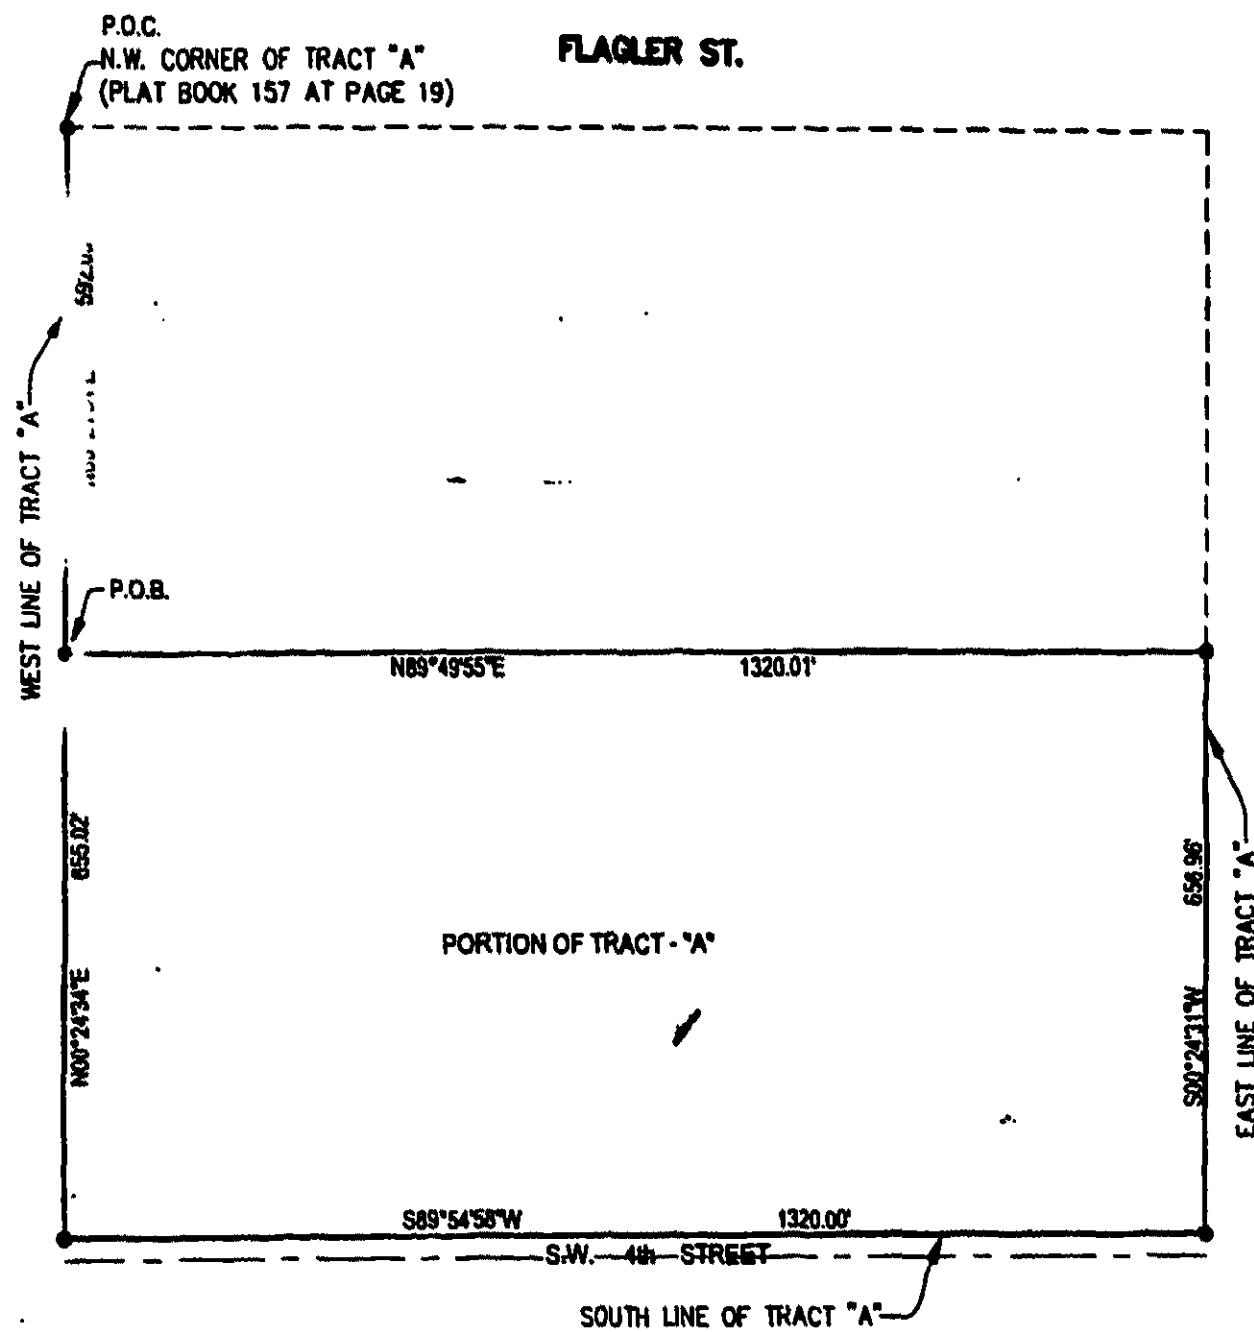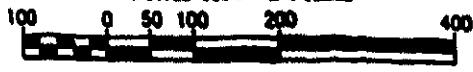

## LEGEND:

- P.O.C. - POINT OF COMMENCEMENT  
P.O.B. - POINT OF BEGINNING  
P.O.T. - POINT OF TERMINATION



1570 SW 1400 CIRCLE, SUITE 200  
MIAMI, FLORIDA 33133  
(305) 570-0443 FAX (305) 570-0449

## PROJECT NAME

**CENTURY PARK CONDOMINIUM No.2**

DATE	2-26-2002	PROJECT TYPE	SKETCH AND LEGAL
SCALE	1"=200'	DESIGN BY	R. CABRERA
PROJECT NO.	N/A	DES. CHECKED BY	

20512PG1146

**CERTIFICATE OF SURVEYOR**

THE UNDERSIGNED, A LICENSED AND REGISTERED LAND SURVEYOR, DULY AUTHORIZED TO PRACTICE UNDER THE LAWS OF THE STATE OF FLORIDA, DOES HEREBY CERTIFY THAT, NOTWITHSTANDING THE FACT THAT CERTAIN BUILDINGS IN THE CONDOMINIUM ARE NOT SUBSTANTIALLY COMPLETED, THE BUILDING(S) AND UNITS DESCRIBED "AS-BUILT" HEREIN ARE COMPLETED, AND THAT, AS TO SUCH UNITS AND IMPROVEMENTS, THE CONSTRUCTION OF THE IMPROVEMENTS DESCRIBED HEREIN, INCLUDING, BUT NOT LIMITED TO, LANDSCAPING, UTILITY SERVICES AND ACCESS TO SUCH COMPLETED UNITS, AND FACILITIES SERVING THE COMPLETED BUILDINGS IN WHICH SUCH COMPLETED UNITS ARE LOCATED, HAVE BEEN SUBSTANTIALLY COMPLETED SO THAT THIS EXHIBIT TO THE AMENDMENT TO DECLARATION OF CONDOMINIUM OF CENTURY PARK CONDOMINIUM No. 2 ADDING BUILDING 19, TOGETHER WITH THE PROVISIONS OF THE AFORESAID DECLARATION, CONSTITUTE A CORRECT REPRESENTATION OF SUCH COMPLETED IMPROVEMENTS DESCRIBED HEREIN AND, FURTHER, THAT THE IDENTIFICATION, LOCATION AND DIMENSIONS OF THE COMMON ELEMENTS, LIMITED COMMON ELEMENTS SERVING SUCH COMPLETED UNITS AND ALL OF SUCH COMPLETED UNITS MAY BE DETERMINED FROM SAID MATERIALS. I FURTHER CERTIFY THAT THIS SURVEY MEETS THE MINIMUM TECHNICAL STANDARDS SET FORTH BY THE FLORIDA BOARD OF LAND SURVEYORS PURSUANT TO CHAPTER 472 OF THE FLORIDA STATUTES.

DATED THIS TEN DAY OF JUNE, 2002.

NOE AGUILAR  
PROFESSIONAL SURVEYOR & MAPPER  
CERTIFICATE No. 5571  
STATE OF FLORIDA

BY: Noe Aguilar**EXHIBIT "B"**


PAGE 22

**Century Park Condominium No. 2 - Building 19**


WEST FLAGLER STREET

UNIT 1/2 COND  
SECTION 4-24-0

LIMITED COMMON ELEMENTS  
CENTURY PARK (1st-10)  
(Point of Convergence)

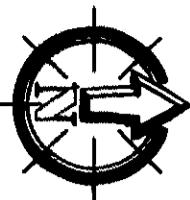

Scale:  
1" = 200'

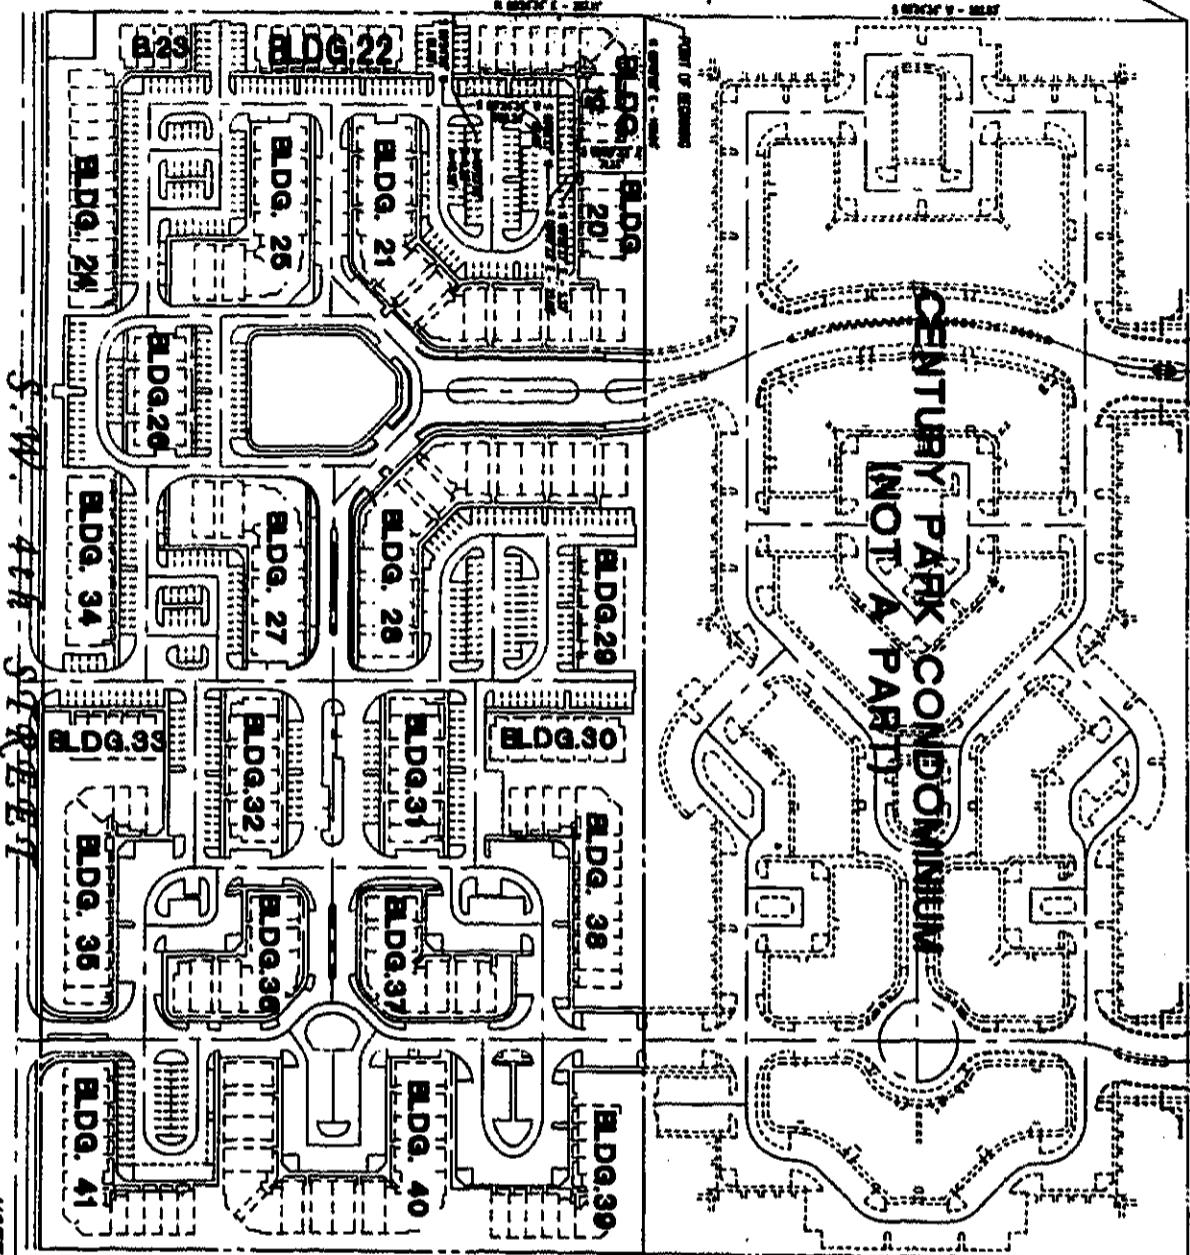

**S.W. 87th AVENUE  
(GALLOWAY ROAD)**

**LEGAL DESCRIPTION**


**COMMON ELEMENTS:**  
Existing widths of the walls and parking spaces shall be  
common elements.

**LIMITED COMMON ELEMENTS:**  
All parking spaces shall be considered as LIMITED COMMON ELEMENTS.

Existing widths of the walls and parking spaces shall be  
common elements.

For a distance of 100.00 feet to a point; then run Southwesterly  
27° East for a distance of 71.11 feet to a point; then run South  
49° 27' East for a distance of 1.37 feet to a point; then run South  
49° 27' East for a distance of 25.00 feet to a point;  
then run South 49° 27' East for a distance of 61.00 feet to a  
point; then run South 49° 27' East for a distance of 161.24  
feet to a point or a portion of a circular curve concave to the  
North; then run northerly by along the arc of said curve  
bearing for its elements a central angle of 60° 37' 00" and a radius  
of 8.28 feet, for an arc distance of 16.32 feet to a point or a point  
bearing from South 49° 27' East for a distance of 16.32  
feet to a point on the East line of the aforementioned front 100.  
feet and then 49° 27' 00" feet along the next line of the said  
front 100.00 feet for a distance of 207.11 feet to the Point of Beginning.

NOE AGUILAR			
PROFESSIONAL SURVEYOR & MAPPER No 5571			
6210 S W 32nd STREET, MIAMI, FL 33155			
(305) 554-8456			
EXHIBIT "B" PAGE 23			
CENTURY PARK CONDOMINIUM No. 2			
A CONDOMINIUM			
BUILDING NAME FEES LEGAL DESCRIPTION (AS-SUBLI)			
AS-BLDG. 7			
RECEIVED	05/14/02	RECD	FILED
FLA	EL-201	FIVE	1-334
RECEIVED	05/14/02	RECD	245/02 4-43
FLA		WATER	4-33

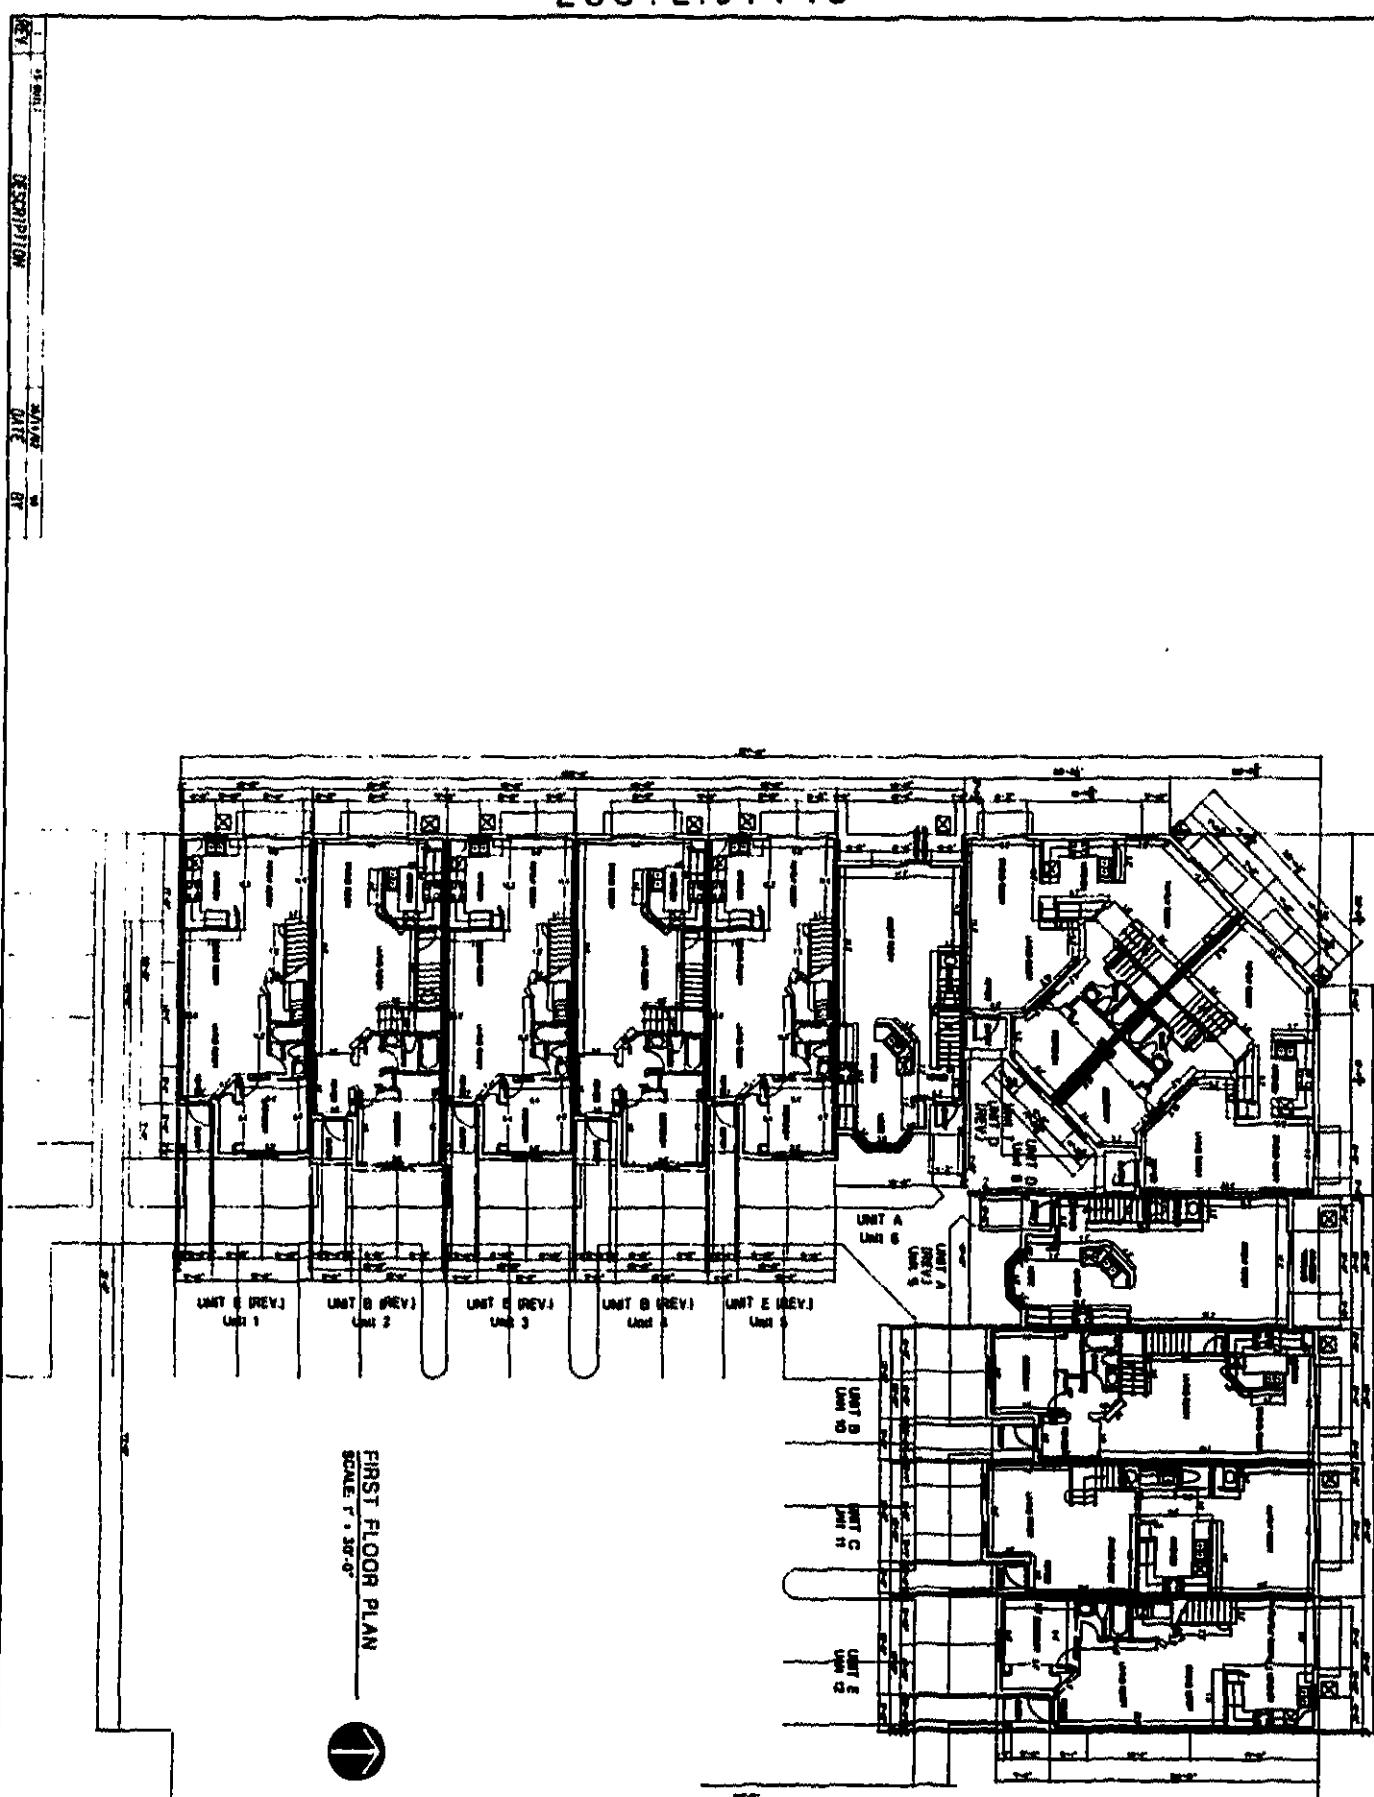


NOE AGUILAR  
PROFESSIONAL SURVEYOR & MAPPER #6 5571  
8210 S.W. 32nd STREET, MIAMI, FL. 33155  
(305) 554-8456

**EXHIBIT "B" PAGE 24**  
**CENTURY PARK CONDOMINIUM No. 2**

BUILDING NAME/TECHNICAL INFORMATION  
FIRST FLOOR PLAN - AS-BUILT

DATE	05/14/02	NAME	NOE AGUILAR
TIME	EL-201	FILE	4-000
REVISION	10	REF.	26/11/02 • 0005
SCALE	1" = 20'-0"	WEIGHT	4-01

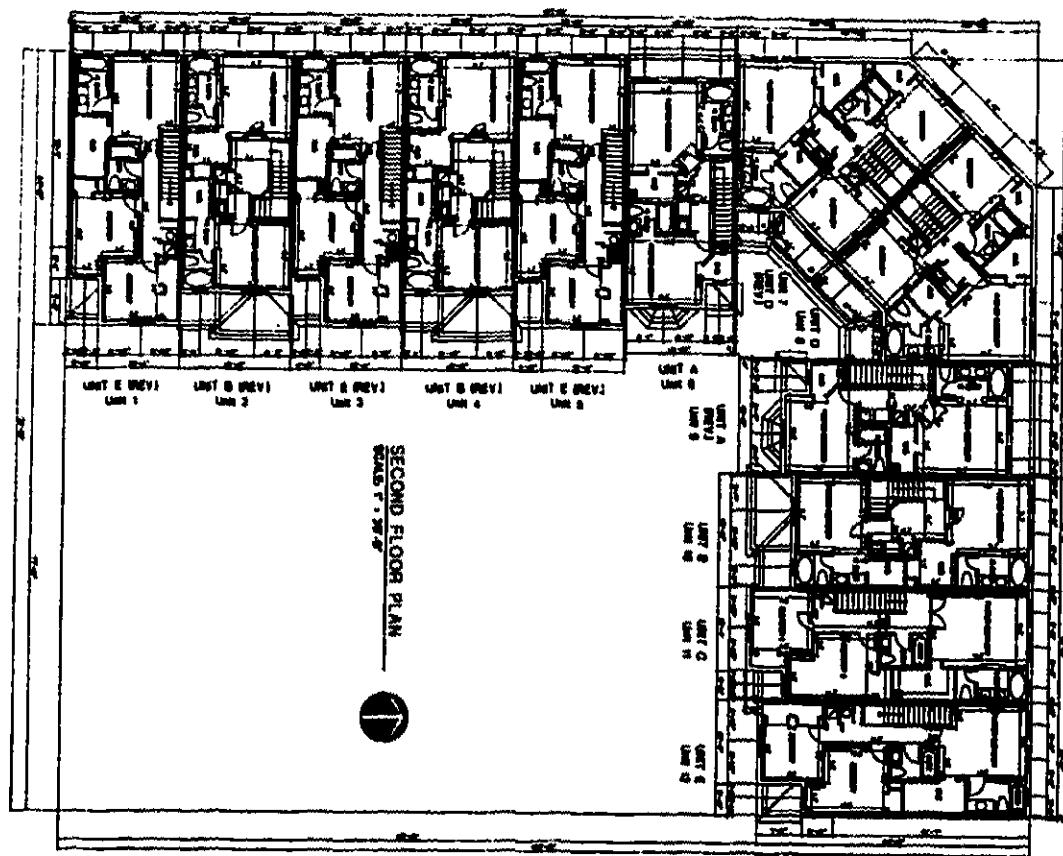

PROFESSIONAL SURVEYOR & MAPPER NO 5571	
<b>EXHIBIT "B" PAGE 25</b>	
<b>CENTURY PARK CONDOMINIUM No. 2</b>	
<b>a CONDOMINIUM</b>	
<b>SECTION</b>	<b>DATE</b>
MM	06/14/02
<b>PLAT</b>	
EL 201	
<b>RECORD</b>	
FILE	
4-02	

20512 PG 1150

**CERTIFICATE OF SURVEYOR**

THE UNDERSIGNED, A LICENSED AND REGISTERED LAND SURVEYOR, DULY AUTHORIZED TO PRACTICE UNDER THE LAWS OF THE STATE OF FLORIDA, DOES HEREBY CERTIFY THAT, NOTWITHSTANDING THE FACT THAT CERTAIN BUILDINGS IN THE CONDOMINIUM ARE NOT SUBSTANTIALLY COMPLETED, THE BUILDING(S) AND UNITS DESCRIBED "AS-BUILT" HEREIN ARE COMPLETED, AND THAT, AS TO SUCH UNITS AND IMPROVEMENTS, THE CONSTRUCTION OF THE IMPROVEMENTS DESCRIBED HEREIN, INCLUDING, BUT NOT LIMITED TO, LANDSCAPING, UTILITY SERVICES AND ACCESS TO SUCH COMPLETED UNITS, AND FACILITIES SERVING THE COMPLETED BUILDINGS IN WHICH SUCH COMPLETED UNITS ARE LOCATED, HAVE BEEN SUBSTANTIALLY COMPLETED SO THAT THIS EXHIBIT TO THE AMENDMENT TO DECLARATION OF CONDOMINIUM OF CENTURY PARK CONDOMINIUM No. 2 ADDING BUILDING 20, TOGETHER WITH THE PROVISIONS OF THE AFORESAID DECLARATION, CONSTITUTE A CORRECT REPRESENTATION OF SUCH COMPLETED IMPROVEMENTS DESCRIBED HEREIN AND, FURTHER, THAT THE IDENTIFICATION, LOCATION AND DIMENSIONS OF THE COMMON ELEMENTS, LIMITED COMMON ELEMENTS SERVING SUCH COMPLETED UNITS AND ALL OF SUCH COMPLETED UNITS MAY BE DETERMINED FROM SAID MATERIALS. I FURTHER CERTIFY THAT THIS SURVEY MEETS THE MINIMUM TECHNICAL STANDARDS SET FORTH BY THE FLORIDA BOARD OF LAND SURVEYORS PURSUANT TO CHAPTER 472 OF THE FLORIDA STATUTES.

DATED THIS 20 DAY OF 1/16/02, 2002.

NOE AGUILAR  
PROFESSIONAL SURVEYOR & MAPPER  
CERTIFICATE No. 5571  
STATE OF FLORIDA

BY: Noe Aguilar**EXHIBIT B**

PAGE 26

# Century Park Condominium No. 2 - Building 20

WEST FLAGLER STREET

WEST SIDE BLOCK N<sup>o</sup>

CENTURY PARK (USP-10)


(From or Conveyance)

EAST 1/4 CORNER  
SECTION 4-1-2

Scale:  
1" = 200'



CENTURY PARK CONDOMINIUM  
NOT A PARK

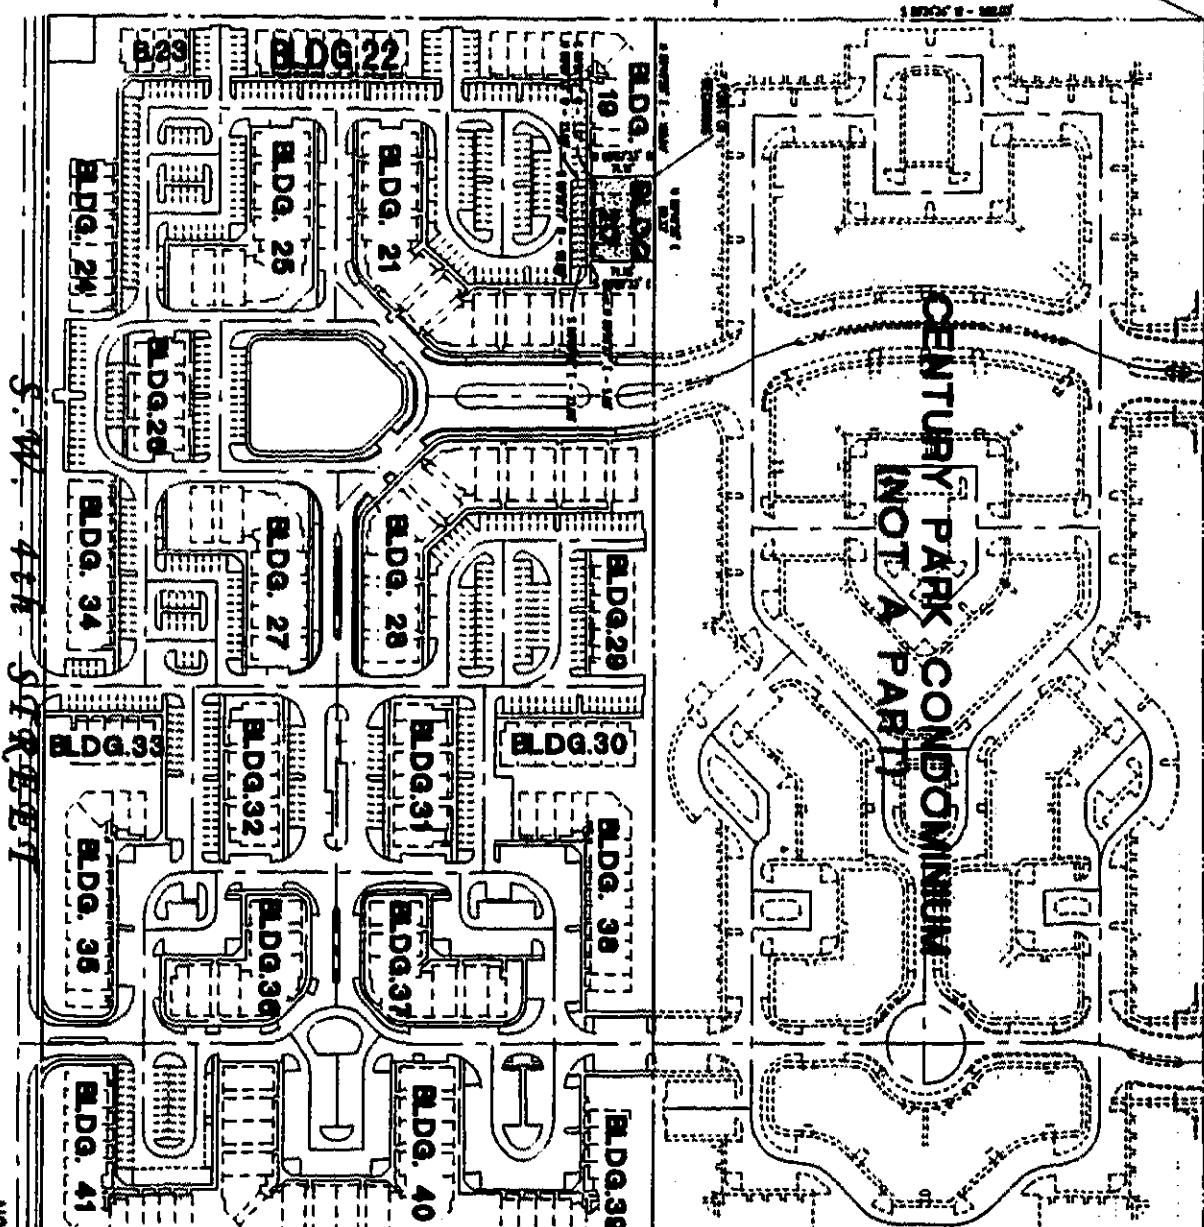

S.W. 87th AVENUE  
(GALLOWAY ROAD)

#### USE, DESCRIPTION BUILDING NUMBER:

Commons of the Northwest corner of Block "N" of "Century Park" according to the first Survey as recorded in Plat Book 157, Page 18 of the Public Records of Miami-Dade County, Florida. Land Area 0.1200 acres. Building the entire line of said tract 17' for a distance of 200.00 feet to a point; thence run North 49° 50' East for a distance of 100.00 feet to the Point of Beginning of the Northerly described parcel; thence continue North 49° 50' East for a distance of 48.33 feet to a point; thence run South 49° 50' East for a distance of 71.18 feet to a point; thence run South 49° 50' East for a distance of 5.00 feet to a point; thence run South 49° 50' East for a distance of 22.00 feet to a point; thence run South 49° 50' East for a distance of 26.00 feet to a point; thence run North 49° 50' East for a distance of 21.00 feet to a point; thence run South 49° 50' East for a distance of 1.37 feet to a point; thence run North 49° 50' East for a distance of 20.77 feet for a distance of 22.11 feet to the Point of Beginning.


EXHIBIT "B" PAGE 27			
CENTURY PARK CONDOMINIUM No.			
A CONDOMINIUM BUILDING TWENTY LEGAL DESCRIPTION (AS-BUL-7)			
NAME	NOE AGUILAR	PROFESSIONAL SURVEYOR & MAPPER No. 5571	8210 S.W. 32nd STREET, MIAMI, FL 33156 (305) 551-8456

**NOTE**  
**COMMON ELEMENTS:**  
Existing portions of the walls and parking spaces shall be  
common to all common elements.  
**LIMITED COMMON ELEMENTS:**  
All parking spaces shall be considered as limited common elements.

NAME DATE  


FIRST FLOOR PLAN - BUILDING 20  
SCALE 1" = 20'-0"

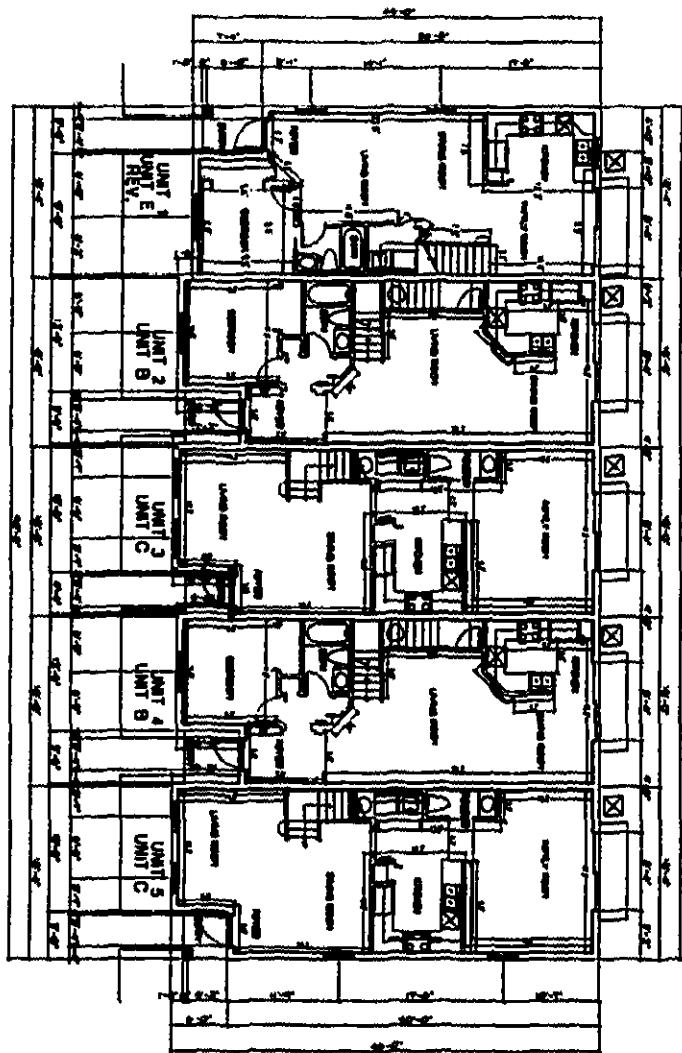

NOE AGUILAR  
PROFESSIONAL SURVEYOR & MAPPER No. 5571  
8210 S.W. 32nd STREET, MIAMI, FL 33155  
(305) 554-6456

EXHIBIT "B" PAGE 28  
CENTURY PARK CONDOMINIUM No.  
A CONDOMINIUM  
BUILDING TWENTY (20)  
FIRST FLOOR PLAN - AS BUILT



20512PG1153


**SECOND FLOOR PLAN**

SCALE: 1 : 28.8

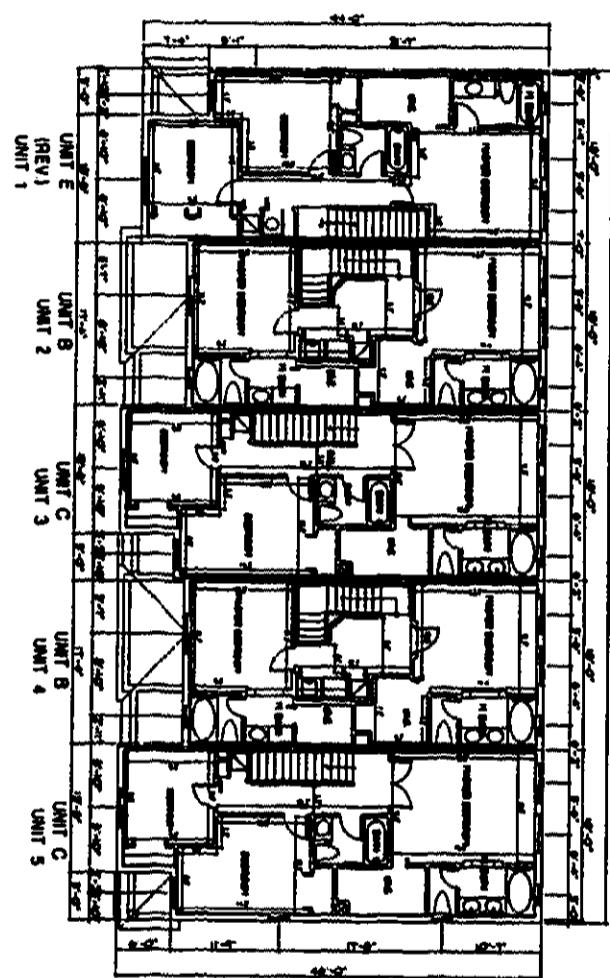

PROFESSIONAL SURVEYOR & MAPPER NO. 5371  
8210 S.W. 32ND STREET, MIAMI, FL 33155  
(305) 534-0456

20512PG1154

**CERTIFICATE OF SURVEYOR**

THE UNDERSIGNED, A LICENSED AND REGISTERED LAND SURVEYOR, DULY AUTHORIZED TO PRACTICE UNDER THE LAWS OF THE STATE OF FLORIDA, DOES HEREBY CERTIFY THAT, NOTWITHSTANDING THE FACT THAT CERTAIN BUILDINGS IN THE CONDOMINIUM ARE NOT SUBSTANTIALLY COMPLETED, THE BUILDING(S) AND UNITS DESCRIBED "AS-BUILT" HEREIN ARE COMPLETED, AND THAT, AS TO SUCH UNITS AND IMPROVEMENTS, THE CONSTRUCTION OF THE IMPROVEMENTS DESCRIBED HEREIN, INCLUDING, BUT NOT LIMITED TO, LANDSCAPING, UTILITY SERVICES AND ACCESS TO SUCH COMPLETED UNITS, AND FACILITIES SERVING THE COMPLETED BUILDINGS IN WHICH SUCH COMPLETED UNITS ARE LOCATED, HAVE BEEN SUBSTANTIALLY COMPLETED SO THAT THIS EXHIBIT TO THE AMENDMENT TO DECLARATION OF CONDOMINIUM OF CENTURY PARK CONDOMINIUM No. 2 ADDING BUILDING 22, TOGETHER WITH THE PROVISIONS OF THE AFORESAID DECLARATION, CONSTITUTE A CORRECT REPRESENTATION OF SUCH COMPLETED IMPROVEMENTS DESCRIBED HEREIN AND, FURTHER, THAT THE IDENTIFICATION, LOCATION AND DIMENSIONS OF THE COMMON ELEMENTS, LIMITED COMMON ELEMENTS SERVING SUCH COMPLETED UNITS AND ALL OF SUCH COMPLETED UNITS MAY BE DETERMINED FROM SAID MATERIALS. I FURTHER CERTIFY THAT THIS SURVEY MEETS THE MINIMUM TECHNICAL STANDARDS SET FORTH BY THE FLORIDA BOARD OF LAND SURVEYORS PURSUANT TO CHAPTER 472 OF THE FLORIDA STATUTES.

DATED THIS 20 DAY OF MAY, 2002.

NOE AGUILAR  
PROFESSIONAL SURVEYOR & MAPPER  
CERTIFICATE No. 5571  
STATE OF FLORIDA

BY: Noe Aguilar**EXHIBIT B**

PAGE 30


**Century Park Condominium No. 2 - Building 22**

WEST FLAGLER STREET

NORTH CORNER PAGE 2  
CENTURY PARK (150'-0")  
(Point of Convergence)



Scale:  
1" = 200'

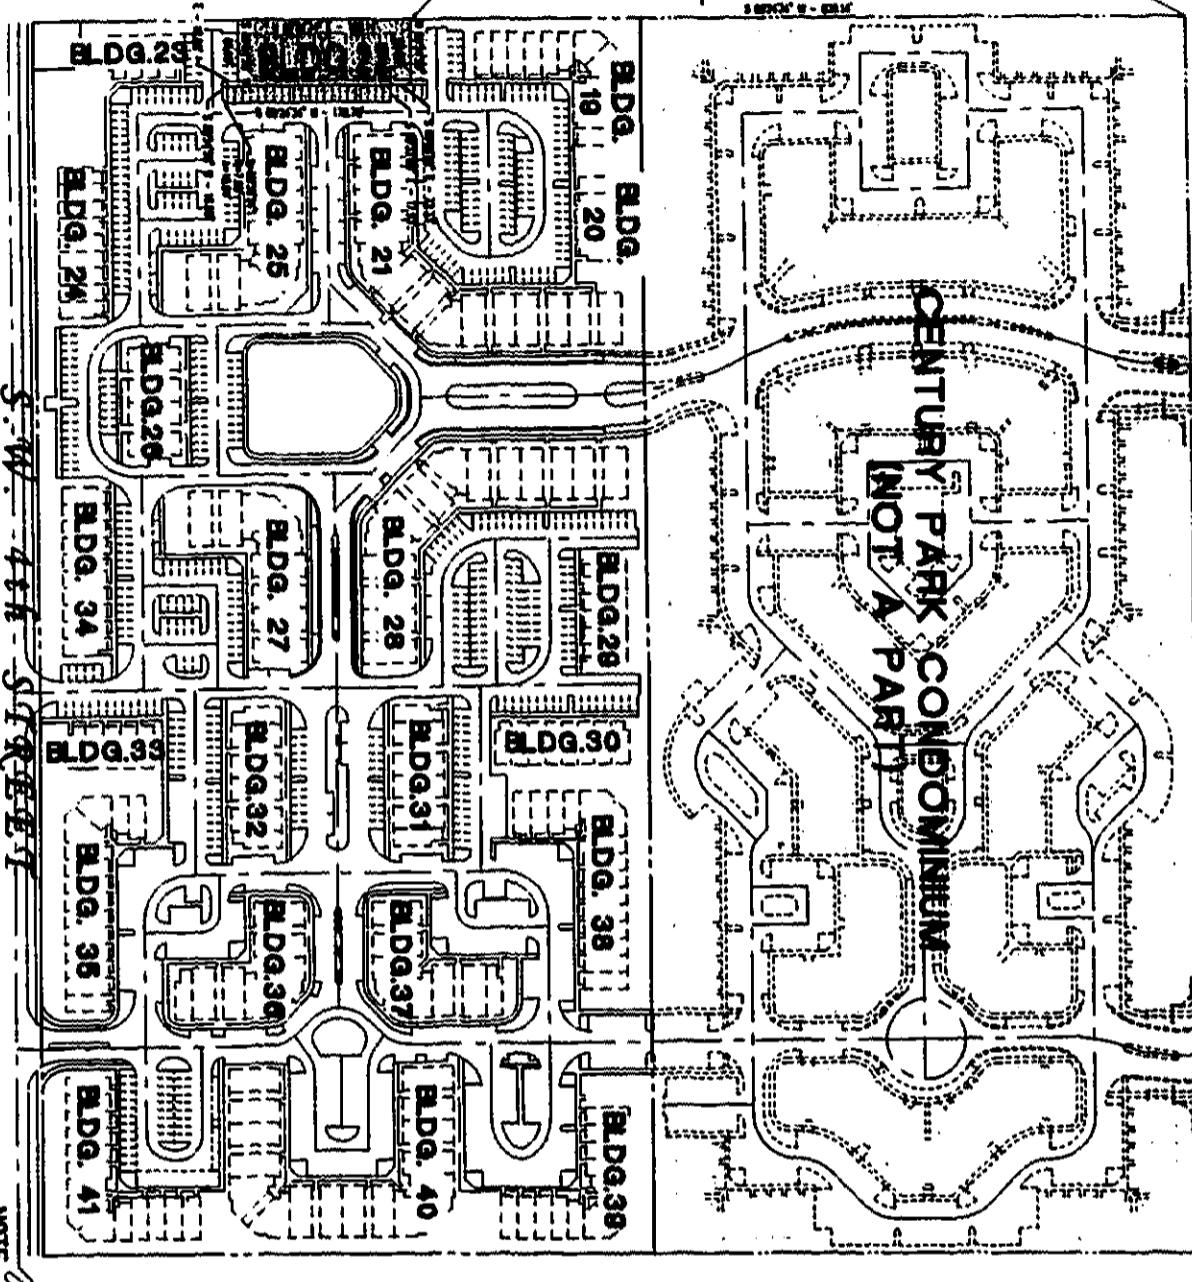

**S.W. 87th AVENUE  
(GALLOWAY ROAD)**

**LEGAL DESCRIPTION**

Page 157 of the Public Records of Miami-Dade County, Florida  
Shows the Northwest corner of Tract "B" of "CENTURY PARK".  
Commences at the Northwest corner of Tract "B" and runs North 15° 45' East along the west line of said Tract  
thence run South 26° 30' East, along the west line of said Tract, for a distance of 100.16 feet to the Point of Beginning of  
the Northerly described parcel; thence run North 09° 30' East  
for a distance of 98.88 feet to a point; thence run South 07° 22' East for a distance of 22.33 feet to a point; thence run South  
07° 22' East for a distance of 17.10 feet to a point; thence run  
South 07° 22' East for a distance of 108.70 feet to a point  
of curvature of a circular curve concave to the Northwest; thence  
run Southwest 01° 30' along the arc of said curve, bearing for 110  
feet; thence bearing 00° 00' East for a radius of 7.00 feet,  
for an arc distance of 10.00 feet to a point of tangency; thence  
run South 07° 22' East for a distance of 10.00 feet to a point  
thence run North 07° 22' East for a distance of 10.00 feet; thence  
run North 07° 22' East for a distance of 10.00  
feet to a point on the West line of the aforesaid tract; thence  
run North 07° 22' East, along the said line of the said  
tract "B" for a distance of 100.16 feet to the Point of Beginning.

**NOTE**

**COMMON ELEMENTS:**

Existing outside of the walls and paving spaces shall be  
considered as common elements.

**LIMITED COMMON ELEMENTS:**

All parking spaces shall be considered as limited common elements.

NOE AGUILAR  
PROFESSIONAL SURVEYOR & MAPPER No. 5571  
8210 S.W. 32nd STREET, MIAMI, FL 33155  
(305) 554-6456


**EXHIBIT "B" PAGE 31**  
**CENTURY PARK CONDOMINIUM No. 2**  
**A CONDOMINIUM**

BUILDING TWENTY-TWO LEGAL DESCRIPTION (AS-BUILT)



BUILDING 22 - FIRST FLOOR PLAN  
SCALE: 1" : 20'-0"

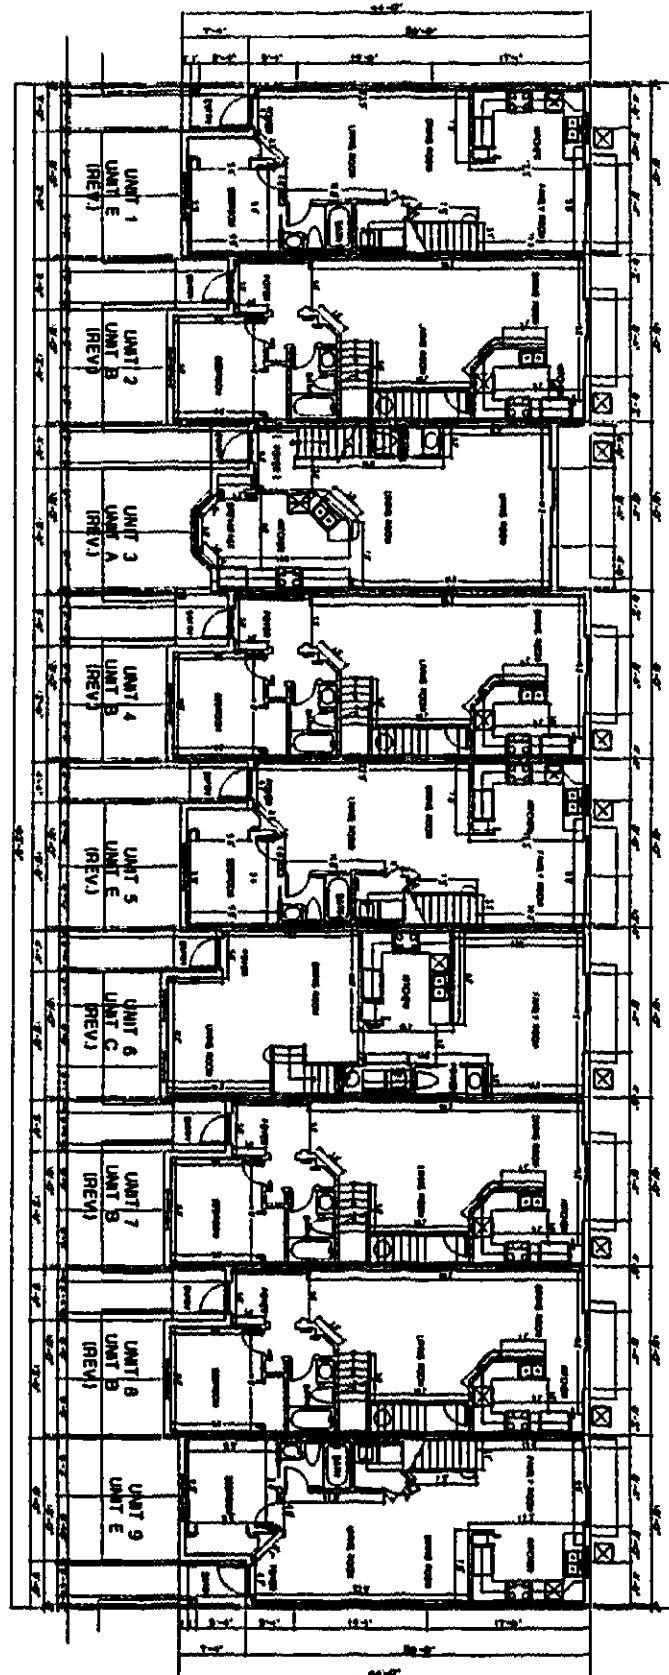

**NOE AGUILAR**  
PROFESSIONAL SURVEYOR & MAPPER No 55571  
6210 S W 32nd STREET, MIAMI, FL 33155  
13035 554-8256

**EXHIBIT "B" PAGE 32**


**CENTURY PARK CONDOMINIUM No. 2**

**BUILDING TWENTY-TWO (22)**  
**FIRST FLOOR PLAN - AS-BUILT**


**BLDG. 22 - SECOND FLOOR PLAN**

SCALE: 1' : 20'-0"

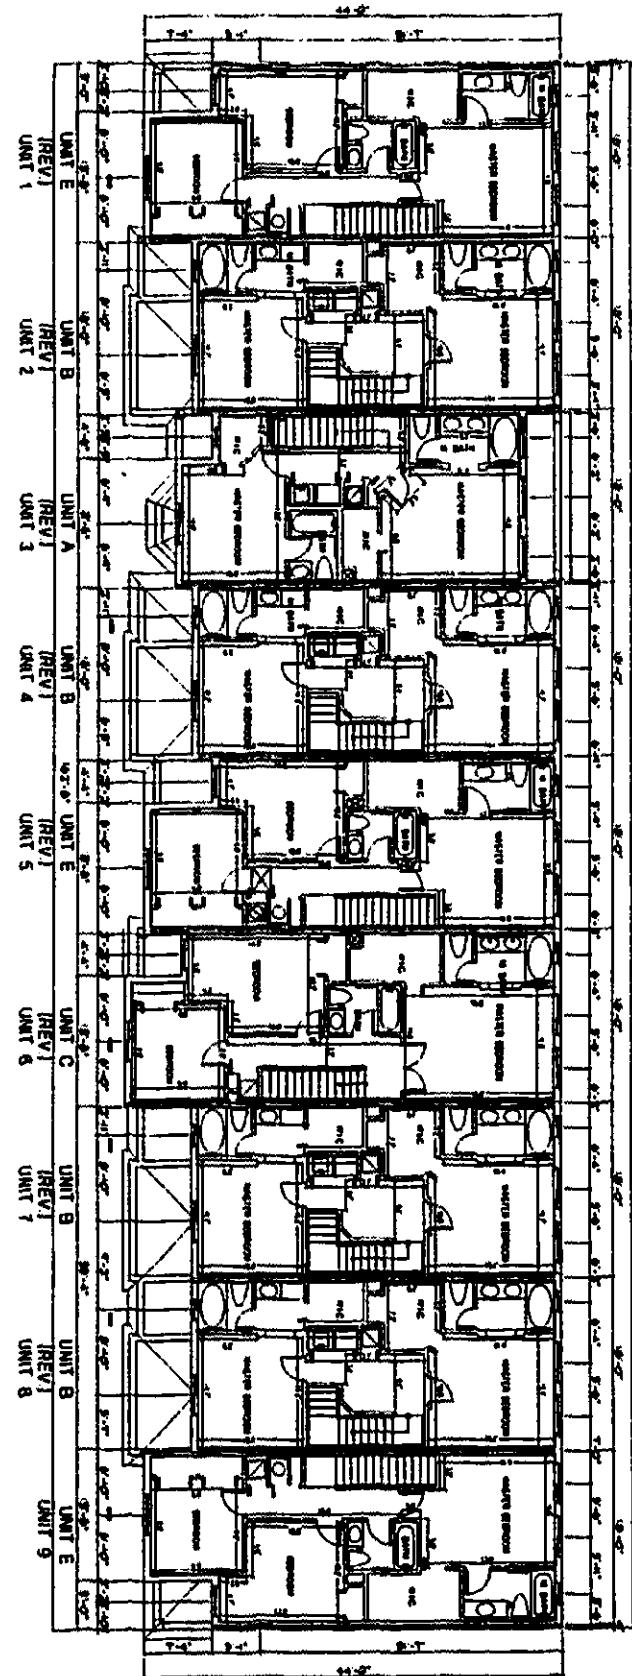

**NOE AGUILAR**  
PROFESSIONAL SURVEYOR & MAPPER No 5571  
6260 5th # 12th STREET, MIAMI, FL 33135  
(305) 554-8896

**EXHIBIT "B" PAGE 33**  
**CENTURY PARK CONDOMINIUM No. 2**  
A CONDOMINIUM  
BUILDING TWENTY-TWO (22)  
SECOND FLOOR PLAN (S-BM-1)


20512PG1158

CERTIFICATE OF SURVEYOR

THE UNDERSIGNED, A LICENSED AND REGISTERED LAND SURVEYOR, DULY AUTHORIZED TO PRACTICE UNDER THE LAWS OF THE STATE OF FLORIDA, DOES HEREBY CERTIFY THAT, NOTWITHSTANDING THE FACT THAT CERTAIN BUILDINGS IN THE CONDOMINIUM ARE NOT SUBSTANTIALLY COMPLETED, THE BUILDING(S) AND UNITS DESCRIBED "AS-BUILT" HEREIN ARE COMPLETED, AND THAT, AS TO SUCH UNITS AND IMPROVEMENTS, THE CONSTRUCTION OF THE IMPROVEMENTS DESCRIBED HEREIN, INCLUDING, BUT NOT LIMITED TO, LANDSCAPING, UTILITY SERVICES AND ACCESS TO SUCH COMPLETED UNITS, AND FACILITIES SERVING THE COMPLETED BUILDINGS IN WHICH SUCH COMPLETED UNITS ARE LOCATED, HAVE BEEN SUBSTANTIALLY COMPLETED SO THAT THIS EXHIBIT TO THE AMENDMENT TO DECLARATION OF CONDOMINIUM OF CENTURY PARK CONDOMINIUM No. 2 ADDING BUILDING 23, TOGETHER WITH THE PROVISIONS OF THE AFORESAID DECLARATION, CONSTITUTE A CORRECT REPRESENTATION OF SUCH COMPLETED IMPROVEMENTS DESCRIBED HEREIN AND, FURTHER, THAT THE IDENTIFICATION, LOCATION AND DIMENSIONS OF THE COMMON ELEMENTS, LIMITED COMMON ELEMENTS SERVING SUCH COMPLETED UNITS AND ALL OF SUCH COMPLETED UNITS MAY BE DETERMINED FROM SAID MATERIALS. I FURTHER CERTIFY THAT THIS SURVEY MEETS THE MINIMUM TECHNICAL STANDARDS SET FORTH BY THE FLORIDA BOARD OF LAND SURVEYORS PURSUANT TO CHAPTER 472 OF THE FLORIDA STATUTES.

DATED THIS 20 DAY OF May, 2002.

NOE AGUILAR  
PROFESSIONAL SURVEYOR & MAPPER  
CERTIFICATE No. 5571  
STATE OF FLORIDA

BY: Noe AguilarEXHIBIT "3"


PAGE 34

WEST CORNER TRACT "A"  
CENTURY PARK (1ST-19  
PORT OF CONDOMINIUM)


# Century Park Condominium No. 2 - Building 23

WEST FLAGLER STREET

UNIT 1/4 OWNED  
BY OWNER 4-3-4-4

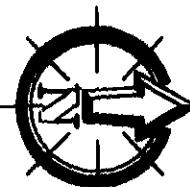

Scale:  
1" = 200'

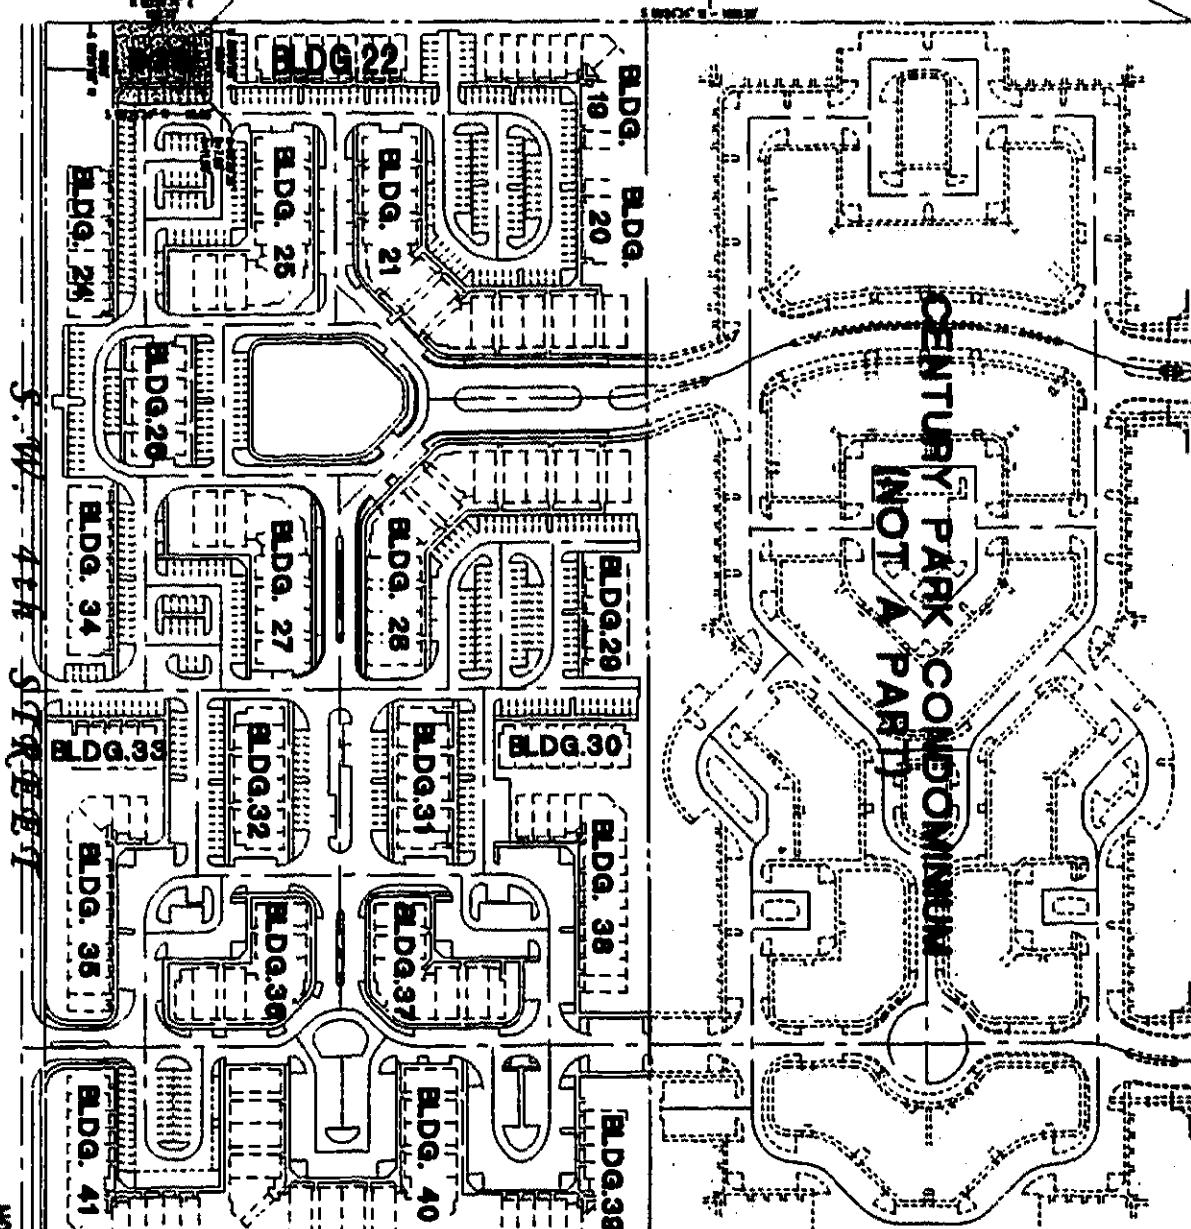

S.W. 87th AVENUE  
(GALLOWAY ROAD)

LEGAL DESCRIPTION

SECTION 137, TRACT 19, BLOCK 19, OF THE NEW LAND, EXCEPT OF TRACT 19, OF "CENTURY PARK" SUBDIVISION IN THE CITY OF MIAMI, IN SECTION 137 OF BLOCK 19 OF THE PUBLIC RECORDS OF MIAMI-DADE COUNTY, FLORIDA. SAME RUN SOUTH FOR 20' & THEN ALONG THE WEST LINE OF SAID TRACT 7' FOR A DISTANCE OF 100.28 FEET TO THE POINT OF BEGINNING OF THE HEREIN DESCRIBED TRACT; THENCE RUN NORTH 45° 45' EAST FOR A DISTANCE OF 100.49 FEET TO A POINT ON EXTENSION OF A CIRCULAR CURVE CENTERED IN THE SOUTHWEST CORNER RUN NORTHERLY ALONG THE ARC OF SAID CURVE BEARING FOR 115.00 FEET, FOR AN ARC DISTANCE OF 11.00 FEET TO A POINT; THENCE RUN SOUTH 49° 26' EAST FOR A DISTANCE OF 50.00 FEET TO A POINT; THENCE RUN SOUTH 49° 26' EAST FOR A DISTANCE OF 100.72 FEET ALONG THE WEST LINE OF THE SAID TRACT; THENCE RUN NORTH 49° 26' EAST ALONG THE ARC OF SAID CURVE BEARING FOR A DISTANCE OF 100.72 FEET TO THE POINT OF BEGINNING.

NOTE

COMMON ELEMENTS:

Exhibiting certain of the walls and parking spaces shall be considered as common elements.


LIMITED COMMON ELEMENTS:

NOE AGUILAR			
PROFESSIONAL SURVEYOR & MAPPER No. 5571			
8210 SW 32nd STREET, MIAMI, FL 33155			
(305) 595-8456			
EXHIBIT "B" PAGE 35			
CENTURY PARK CONDOMINIUM No. 2			
A CONDOMINIUM			
BUILDING TWENTY-THREE LEGAL DESCRIPTION (AS-BUL 1)			



FIRST FLOOR PLAN  
SCALE: 1 : 20'-0"

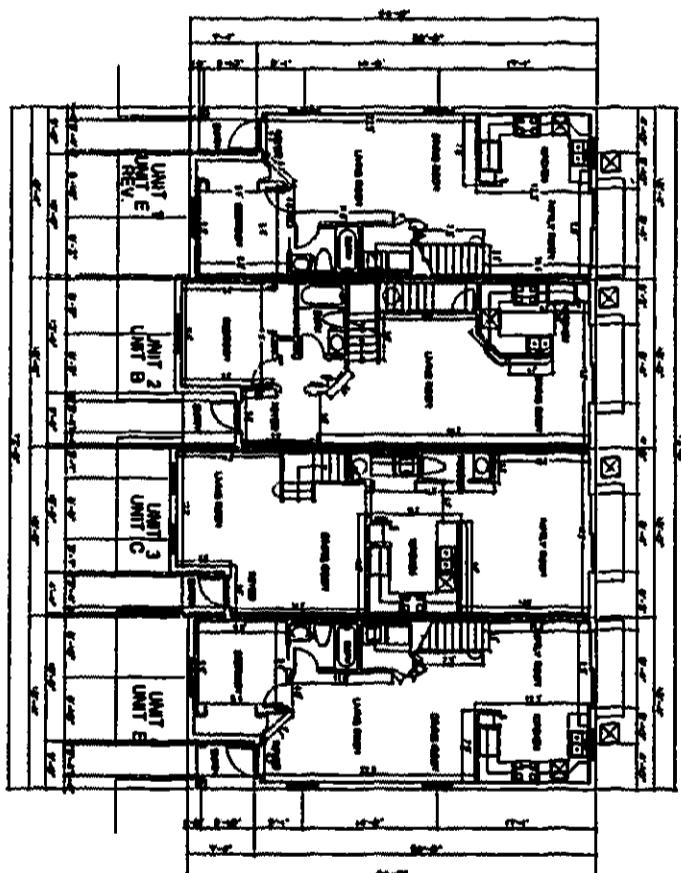

NOE AGUILAR  
PROFESSIONAL SURVEYOR & MAPPER No. 5571  
8210 SW 32nd STREET, MIAMI, FL 33155  
(305) 554-8456


EXHIBIT "B" PAGE 36  
CENTURY PARK CONDOMINIUM No. 2  
A CONDOMINIUM  
BUILDING HEIGHT - THREE (33)  
FIRST FLOOR PLAN - AS-BUILT

REF.	DATE	MM	PLATE	FILE	INDEX
55	05/22/02	EL-20	111		

PRINTED 05/22/02 01:33:19

20512PG1161

SECOND FLOOR PLAN  
SCALE: 1 : 20'-0"

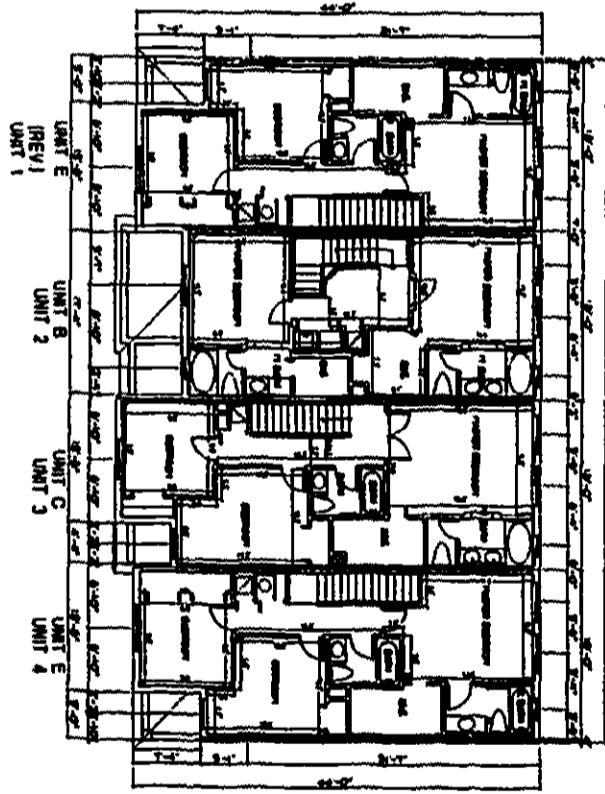

NOE AGUILAR			
PROFESSIONAL SURVEYOR & MAPPER No. 5571			
820 SW 12th STREET, MIAMI, FL 33183			
(305) 554-6456			
EXHIBIT "D" PAGE 37			
CENTURY PARK CONDOMINIUM No. 2			
A COMMUNICANT			
BUILDING TWENTY-THREE (23)			
SECOND FLOOR PLAN AS-BUILT			
DATE	05/22/02	SCALE	1" = 20'-0"
FILE NO.	EL-201	FILE	4-1249
RECEIVED	05/22/02	RECORDED	05/22/02 10 AM
SERIALIZED		INDEXED	4-1249

20512PG1162

**CERTIFICATE OF SURVEYOR**

THE UNDERSIGNED, A LICENSED AND REGISTERED LAND SURVEYOR, DULY AUTHORIZED TO PRACTICE UNDER THE LAWS OF THE STATE OF FLORIDA, DOES HEREBY CERTIFY THAT, NOTWITHSTANDING THE FACT THAT CERTAIN BUILDINGS IN THE CONDOMINIUM ARE NOT SUBSTANTIALLY COMPLETED, THE BUILDING(S) AND UNITS DESCRIBED "AS-BUILT" HEREIN ARE COMPLETED, AND THAT, AS TO SUCH UNITS AND IMPROVEMENTS, THE CONSTRUCTION OF THE IMPROVEMENTS DESCRIBED HEREIN, INCLUDING, BUT NOT LIMITED TO, LANDSCAPING, UTILITY SERVICES AND ACCESS TO SUCH COMPLETED UNITS, AND FACILITIES SERVING THE COMPLETED BUILDINGS IN WHICH SUCH COMPLETED UNITS ARE LOCATED, HAVE BEEN SUBSTANTIALLY COMPLETED SO THAT THIS EXHIBIT TO THE AMENDMENT TO DECLARATION OF CONDOMINIUM OF CENTURY PARK CONDOMINIUM No. 2 ADDING BUILDING 24, TOGETHER WITH THE PROVISIONS OF THE AFORESAID DECLARATION, CONSTITUTE A CORRECT REPRESENTATION OF SUCH COMPLETED IMPROVEMENTS DESCRIBED HEREIN AND, FURTHER, THAT THE IDENTIFICATION, LOCATION AND DIMENSIONS OF THE COMMON ELEMENTS, LIMITED COMMON ELEMENTS SERVING SUCH COMPLETED UNITS AND ALL OF SUCH COMPLETED UNITS MAY BE DETERMINED FROM SAID MATERIALS. I FURTHER CERTIFY THAT THIS SURVEY MEETS THE MINIMUM TECHNICAL STANDARDS SET FORTH BY THE FLORIDA BOARD OF LAND SURVEYORS PURSUANT TO CHAPTER 472 OF THE FLORIDA STATUTES.

DATED THIS 14 DAY OF JUNE, 2002.

NOE AGUILAR  
PROFESSIONAL SURVEYOR & MAPPER  
CERTIFICATE No. 5571  
STATE OF FLORIDA

BY: Noe Aguilar**EXHIBIT "B"**


# Century Park Condominium No. 2 - Building 24

WEST FLAGLER STREET




SECTION LINE  
SOUTH FENCE LINE (SPL-1)  
(Point of Convergence)


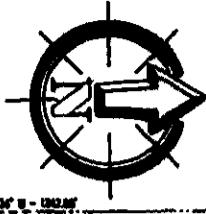

Scale:  
1" = 200'

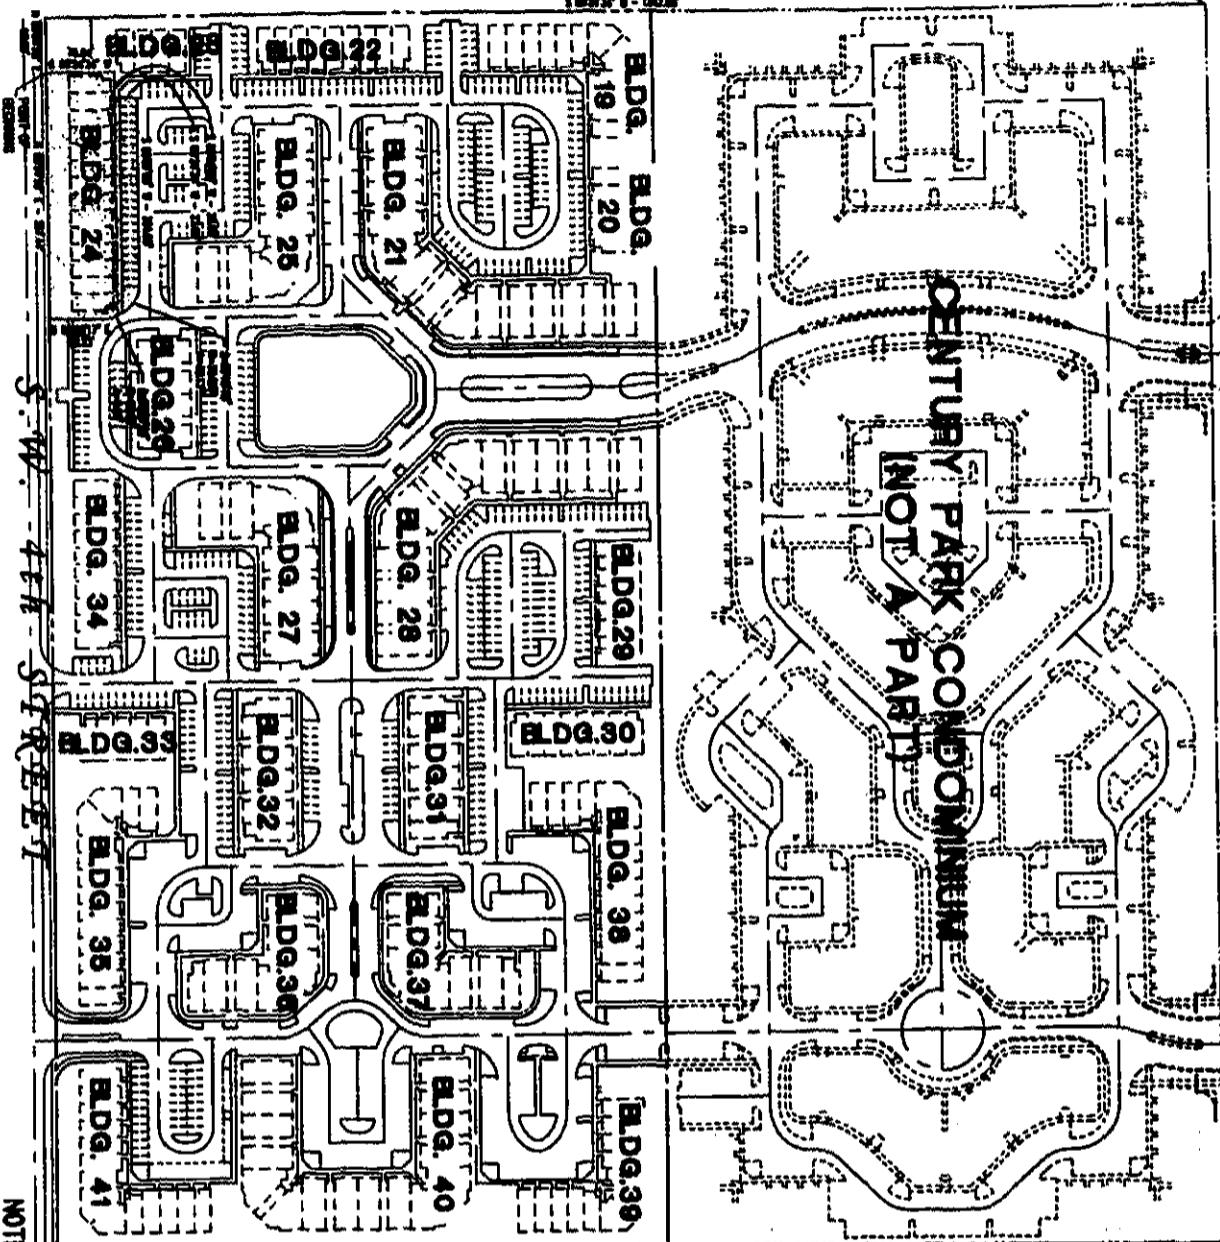

### NOTE

**CONSTRUCTION ELEMENTS:**

Existing outside of walls and paving stones shall be

LIMITED CONSTRUCTION ELEMENTS:

No construction shall be allowed on limited construction elements.


LEGAL DESCRIPTION  


20512PG1164

FIRST FLOOR PLAN




SCALE: 1' - 20'-0"

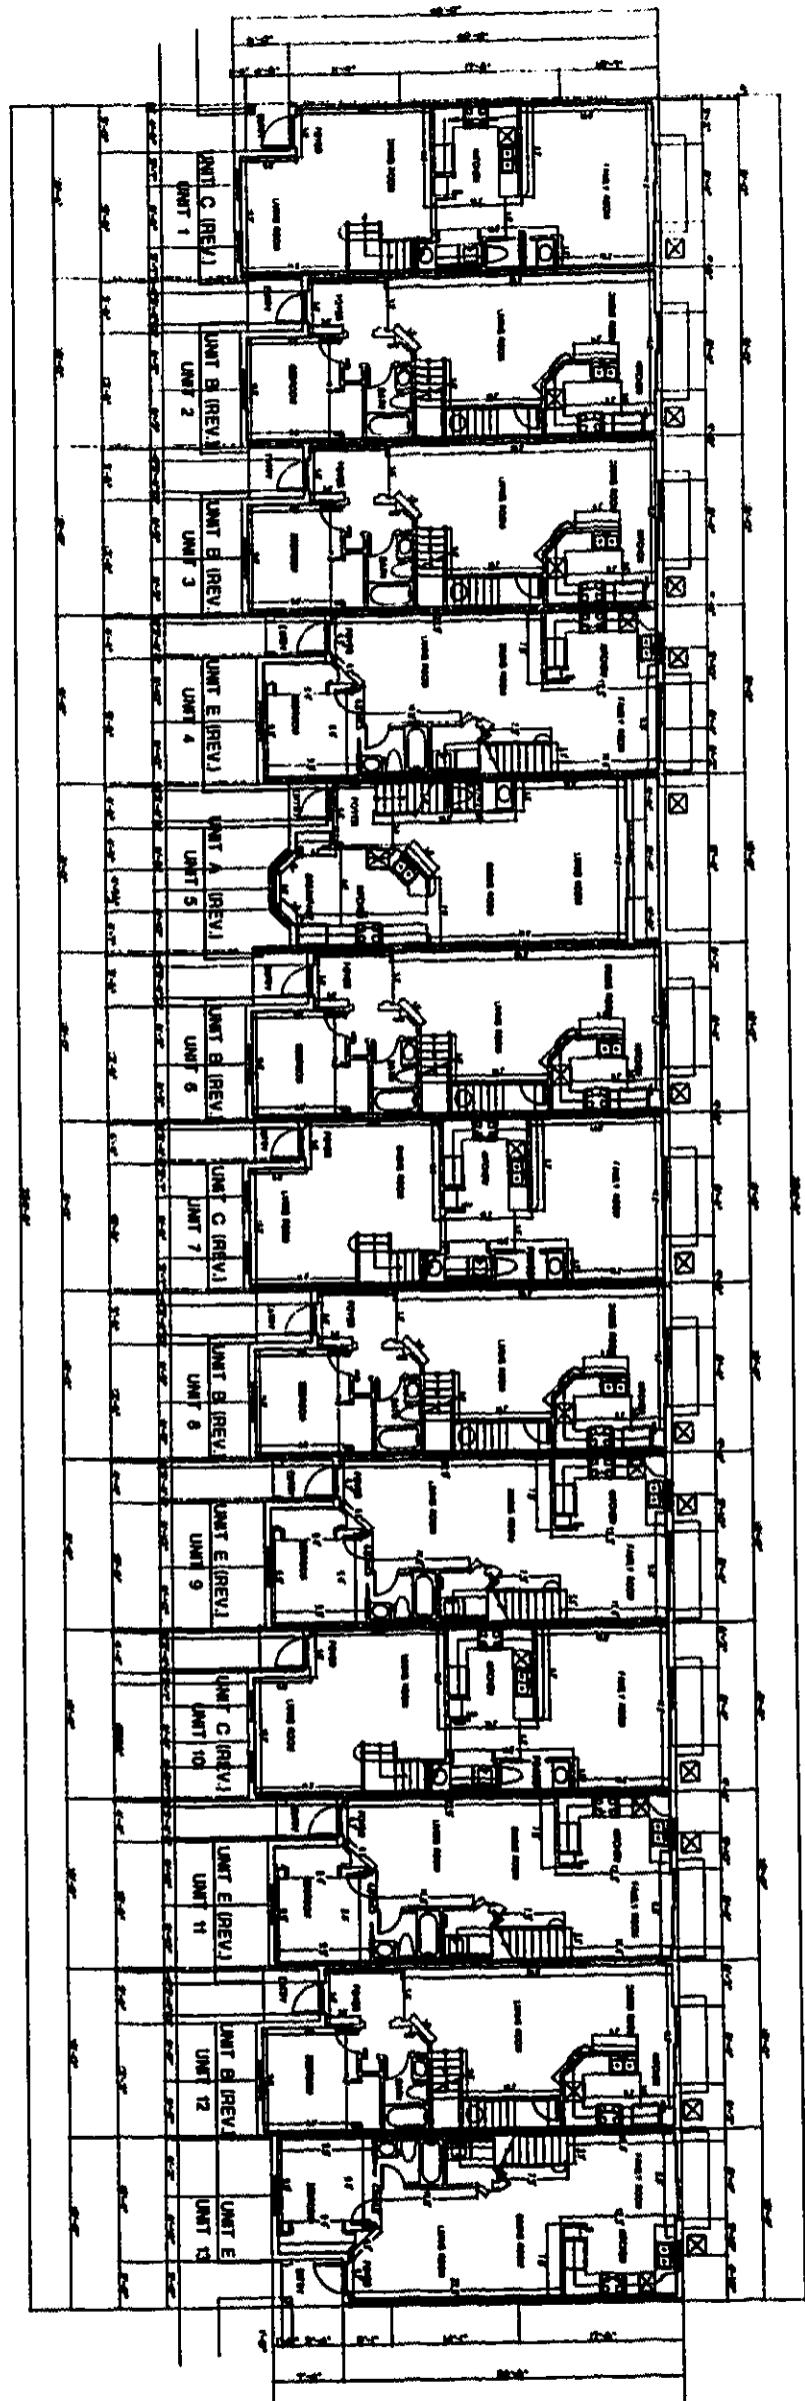

NOE AGUILAR	
PROFESSIONAL SURVEYOR & MAPPER NO. 5571	
9210 S W 32nd STREET, MIAMI, FL 33195	
(305) 554-8456	
<b>EXHIBIT "B" PAGE 4D</b>	
<b>CENTURY PARK CONDOMINIUM No. 2</b>	
A CONDOMINIUM	
BUILDING TWENTY-FOUR (24)	
FIRST FLOOR PLAN - AS-BUILT	
PRINT DATE MM DD YYYY	06/01/02
FILE NO.	EL-201
FILE	0000
SCALE INCHES/FT-00'	1/100
MAP SHEET NO.	3612/02 & 00-00
REVIS.	0000
DESCRIPTION	REVISION
DATE	07/01/02

20512PG1165

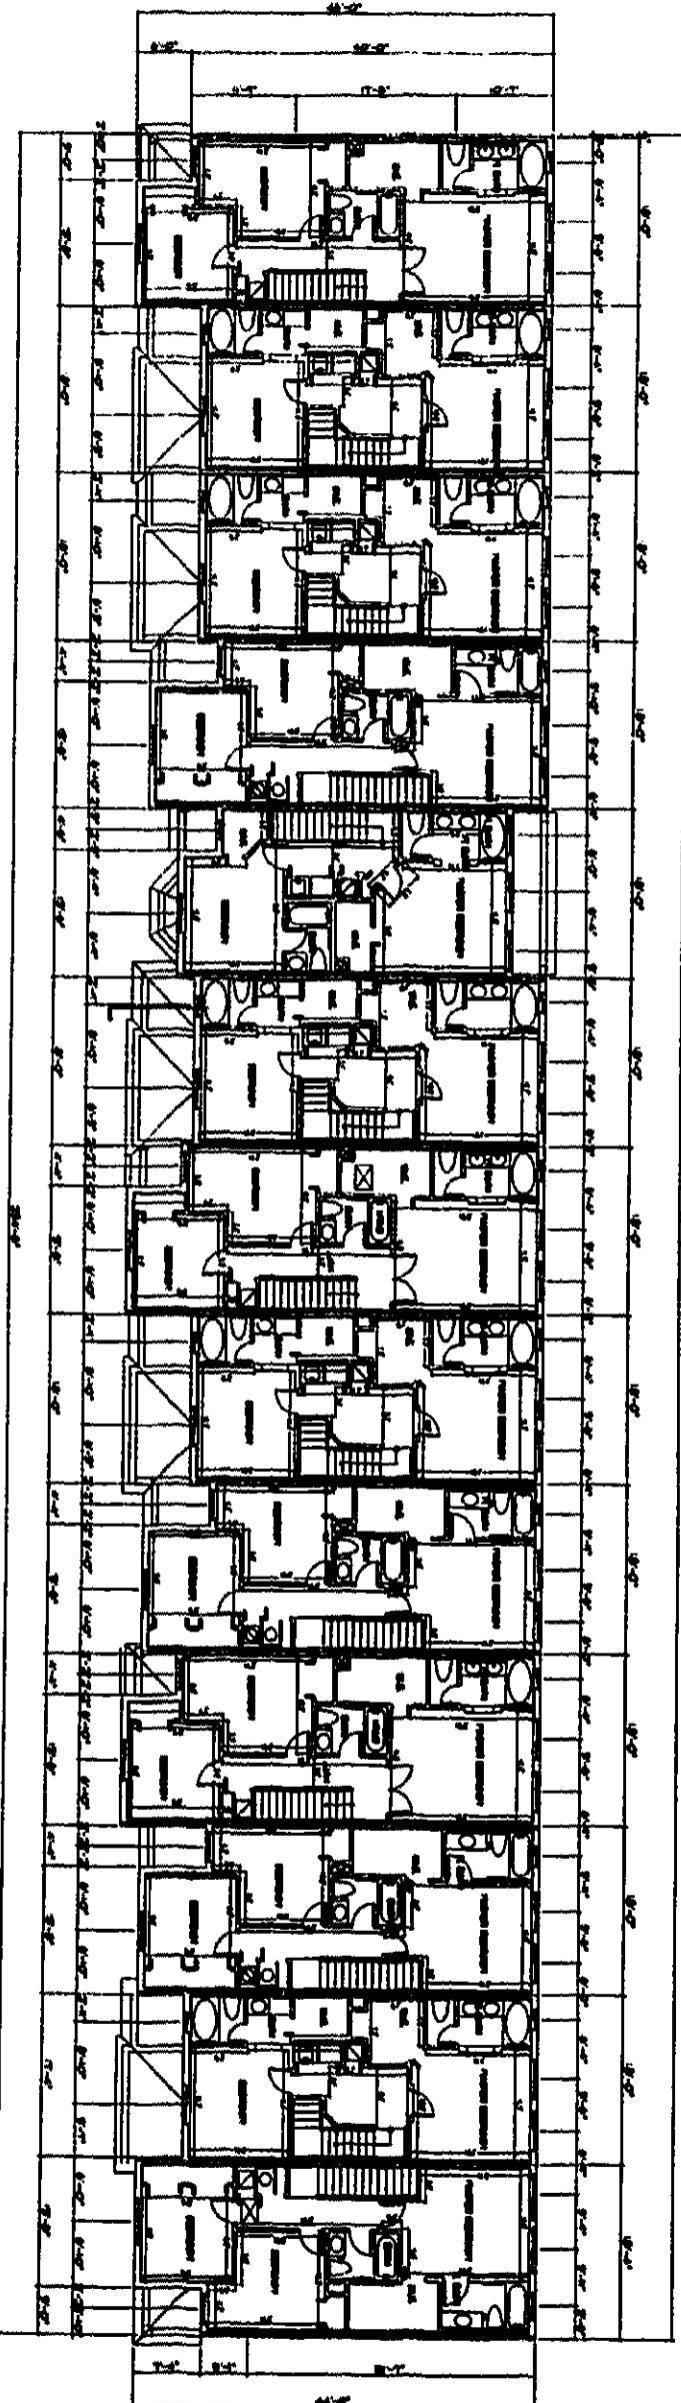

UNIT C (REV.)    UNIT B (REV.)    UNIT B (REV.)    UNIT E (REV.)    UNIT A (REV.)    UNIT B (REV.)    UNIT C (REV.)    UNIT B (REV.)    UNIT E (REV.)    UNIT C (REV.)    UNIT B (REV.)    UNIT E (REV.)  
UNIT 1            UNIT 2            UNIT 3            UNIT 4            UNIT 5            UNIT 6            UNIT 7            UNIT 8            UNIT 9            UNIT 10            UNIT 11            UNIT 12            UNIT 13

SECOND FLOOR PLAN

SCALE: 1'-0" = 20'-0"

NOE AGUILAR PROFESSIONAL SURVEYOR & MAPPER NO. 5571 820 SW 32nd STREET, MIAMI, FL 33155 (305) 554-8456											
EXHIBIT "B" PAGE 41											
CENTURY PARK CONDOMINIUM No. 2											
A CONDOMINIUM											
BUILDING TWENTY-FOUR (24)											
SECOND FLOOR PLAN AS-BUILT											

REC BK.  
OFF. REC BK.

20512PG1166

EXHIBIT "C"  
ARTICLES of INCORPORATION

## AMENDED AND RESTATED ARTICLES OF INCORPORATION

OF

CENTURY PARK CONDOMINIUM No.2 ASSOCIATION, INC.

SECRET  
 TALLAHASSEE, FLA.  
 JUNE 20, 1982  
 ORIGINALLY FILED  
 INDEXED  
 SERIALIZED  
 FILED  
 CLERK'S OFFICE  
 TALLAHASSEE, FLA.

The undersigned, by these amended and restated Articles, pursuant to Chapter 617, Florida Statutes, certify as follows:

ARTICLE I - NAME

The name of the corporation is **CENTURY PARK CONDOMINIUM No.2 ASSOCIATION, INC.** For convenience, the Corporation shall be referred to in this instrument as "the Association."

ARTICLE II - PURPOSES AND POWERS

The Association does not contemplate pecuniary gain or profit to the members thereof. The specific purposes for which it is formed are to provide for maintenance, preservation and architectural control of the condominium units and common elements within that certain Condominium more particularly described in the Declaration of Condominium for CENTURY PARK CONDOMINIUM No.2 (hereafter, "the Declaration of Condominium"), and to promote the health, safety and welfare of the residents within the Condominium and any additions. In order to effectuate these purposes, the Association shall have the power to exercise all of the powers and privileges and to perform all of the duties and obligations of the Association as set forth in the Declaration of Condominium, which powers and privileges include but are not limited to the following:

1. To fix, levy, collect and enforce payment by any lawful means all appropriate charges or assessments;
2. To pay all expenses incident to the conduct of the business of the Association, including all licenses, taxes and governmental charges levied or imposed against the Common Elements;
3. To acquire (by gift, purchase or otherwise), own, hold, improve, build upon, operate, maintain, convey, sell, lease, transfer, dedicate for public use or otherwise dispose of the Common Elements on behalf of the membership of the Association;
4. To borrow money and mortgage, pledge or hypothecate any or all of the Common Elements as security for money borrowed or debts incurred;
5. To participate in mergers and consolidations with other nonprofit corporations organized for the same purposes; and
6. To have and to exercise any and all powers, rights and privileges which a corporation organized under the Florida Not-for-Profit Corporation Law may now or hereafter have or exercise.

ARTICLE III - MEMBERSHIP AND VOTINGA. Membership: Every person or entity who is a recordPrepared by:

ARMANDO J. BUCEO, ESQ.  
 FL. Bar #0008268  
 1401 PONCE DE LEON BLVD., Suite 401  
 CORAL GABLES FL. 33134

owner of any Unit in the Condominium shall be a member of the Association. The foregoing does not include persons or entities who hold an interest merely as security for the performance of an obligation. Change of membership in the Association shall be established by recording in the Public Records of Florida, a deed or other instrument establishing a record title to any Unit in a transferee and the delivery to the Association of a certified copy of such instrument. Upon such delivery, the transferee designated by such instrument shall become a member of the Association and the membership of the transferee shall be terminated.

B. **Appurtenance to Unit:** The share of a member in the funds and assets of the Association shall not be assigned, hypothecated or transferred in any manner except as an appurtenance to his Unit.

C. **Voting Rights:** Each Owner shall be entitled to one vote for each Unit owned. When more than one person holds an interest or interests in any Unit, the vote for such Unit shall be limited to one vote as the Owners among themselves determine. The manner of exercising voting rights shall be determined by the By-Laws of the Association.

D. **Meetings:** The By-Laws shall provide for meetings of the members.

#### **ARTICLE IV - BOARD OF ADMINISTRATORS**

A. **Membership of Board:** The affairs of this Association shall be managed by a Board consisting of the number of Administrators determined by the By-Laws, but not fewer than three (3) Administrators.

B. **Election and Removal:** Administrators shall be elected at the annual meeting of the members in the manner determined by the By-Laws. Administrators may be removed and vacancies on the Board shall be filled in the manner provided by the By-Laws.

C. **First Board of Administrators:** The names and addresses of the persons who shall act in the capacity of Administrators until their successors shall be elected and qualified are as follows:

Name	Address
Mark Janz	7270 NW 12 <sup>th</sup> Street, Suite 410 Miami Fl. 33126
Keyla Alba-Reilly	Same as above
Cesar Llano	Same as above

The Administrators named above shall serve until the first election of Administrators, as determined by the By-Laws and any vacancies in their number occurring before the first election of Administrators shall be filled by act of the remaining Administrators.

#### **ARTICLE V - OFFICERS**

The affairs of the Association shall be administered by the Officers designated in the By-Laws. After the first election of Administrators, the Officers shall be elected by the Board at the first Board meeting following the annual meeting. Administrators shall serve at the pleasure of the Board. The names and addresses of the officers who shall serve until their successors are designated by the Board are as follows:

Mark Janz	President
Keyla Alba-Reilly	Vice-President, Secretary
Cesar Llano	Vice-President, Treasurer

ARTICLE VI - INDEMNIFICATION

Every Administrator and every Officer of the Association shall be indemnified by the Association against all expenses and liabilities, including counsel fees, reasonably incurred by or imposed upon him in connection with any proceeding or any settlement of any proceeding to which he may be a party or in which he may become involved by reason of his being or having been an Administrator or Officer of the Association, whether or not he is an Administrator or Officer of the Association at the time such expenses are incurred, except when the Administrator or Officer is adjudged guilty of willful misfeasance or malfeasance in the performance of his duties; provided that in the event of a settlement, the indemnification shall apply only when the Board approves such settlement and reimbursement as being in the best interests of the Association. The foregoing right of indemnification shall be in addition to and not exclusive of all other rights to which such Administrator or Officer may be entitled.

ARTICLE VII - BY-LAWS

The first By-Laws of the Association shall be adopted by the Board and may be thereafter be altered, amended or rescinded in the manner provided in such By-Laws.

ARTICLE VIII - AMENDMENTS

Amendments to the Articles of Incorporation may be considered at any regular or special meeting of the members and may be adopted in the following manner:

1. By notice of the subject matter of a proposed amendment and of the meeting at which a proposed amendment is considered, which notice shall be made as required by the By-Laws.
2. By resolution for the adoption of a proposed amendment which may be proposed either by the Board or by a majority of the voting members. Administrators and members not present in person or by proxy at the meeting considering the amendment may express their approval in writing, provided that such approval is delivered to the Secretary at or prior to the meeting. Such amendments must be approved by not less than sixty-seven (67%) percent of the votes of the voting members.

ARTICLE IX - TERM

The term of the Association shall be perpetual.

ARTICLE X - DISSOLUTION

The Association may be dissolved with the assent given in writing and signed by not less than seventy-five percent (75%) of the voting members. Upon dissolution of the Association, other than incident to a merger or consolidation, the assets of the Association shall be dedicated to an appropriate public agency to be used for purposes similar to those for which the Association was created. In the event that such dedication shall be refused acceptance, such assets shall be granted, conveyed and assigned to any non-profit corporation, association, trust or other organization to be devoted to such similar purposes.

ARTICLE XI - INTENTIONALLY OMITTED

20512 PG 1170

**ARTICLE XII - RESIDENT AGENT**

The name and street address of the Resident Agent of the Corporation is:

**KEYLA ALBA-REILLY**  
 Suite 410  
 7270 NW 12<sup>th</sup> Street  
 Miami FL 33126

**ARTICLE XIII - MISCELLANEOUS**

A. **Developer's Rights.** No amendment of these Articles of Incorporation or the By-Laws shall change Developer's rights and privileges as set forth in the Declaration of Condominium without Developer's prior written approval so long as Developer owns any Unit.

B. **Stock.** The Association shall issue no shares of stock of any kind or nature whatsoever.

C. **Severability.** Invalidation of any one or more of the provisions hereof shall in no way affect any other provisions, which shall remain in full force and effect.

D. **Registered Office.** The initial registered office of the Association is:

**KEYLA ALBA-REILLY**  
 Suite 410  
 7270 NW 12<sup>th</sup> Street  
 Miami FL 33126

IN WITNESS WHEREOF, the undersigned subscriber has executed this instrument this 1<sup>st</sup> day of July, 2002.

Signed, Sealed and Delivered  
 In the presence of:

Barbra A. Roaeta  
 Barbra A. Roaeta  
 CR

MARK MANZ PRESIDENT

Barbra A. Roaeta  
 Barbra A. Roaeta  
 CRISTINA RIO  
 CRISTINA RIO

CESAR LLANO V.PRES./Treasurer

Barbra A. Roaeta  
 Barbra A. Roaeta  
 CRISTINA RIO  
 CRISTINA RIO


KEYLA ALBA-REILLY VICE PRES./SEC.

20512 PG 1171

STATE OF FLORIDA  
COUNTY OF DADE

The foregoing instrument was acknowledged before me this 1st day of July, 2002 by MARK JANZ who is personally known to me and who did take an oath.

*Mercedes Galvez*  
NOTARY PUBLIC / MERCEDES GALVEZ  
State of Florida at Large  
My Commission Expires:

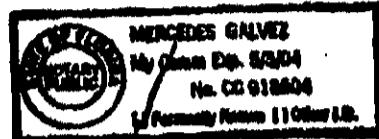STATE OF FLORIDA  
COUNTY OF DADE

*July* The foregoing instrument was acknowledged before me this 1st day of July, 2002 by CESAR LLANO who is personally known to me and who did take an oath.

*Mercedes Galvez*  
NOTARY PUBLIC / MERCEDES GALVEZ  
State of Florida at Large  
My Commission Expires:

STATE OF FLORIDA  
COUNTY OF DADE

*July* The foregoing instrument was acknowledged before me this 1st day of July, 2002 by KEYLA ALBA-REILLY who is personally known to me and who did take an oath.

*Mercedes Galvez*  
NOTARY PUBLIC / MERCEDES GALVEZ  
State of Florida at Large  
My Commission Expires:

H:\LIBRARY\CA\ED3\40741202013\W1\REC.WPD

OFF. REC BK.

20512PG1172

EXHIBIT "D"  
BY-LAWS

20512 PG 1173

**BY-LAWS OF CENTURY PARK  
CONDOMINIUM No.2 ASSOCIATION, INC.**

A corporation not for profit organized  
under the laws of the State of Florida

1. **Identity.** These are the By-Laws of CENTURY PARK CONDOMINIUM No.2 ASSOCIATION, INC. (the "Association"), a corporation not for profit incorporated under the laws of the State of Florida, and organized for the purposes set forth in its Articles of Incorporation, as amended by its Amended and Restated Articles of Incorporation.
  - 1.1 The principal office of the Association shall be 7270 N.W. 12<sup>TH</sup> Street, Suite 410, Miami, Florida 33126, or such other place as may be subsequently designated by the Board of Directors.
  - 1.2 The seal of the Association shall bear the name of the corporation, the word "Florida", the words "Corporation Not for Profit", and the year of incorporation.
2. **Definitions.** For convenience, these By-Laws shall be referred to as the "By-Laws" and the Articles of Incorporation of the Association, as amended by the Amended and Restated Articles of Incorporation of the Association, as the ("Articles"). The other terms used in these By-Laws shall have the same definitions and meanings as those set forth in the Declaration for Century Park Condominium No.2, a Condominium, unless herein provided to the contrary, or unless the context otherwise requires.
3. **Meetings**
  - 3.1 **Annual Meeting.** The annual members' meeting shall be held on July 1<sup>st</sup> of each year or such other date determined by the Board of Directors, at the place and at the time determined by the Board of Directors from time to time, provided that there shall be an annual meeting every calendar year and, to the extent possible, no later than twelve (12) months after the last preceding annual meeting. The purpose of the meeting shall be, except as provided herein to the contrary, to elect Directors, and to transact any other business authorized to be transacted by the members, or as stated in the notice of the meeting sent to Unit Owners in advance thereof. Unless changed by the Board of Directors, the first annual meeting shall be held in the month of July following the year in which the Declaration is filed.
  - 3.2 **Special Meetings.** Special members' meetings shall be held at such place as provided herein for annual meetings, and may be called by the President or by a majority of the Board of Directors of the Association, and must be called by the President or Secretary upon receipt of a written request from a majority of the members of the Association. The business conducted at a special meeting shall be limited to that stated in the notice of the meeting. Special meetings may also be called by Unit Owners in the manner provided for in the Condominium Act.
  - 3.3 **Participation by Unit Owners.** Subject to reasonable restrictions as may be adopted from time to time by the Board of Directors, Unit Owners shall have the

right to speak at the annual and special meetings of the Unit Owners, committee meetings and Board meetings with reference to all designated agenda items.

- 3.4 **Notice of Meeting; Waiver of Notice.** Notice of a meeting of members (annual or special), stating the time and place and the purpose(s) for which the meeting is called, shall be given by the President or Secretary. A copy of the notice shall be posed at a conspicuous place on the condominium Property. Notices of the meetings of members shall be hand delivered or sent by regular mail to each Unit Owner, unless the Unit Owner waives in writing the right to receive notice of such meeting. The delivery or mailing shall be to the address of the member as it appears on the roster of members. The posting and mailing of the notice for either special or annual meetings, which notice shall include an agenda, shall be mailed or delivered not less than fourteen (14) days, nor more than sixty (60) days, prior to the date of the meeting. Further, the notice for the annual meeting shall be posted in a conspicuous place for fourteen (14) continuous days preceding the meeting.

Notice of specific meetings may be waived before or after the meeting and the attendance of any member (or person authorized to vote for such member), either in person or by proxy, shall constitute such member's waiver of notice of such meeting, and waiver of any and all objections to the place of the meeting, the time of the meeting or the manner in which it has been called or convened, except when his (or his authorized representative's) attendance is for the express purpose of objecting at the beginning of the meeting to the transaction of business because the meeting is not lawfully called.

An officer of the Association, or the manager or other person providing notice of the meeting shall provide an affidavit or United States Postal Service certificate of mailing, to be included in the official records of the Association, affirming that notices of meetings were posted and mailed or hand delivered in accordance with this Section and the Condominium Act, to each Unit Owner at the appropriate address for such Unit Owner. No other proof of notice of a meeting shall be required.

- 3.5 **Quorum.** A quorum at members' meetings shall be attained by the presence, either in person or by proxy (limited or general), of persons entitled to cast thirty percent (30%) of the votes of members.

3.6 **Voting.**

- (a) **Number of Votes.** The Owners of Units shall be entitled to cast one vote for each Unit owned. The vote of a Unit shall not be divisible.
- (b) **Majority Vote.** The acts approved by a majority of the votes present in person or by proxy at a meeting at which a quorum has been attained shall be binding upon all Unit Owners for all purposes, except where otherwise provided by law, the Declaration, the Articles or these By-Laws.

(c) **Voting Member.** If a Unit is owned by one person, that person's right to vote shall be established by the roster of members. If a Unit is owned by more than one person, those persons (including husbands and wives) shall decide among themselves as to who shall cast the vote of the Unit. In the event that those persons cannot so decide, no vote shall be cast. A person casting a vote for a Unit shall be presumed to have the authority to do so unless the President or the Board of Directors is otherwise notified. If a Unit is owned by a corporation, partnership, trust or other entity, the person entitled to cast the vote for the Unit shall be designated by a certificate signed by an appropriate officer for a corporation, by the general partner for a partnership or by a trustee for a trust and filed with the Secretary of the Association. Such person need not be a Unit Owner. Those certificates shall be valid until revoked or until superseded by a subsequent certificate or until a change in the ownership of the Unit concerned. A certificate designating the person entitled to cast the vote for a Unit may be revoked by any record owner of an undivided interest in the Unit. If a certificate designating the person entitled to cast the vote for a Unit for which such certificate is required is not on file or has been revoked, the vote attributable to such Unit shall not be considered in determining whether a quorum is present nor for any other purpose, and the total number of authorized votes in the Association shall be reduced accordingly until such certificate is filed.

3.7 **Proxies.** Votes to be cast at meetings of the Association membership may be cast in person or by proxy. Except as may be permitted by the Condominium Act, Unit Owners may not vote by general proxy, but may vote by limited proxies substantially conforming to the limited proxy form approved by the Division. Limited proxies shall be permitted for votes taken to: waive or reduce reserves; waive financial statements; amend the Declaration, Articles or ByLaws; or for any other matter requiring or permitting a vote of Unit Owners. No proxy, limited or general, may be used in the election of Board members, unless permitted by the Condominium Act. General proxies may be used for other matters for which limited proxies are not required and may also be used in voting for nonsubstantive changes to items for which a limited proxy is required and given. A proxy may be made by any person entitled to vote, but shall only be valid for the specific meeting for which originally given and any lawful adjourned meetings thereof. In no event shall any proxy be valid for a period longer than 90 days after the date of the first meeting for which it was given. Every proxy shall be revocable at any time at the pleasure of the person executing it. A proxy must be in writing, signed by the person authorized to cast the vote for the Unit (as above described), name the person(s) voting by proxy and the person authorized to vote for such person(s) and filed with the Secretary before the appointed time of the meeting, or before the time to which the meeting is adjourned. Each proxy shall contain the date, time and place of the meeting for which it is given and, if a limited proxy, shall set forth the matters on which the proxy holder may vote and the manner in which the vote is to be cast. There shall be no limitation on the number of proxies which may be held by any person including a designee of the Developer. If a proxy expressly provides, any proxy holder may appoint, in writing, a substitute to act in its place.

- 3.8 **Adjourned Meetings.** If any proposed meeting cannot be organized because a quorum has not been attained, the members who are present, either in person or by proxy, may adjourn the meeting from time to time until a quorum is present, provided notice of the newly scheduled meeting is given in the manner required for the giving of notice of a meeting. Except as required above, proxies given for the adjourned meeting shall be valid for the newly scheduled meeting unless revoked for reasons other than the new date of the meeting.
- 3.9 **Order of Business.** If a quorum has been attained, the order of business at annual members' meetings, and, if applicable, at other members' meetings, shall be:
- (a) Call to order by President;
  - (b) Appointment by the President of a chairman of the meeting (who need not be a member or a director);
  - (c) Proof of notice of the meeting or waiver of notice;
  - (d) Appointment of inspectors of election;
  - (e) Tabulation of votes for Directors;
  - (f) Reading or waiver of reading of minutes;
  - (g) Reports of officers;
  - (h) Reports of committees;
  - (i) Unfinished business;
  - (j) New business;
  - (k) Adjournment.
- Such order may be waived in whole or in part by direction of the chairman.
- 3.10 **Minutes of Meeting.** The minutes of all meetings of Unit Owners shall be kept in a book available for inspection by Unit Owners or their authorized representatives and Board members at any reasonable time. The Association shall retain these minutes for the duration specified in the Condominium Act.
- 3.11 **Action Without A Meeting.** Anything to the contrary herein notwithstanding, to the extent lawful, any action required or which may be taken at any annual or special meeting of members, may be taken without a meeting, without prior notice and without a vote if a consent in writing, setting forth the action so taken, shall be signed by the members (or persons authorized to cast the vote of any such members as elsewhere herein set forth) having not less than the minimum number

of votes that would be necessary to authorize or take such action at a meeting of members at which all members (or authorized persons) entitled to vote thereon were present and voted. In order to be effective, the action must be evidenced by one or more written consents describing the action taken, dated and signed by approving members having the requisite number of votes and entitled to vote on such action, and delivered to the Secretary of the Association, or other authorized agent of the Association. Written consent shall not be effective to take the corporate action referred to in the consent unless signed by members having the requisite number of votes necessary to authorize the action within sixty (60) days of the date of the earliest dated consent and delivered to the Association as aforesaid. Any written consent may be revoked prior to the date the Association receives the required number of consents to authorize the proposed action. A revocation is not effective unless in writing and until received by the Secretary of the Association, or other authorized agent of the Association. Within ten (10) days after obtaining such authorization by written consent, notice must be given to members who have not consented in writing. The notice shall, fairly summarize the material features of the authorized action. A consent signed in accordance with the foregoing has the effect of a meeting vote and may be described as such in any document.

4. **Directors.**

- 4.1 **Membership.** The affairs of the Association shall be governed by a Board of not less than three (3) nor more than five (5) directors, the exact number to be determined in the first instance in the Articles, and, thereafter, except as provided herein, from time to time upon majority vote of the membership. Directors may not vote at Board meetings by proxy or by secret ballot, except that officers may be elected by secret ballot.
- 4.2 **Election of Directors.** Election of Directors shall be held at the annual members' meeting, except as herein provided to the contrary. Unless otherwise provided in the Condominium Act, not less than sixty (60) days prior to a scheduled election, the Association shall mail or deliver to each Unit Owner entitled to vote, a first notice of the date of election. Any Unit Owner or other eligible person desiring to be a candidate for the Board shall give written notice to the Association not less than forty (40) days prior to the scheduled election. Not less than fourteen (14) days before the election, the Association shall mail or deliver a second notice of the election meeting to all Unit Owners entitled to vote therein, together with an agenda and a ballot which shall list all candidates. The election of directors shall be by written ballot or voting machine. Elections shall be decided by a plurality of those ballots and votes cast. There shall be no quorum requirement, however at least 20 percent of the eligible voters must cast a ballot in order to have a valid election of members of the Board. There shall be no cumulative voting.

Notwithstanding the provisions of this Section 4.2, an election and balloting are not required unless more candidates file notices of intent to run than vacancies exist on the Board.

4.3 **Vacancies and Removal.**

- (a) Except as to vacancies resulting from removal of Directors by members, vacancies in the Board of Directors occurring between annual meetings of members shall be filled by the remaining Directors at any Board meeting, provided that all vacancies in directorships to which Directors were appointed by the Developer pursuant to the provisions of paragraph 4.13 hereof shall be filled by the Developer without the necessity of any meeting.
- (b) Any Director elected by the members (other than the Developer) may be removed by concurrence of a majority of the voting interests of the members at a special meeting of members called for that purpose or by written agreement signed by a majority of all voting interests. The vacancy in the Board of Directors so created shall be filled in accordance with the procedures specified in the Condominium Act.
- (c) Anything to the contrary herein notwithstanding, until a majority of the Directors are elected by members other than the Developer of the Condominium, neither the first Directors of the Association, nor any Directors replacing them, nor any Directors named by the Developer, shall be subject to removal by members other than the Developer. The first Directors and Directors replacing them may be removed and replaced by the Developer without the necessity of any meeting.
- (d) If a vacancy on the Board of Directors results in the inability to obtain a quorum of directors in accordance with these By-Laws, any Owner may apply to the Circuit Court within whose jurisdiction the Condominium lies for the appointment of a receiver to manage the affairs of the Association in accordance with the procedures specified in the Condominium Act.

4.4 **Term.** Except as provided herein to the contrary, the term of each Director's service shall extend until the next annual meeting of the members and subsequently until his successor is duly elected and has taken office, or until he is removed in the manner elsewhere provided. Notwithstanding the foregoing, any Director designated by the Developer shall serve at the pleasure of the Developer and may be removed and replaced by the Developer at any time.

4.5 **Organizational Meeting.** The organizational meeting of newly-elected or appointed Directors shall be held within ten (10) days of their election or appointment. The directors calling the organizational meeting shall give at least two (2) days advance notice thereof, stating the time and place of the meeting, and shall conspicuously post notice of the meeting for forty-eight (48) continuous hours preceding the meeting.

4.6 **Meetings.** Meetings of the Board of Directors may be held at such time and place as shall be determined, from time to time, by a majority of the Directors. Notice of meetings shall be given to each Director, personally or by mail, telephone or telegraph, and shall be transmitted at least three (3) days prior to the meeting.

Meetings of the Board of Directors and any Committee thereof at which a quorum of the members of that Committee are present shall be open to all Unit Owners.

The right to attend such meetings includes the right to speak at such meetings with respect to all designated agenda items. The Association may adopt reasonable rules governing the frequency, duration and manner of Unit Owner statements. Adequate notice of such meetings, which notice shall specifically incorporate and identification of agenda items, shall be posted conspicuously on the Condominium Property at least forty-eight (48) continuous hours preceding the meeting, except in the event of an emergency. Any item not included on the notice of meeting may be taken up on an emergency basis by at least a majority plus one of the members of the Board. Such emergency action shall be noticed and ratified at the next regular meeting of the Board. Notwithstanding the foregoing, written notice of any meeting of the Board at which non-emergency special assessments, or at which amendment to rules regarding unit use will be considered shall be mailed or delivered to all Unit Owners and posted conspicuously on the Condominium property not less than fourteen (14) days prior to the meeting. Evidence of compliance with this fourteen (14) day notice shall be made by an affidavit executed by the person providing the notice and filed among the official records of the Association. Special meetings of the Directors may be called by the President, and must be called by the President or Secretary at the written request of one third (1/3) of the Directors or where required by the Condominium Act.

- 4.7 **Waiver of Notice.** Any Director may waive notice of a meeting before or after the meeting and that waiver shall be deemed equivalent to the due receipt by said Director of notice. Attendance by any Director at a meeting shall constitute a waiver of notice of such meeting, and a waiver of any and all objections to the place of the meeting, to the time of the meeting or the manner in which it has been called or convened, except when a Director states at the beginning of the meeting, or promptly upon arrival at the meeting, any objection to the transaction of affairs because the meeting is not lawfully called or convened.
- 4.8 **Quorum.** A quorum at Directors' meetings shall consist of a majority of the entire Board of Directors. The acts approved by a majority of those present at a meeting at which a quorum is present shall constitute the acts of the Board of Directors, except when approval by a greater number of Directors is specifically required by the Declaration, the Article or these By-Laws.
- 4.9 **Adjourned Meetings.** If, at any proposed meeting of the Board of Directors, there is less than a quorum present, the majority of those present may adjourn the meeting from time to time until a quorum is present, provided notice of such newly scheduled meeting is given as required hereunder.
- 4.10 **Joinder In Meeting by Approval of Minutes.** The joinder of a Director in the action of a meeting by signing and concurring in the minutes of that meeting shall constitute the approval of that Director of the business conducted at the meeting, but such joinder shall not allow the applicable Director to be counted as being present for purposes of quorum.

- 4.11 **Presiding Officer.** The presiding officer at the Directors' meetings shall be the President (who may, however, designate any other Unit Owner to preside).
- 4.12 **Committees.** The Board may by resolution also create Committees and appoint persons to such Committees and vest in such Committees such powers and responsibilities as the Board shall deem advisable.
- 4.13 **Proviso.** Notwithstanding anything to the contrary contained in these By-Laws, the board shall consist of three directors during the period that the Developer is entitled to appoint a majority of the Directors, as hereinafter provided. The Developer shall have the right to appoint all of the members of the Board of Directors until Unit Owners other than the Developer own fifteen (15%) percent or more of the Units that will be operated ultimately by the Association. When Unit Owners other than the Developer own fifteen (15%) percent or more of the Units that will be operated ultimately by the Association, the Unit Owners other than the Developer shall be entitled to elect not less than one-third (1/3) of the members of the Board of Directors. Unit Owners other than the Developer are entitled to elect not less than a majority of the members of the Board of Directors (a) three years after fifty (50%) percent of the Units that will be operated ultimately by the Association have been conveyed to purchasers; (b) three months after ninety (90%) percent of the Units that will be operated ultimately by the Association have been conveyed to purchasers; (c) when all of the Unit that will be operated ultimately by the Association have been completed, some of them have been conveyed to purchasers, and none of the others are being offered for sale by the Developer in the ordinary course of business; (d) when some of the units have been conveyed to purchasers, and none of the others are being constructed or offered for sale by the Developer in the ordinary course of business, or (e) seven (7) years after recordation of the Declaration of Condominium in the public records, whichever occurs first. The Developer is entitled (but not obligated) to elect at least one (1) member of the Board of Directors as long as the Developer holds for sale in the ordinary course of business five percent (5%) of the Units that ultimately will be operated by the Association. Following the time the Developer relinquishes control of the Association, the Developer may exercise the right to vote any Developer-owned Units in the same manner as any other Unit Owners except for purposes of reacquiring control of the Association or selecting the majority members of the Board of Directors.

The Developer can turn over control of the Association to Unit Owners other than the Developer prior to such dates in its sole discretion by causing all of its appointed Directors to resign, whereupon it shall be the affirmative obligation of Unit Owners other than the Developer to elect Directors and assume control of the Association. Provided at least sixty (60) days' notice of Developer's decision to cause its appointees to resign is given to Unit Owners, neither the Developer, nor such appointees, shall be liable in any manner in connection with such resignations even if the Unit Owner other than the Developer refuse or fail to assume control.

Within seventy-five (75) days after the Unit Owners other than the Developer are entitled to elect a member or members of the Board of Directors, or sooner if the

Developer has elected to accelerate such event as aforesaid, the Association shall all, and give not less than sixty (60) days' notice of a meeting of the Unit Owners to elect such member or members of the Board of Directors. The meeting may be called and the notice given by the Unit Owners if the Association fails to do so.

At the time Unit Owners other than the Developer elect a majority of the members of the Board of Directors of the Association the Developer shall relinquish control of the Association and shall deliver to the Association all property of the Unit Owners and of the Association held or controlled by the Developer as specified in the Condominium Act. Not more than ninety (90) days after such event, Developer shall also deliver all financial records as required by the Condominium Act.

5. **Authority of the Board.**

5.1 **Powers and Duties.** The Board of Directors shall have the powers and duties necessary for the administration of the affairs of the Association and may take all acts, through the proper officers of the Association, in executing such powers, except such acts which by law, the Declaration, the Articles or these By-Laws may not be delegated to the Board of Directors by the Unit Owners. Such powers and duties of the Board of Directors shall include, without limitation (except as limited elsewhere herein), the following:

- (a) Operating and maintaining all Common Elements and the Association Property.
- (b) Determining the expenses required for the operation of the Association and the Condominium.
- (c) Employing and dismissing the personnel necessary for the maintenance and operation of the Common Elements and the Association Property.
- (d) Adopting and amending rules and regulations concerning the details of the operation and use of the Condominium and Association Property.
- (e) Maintaining bank accounts on behalf of the Association and designating the signatures required therefor.
- (f) Purchasing, leasing or otherwise acquiring title to, or an interest in, property in the name of the Association, or its designee, for the use and benefit of its members. The power to acquire personal property shall be exercised by the Board and the power to acquire real property shall be exercised as described herein and in the Declaration.
- (g) Purchasing, leasing or otherwise acquiring Units or other property, including, without limitation, Units at foreclosure or other judicial sales, all in the name of the Association, or its designee.

- (h) Selling, leasing, mortgaging or otherwise dealing with Units acquired, and subleasing Units leased, by the Association, or its designee.
- (i) Organizing corporations and appointing persons to act as designees of the Association in acquiring title to or leasing Units or other property.
- (j) Obtaining and reviewing insurance for the Condominium and Association Property.
- (k) Making repairs, additions and improvements to, or alterations of, Condominium Property and Association Property, and repairs to and restoration of Condominium and Association Property, in accordance with the provisions of the Declaration after damage or destruction by fire or other casualty, or as a result of condemnation or eminent domain proceedings or otherwise.
- (l) Enforcing obligations of the Unit Owners, allocating profits and expenses and taking such other actions as shall be deemed necessary and proper for the sound management of the Condominium.
- (m) Levying fines against appropriate Unit Owners for violations of the rules and regulations established by the Association to govern the conduct of such Unit Owners. No fine shall be levied except after giving reasonable notice and opportunity for a hearing to the affected Unit Owner and, if applicable, his tenant, licensee or invitee. No fine shall exceed the highest amount permitted by the Condominium Act from time to time.
- (n) Borrowing money on behalf of the Association or the Condominium when required in connection with the operation, care, upkeep and maintenance of Common Elements or the acquisition of real property, and granting mortgages on and/or security interests in Association owned property.
- (o) Contracting for the management and maintenance of the Condominium and Association Property and authorizing a management agent (who may be an affiliate of the Developer) to assist the Association in carrying out its powers and duties by performing such functions as the submission of proposals, collection of Assessments, preparation of records, enforcement of rules and maintenance, repair, and replacement of the Common Elements and Association Property with such funds as shall be made available by the Association for such purposes. The Association and its officers shall, however, retain at all times the powers and duties granted by the Declaration, the Articles, these By-Laws and the Act, including, but not limited to, the making of Assessments, promulgation of rules and execution of contracts on behalf of the Association.
- (p) At its discretion authorizing Unit Owners or other persons to use portions of the Common Elements or Association Property for private parties and gatherings and imposing reasonable charges for such private use.

- (q) Exercising (i) all powers specifically set forth in the Declaration, the Articles, these By-Laws and in the Act, (ii) all powers incidental thereto, and (iii) all other powers of a Florida corporation not-for-profit.
- (r) Contracting with and creating or joining in the creation of special taxing districts, joint councils and the like.
- (s) Responding to complaints of Unit Owners in accordance with all requirements of applicable law.

## 6. Officers.

- 6.1 **Executive Officers.** The executive officers of the Association shall be a President, a Vice President, a Treasurer and a Secretary (none of whom need be Directors), all of whom shall be elected by the Board of Directors and who may be peremptorily removed at any meeting by concurrence of a majority of all of the Directors. A person may hold more than one office, except that the President may not also be the Secretary. No person shall sign an instrument or perform an act in the capacity of more than one office. The Board of Directors from time to time shall elect such other officers and designate their powers and duties as the Board shall deem necessary or appropriate to manage the affairs of the Association. Officers, other than designees of the Developer, must be Unit Owners (or authorized representatives of corporate/partnership/trust Unit Owners).
- 6.2 **President.** The President shall be the chief executive officer of the Association. He shall have all of the powers and duties that are usually vested in the office of president of an association.
- 6.3 **Vice-President.** The Vice-President shall exercise the powers and perform the duties of the President in the absence or disability of the President. He also shall assist the President and exercise such other powers and perform such other duties as are incident to the office of the vice president of an Association and as may be required by the Directors or the President.
- 6.4 **Secretary.** The Secretary shall keep the minutes of all proceedings of the Directors and the members. The Secretary shall attend to the giving of all notices to the members and Directors and other notices required by law. The Secretary shall have custody of the seal of the Association and shall affix to instruments requiring the seal when duly signed. The Secretary shall keep the records of the Association, except those of the Treasurer, and perform all other duties incident to the office of the secretary of an association and as may be required by the Directors or the President.
- 6.5 **Treasurer.** The Treasurer shall have custody of all property of the Association, including funds, securities and evidences of indebtedness. The Treasurer shall keep books of account for the Association in accordance with good accounting practices, which, together with substantiating papers, shall be made available to the Board of Directors for examination at reasonable times. The Treasurer shall submit

a treasurer's report to the Board of Directors at reasonable intervals and shall perform all other duties incident to the office of treasurer and as may be required

by the Directors or the President. All monies and other valuable effects shall be kept for the benefit of the Association in such depositories as may be designated by a majority of the Board of Directors.

- 6.6 **Developer Appointees.** No officer appointed by the Developer may be removed except as provided in Section 4.13 hereof and by law.
7. **Compensation.** Neither Directors nor officers shall receive compensation for their services as such, but this provision shall not preclude the Board of Directors from employing a Director or officer as an employee of the Association, nor preclude contracting with a Director or officer for the provision of a service to the Association.
8. **Resignations.** Any Director or officer may resign his post at any time by written resignation, delivered to the President or Secretary, which shall take effect upon its receipt unless a later date is specified in the resignation, in which event the resignation shall be effective from such date unless withdrawn. The acceptance of a resignation shall not be required to make it effective. The conveyance of all Units owned by any Director or officer (other than appointees of the Developer or officers who are not required to be Unit Owners) shall constitute a written resignation of such Director or officer.
9. **Fiscal Management.** The provisions for fiscal management of the Association set forth in the Declaration and Articles shall be supplemented by the following provisions:
- 9.1 **Fiscal Year.** The fiscal year of the Association shall be the calendar year unless otherwise designated in the discretion of the Board of Directors.
- 9.2 **Budget.**
- (a) **Adoption by Board; Items.** The Board of Directors shall from time to time, and at least annually, prepare a budget for the Association (which shall detail all accounts and items of expense and contain at least all items required by the Condominium Act), determine the amount of Assessments payable by the Unit Owners to meet the expenses of the Association and allocate and assess such expenses against the Unit Owners in accordance with the provisions of the Declaration. In addition, if the Association maintains limited common elements with the cost to be shared only by those entitled to use the limited common elements, the budget or a schedule attached thereto shall show amounts budgeted therefor. In addition to annual operating expenses, the budget shall include reserve accounts for capital expenditures and deferred maintenance (to the extent required by law). Reserves shall not be required if the members of the Association have, by a majority vote at a duly called meeting of members, determined for a specific fiscal year to provide no reserves or reserves less adequate than required hereby. Prior to transfer of control of the Association to Unit Owners other than the Developer, the Developer may vote to waive reserves

for the first two (2) fiscal years of operation of the Association, after which time, reserves may only be waived or reduced upon the vote of a majority of non-Developer voting interests present at a duly called meeting of the Association. If a meeting of Unit Owners has been called to determine to provide no reserves or reserves less adequate than required, and such result is not attained or a quorum is not attained, the reserves, as included in the budget, shall go into effect.

The adoption of a budget for the Association shall comply with the requirements hereinafter set forth:

- (i) **Notice of Meeting.** A copy of the proposed budget of Common Expenses shall be mailed or hand delivered to each Unit Owner not less than fourteen (14) days prior to the meeting of the Board of Directors at which the budget will be considered, together with a notice of that meeting indicating the time and place of such meeting.
  - (ii) **Special Membership Meeting.** If a budget is adopted by the Board of Directors which requires Assessments against such Unit Owners in any year exceeding one hundred fifteen percent (115%) of such Assessments for the preceding year, as hereinafter defined, upon written application of ten percent (10%) of the Unit Owners, a special meeting of the Unit Owners shall be held within thirty (30) days of delivery of such application to the Board of Directors. Each Unit Owner shall be given at least ten (10) days' notice of said meeting. At the special meeting, Unit Owners shall consider and adopt a budget. The adoption of said budget shall require a vote of Owners of not less than 50% of all the Units (including Units owned by the Developer). If a meeting of the Unit Owners has been called as aforesaid and a quorum is not obtained or a substitute budget has not been adopted by the Unit Owners, the budget adopted by the Board of Directors shall go into effect as scheduled.
  - (iii) **Determination of Budget Amount.** In determining whether a budget requires Assessments against Unit Owners in any year exceeding one hundred fifteen percent (115%) of Assessments for the preceding year, there shall be excluded in the computations any authorized provisions for reasonable reserves made by the Board of Directors in respect of repair or replacement of the Condominium Property or in respect of anticipated expenses of the Association which are not anticipated to be incurred on a regular or annual basis, and there shall be excluded further from such computation Assessments for improvements to the Condominium Property.
- (b) **Adoption by Membership.** In the event that the Board of Directors shall be unable to adopt a budget for a fiscal year in accordance with the requirements of Section 9.2.(a) above, the Board of Directors may call a special meeting of Unit Owners for the purpose of considering and adopting such budget, which meeting shall be called and held in the manner provided

for such special meetings in said subsection, or propose a budget in writing to the members, and if such budget is adopted by the members, upon ratification by a majority of the Board of Directors, it shall become the budget for such year.

- 9.3 **Assessments.** Assessments against Unit Owners for their share of the items of the budget shall be made for the applicable fiscal year annually at least twenty (20) days preceding the year for which the Assessments are made. Such Assessments shall be due in equal installments, payable in advance on the first day of each month (or each quarter at the election of the Board) of the year for which the Assessments are made. If annual Assessments are not made as required, Assessments shall be presumed to have been made in the amount of the last prior Assessments, and monthly (or quarterly) installments on such Assessments shall be due upon each installment payment date until changed by amended Assessments. In the event the annual Assessments prove to be insufficient, the budget and Assessments may be amended at any time by the Board of Directors, subject to the provisions of Section 9.2 hereof, if applicable. Unpaid Assessments for the remaining portion of the fiscal year for which amended Assessments are made shall be payable in as many equal installments as there are full months (or quarters) of the fiscal year left as of the date of such amended Assessments, each such monthly (or quarterly) installment to be paid on the first day of the month (or quarter), commencing the first day of the next ensuing month (or quarter). If only a partial month (or quarter) remains, the amended Assessments shall be paid with the next regular installment in the following year, unless otherwise directed by the Board in its resolution.
- 9.4 **Special Assessments.** Special Assessments may be levied as provided in the Declaration and shall be paid in such manner as the Board of Directors of the Association may require in the notice of such Assessments. The funds collected pursuant to a Special Assessment shall be used only for the specific purpose or purposes set forth in the notice of adoption of same. However, upon completion of such specific purpose or purposes, any excess funds will be considered Common Surplus, and may, at the discretion of the Board, either be returned to the Unit Owners or applied as a credit towards future assessments.
- 9.5 **Depository.** The depository of the Association shall be such bank or banks in the State of Florida as shall be designated from time to time by the Directors and in which the monies of the Association shall be deposited. Withdrawal of monies from those accounts shall be made only by checks signed by such person or persons as are authorized by the Directors.
- 9.6 **Late Charges and Acceleration of Installments Upon Default.** Assessments and installments thereof not paid within ten (10) days from the date when they are due shall bear interest at the highest lawful rate from the date due until paid. In addition to the above stated interest, the Association may charge an administrative late fee in an amount not to exceed the highest amount provided for in the Condominium Act (as it may be amended from time to time) on Assessments and installments

thereof not paid when due. As an additional right and remedy of the Association, upon default in the payment of Assessments as aforesaid and after a claim of lien is filed and forty-five (45) days' prior written notice has been provided to the applicable Owner, the Association may declare the Assessment installments for the remainder of the budget year to be accelerated and such amount shall thereupon be immediately due and payable.

9.7 **Fidelity Bonds.** The association shall obtain and maintain adequate insurance or fidelity bonding of all persons who control or disburse funds of the association. The insurance policy or fidelity bond must cover the maximum of funds that will be in the custody of the association or its management agent at any one time. As used in this paragraph, the term "persons who control or disburse funds of the association" includes, but it is not limited to, those individuals authorized to sign checks and the president, secretary, and treasurer of the association. The association shall bear the cost of bonding.

9.8 **Accounting Records and Reports.** The Association shall maintain accounting records in the State, according to accounting practices normally used by similar associations. The records shall be open to inspection by Unit Owners or their authorized representatives at reasonable times and written summaries of them shall be supplied at least annually. The records shall include, but not be limited to: (a) a record of all receipts and expenditures, and (b) an account for each Unit designating the name and current mailing address of the Unit Owner, the amount of Assessments, the dates and amounts in which the Assessments come due, the amount paid upon the account and the dates so paid, and the balance due. Written summaries of the records described in clause (a) above, in the form and manner specified below, shall be supplied to each Unit Owner annually.

Within ninety (90) days following the end of the fiscal year, the Board shall mail, or furnish by personal delivery, to each Unit Owner either (a) a complete financial report of actual receipts and expenditures for the previous fiscal year; or (b) a complete set of financial statements for the preceding fiscal year prepared in accordance with generally accepted accounting principles, unless the Division adopts alternate standards, in which case such standards shall be followed; or (c) such other financial report as may be required by Section 718.111(13) of the Florida Statutes for the previous fiscal year. The report shall show the amount of receipts by accounts and receipt classifications and shall show the amount of expenses by accounts and expense classifications, including, if applicable, but not limited to, the following:

- (a) Costs for security;
- (b) Professional and management fees and expenses;
- (c) Taxes;
- (d) Costs for recreation facilities;

- (e) Expenses for refuse collection and utility services;
  - (f) Expenses for lawn care;
  - (g) Costs for building maintenance and repair;
  - (h) Insurance costs;
  - (i) Administrative and salary expenses; and
  - (j) Reserves for capital expenditures, deferred maintenance and any other category for which the Association maintains a reserve account or accounts.
- 9.9 **Application of Payment.** All payments made by a Unit Owner shall be applied as provided in these By-Laws and in the Declaration or as otherwise determined by the Board.
- 9.10 **Notice of Meetings.** Notice of any meeting where Assessments against Unit Owners are to be considered for any reason shall specifically contain a statement that Assessments will be considered and the nature of any such Assessments.
10. **Roster of Unit Owners.** Each Unit Owner shall file with the Association a copy of the deed or other document showing his ownership. The Association shall maintain such information. The Association may rely upon the accuracy of such information for all purposes until notified in writing of changes therein as provided above. Only Unit Owners of record on the date notice of any meeting requiring their vote is given shall be entitled to notice of and to vote at such meeting, unless prior to such meeting other Owners shall produce adequate evidence, as provided above of their interest and shall waive in writing notice of such meeting.
11. **Parliamentary Rules.** Except when specifically or impliedly waived by the chairman of a meeting (either of members or directors), Robert's Rules of Order (latest edition) shall govern the conduct of the Association meetings when not in conflict with the Condominium Act, the Declaration, the Articles or these By-Laws; provided, however, that a strict or technical reading of said Robert's Rules shall not be made so as to frustrate the will of the persons properly participating in said meeting.
12. **Amendments.** Except as may be provided in the Declaration to the contrary, these By-Laws may be amended in the following manner:
- 12.1 **Notice.** Notice of the subject matter of a proposed amendment shall be included in the notice of a meeting at which a proposed amendment is to be considered.
  - 12.2 **Adoption.** A resolution for the adoption of a proposed amendment may be proposed either by a majority of the Board of Directors or by not less than one-third (1 /3) of the members of the Association. Directors and members not present in person or by proxy at the meeting considering the amendment may express their approval in writing, provided that such approval is delivered to the Secretary at or

prior to the meeting. The approval must be by not less than a majority of the votes of all members of the Association represented at a meeting at which a quorum has been attained.

- 12.3 **Proviso.** No amendment may be adopted which would eliminate, modify, prejudice, abridge or otherwise adversely affect any rights, benefits, privileges or priorities granted or reserved to the Developer or mortgagees of Units without the consent of said Developer and mortgagees in each instance. No amendment shall be made that is in conflict with the Articles or Declaration. No amendment to this Section shall be valid.
- 12.4 **Execution and Recording.** A copy of each amendment shall be attached to a certificate certifying that the amendment was duly adopted as an amendment of these By-Laws, which certificate shall be executed by the President or Vice-President and attested by the Secretary or Assistant Secretary of the Association with the formalities of a deed, or by the Developer alone if the amendment has been adopted consistent with the provisions of the Declaration allowing such action by the Developer. The amendment shall be effective when the certificate and a copy of the amendment is recorded in the Public Records of this County with an identification on the first page of the amendment of the Records Book and Page of said Public Records where the Declaration is recorded.
13. **Official Records.** The official records of the Association shall be maintained in the Association's office or such other location within the state as designated by the Board of Directors. The official records of the Association shall be open to inspection by any Association member or the authorized representative of such member at all reasonable times in accordance with the requirements of the Condominium Act. The right to inspect the records includes the right to make or obtain copies, at a reasonable expense, if any, of the Association member. The Association may adopt reasonable rules regarding the time, location, notice and manner of record inspections and copying.
14. **Disputes.** Without limiting any other remedies which may be available in law or equity, those disputes which are governed by mandatory non-binding arbitration proceedings as specified in Section 718.1255, Florida Statutes shall be governed by the procedures set forth therein.
15. **Construction.** Wherever the context so permits, the singular shall include the plural, the plural shall include the singular, and the use of any gender shall be deemed to include all genders.
16. **Captions.** The captions herein are inserted only as a matter of convenience and for reference and in no way define or limit the scope of these By-Laws or the intent of any provision hereof.

20512PG1190

The foregoing was adopted as the By-Laws of Century Park Condominium No.2 Association, Inc., a corporation not for profit under the laws of the State of Florida, as of the 2<sup>nd</sup> day of July, 2002.

Approved:

GEORGE E. LUND, UCS PRESIDENT

RECORDED IN OFFICIAL RECORDS BOOK  
OF DADE COUNTY, FLORIDA  
RECORD VERIFIED  
HARVEY RUVIN  
CLERK CIRCUIT COURT

CLERK NOTE  
FOR CONDOMINIUM PLNS SEE OFFICIAL  
RECORDS CONDOMINIUM PLANS BK. 360 PAGE 2

HARVEY RUVIN, CLERK,  
CIRCUIT & COUNTY COURTS

  
Harvey Ruvin D.G.

H:\LIBRARY\CASES\W074\2020183\HV8217.WPD